
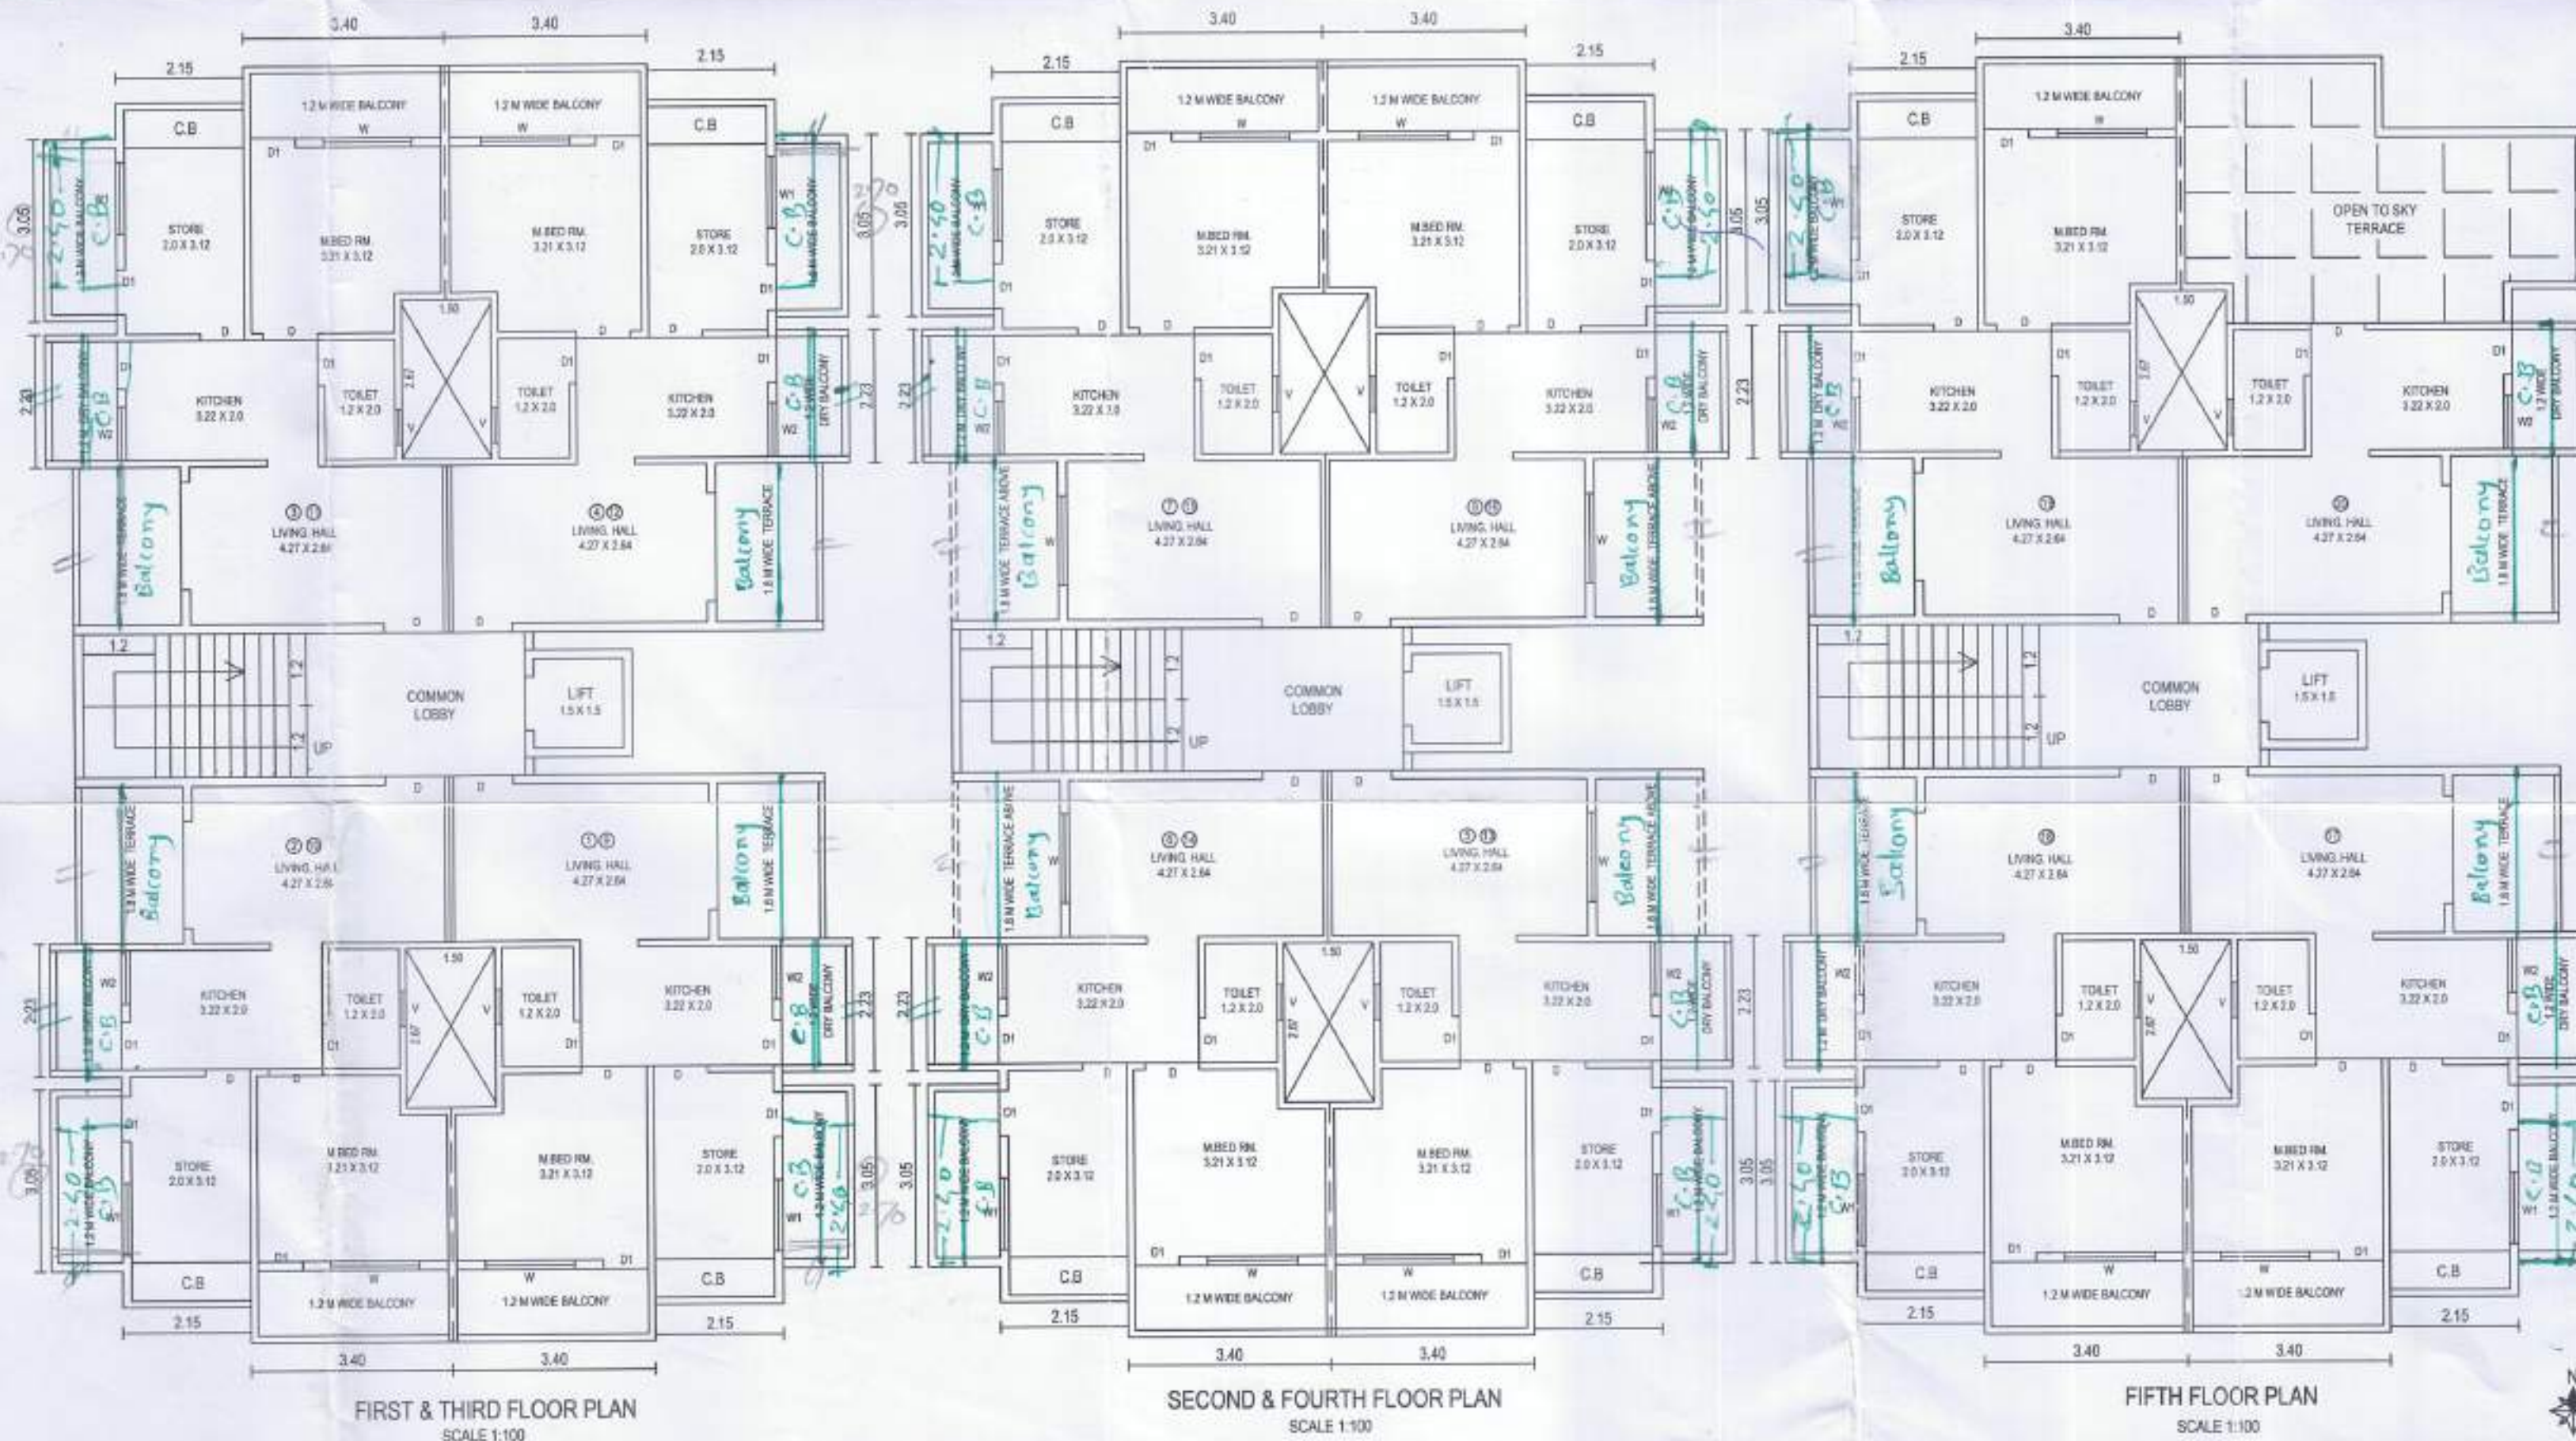
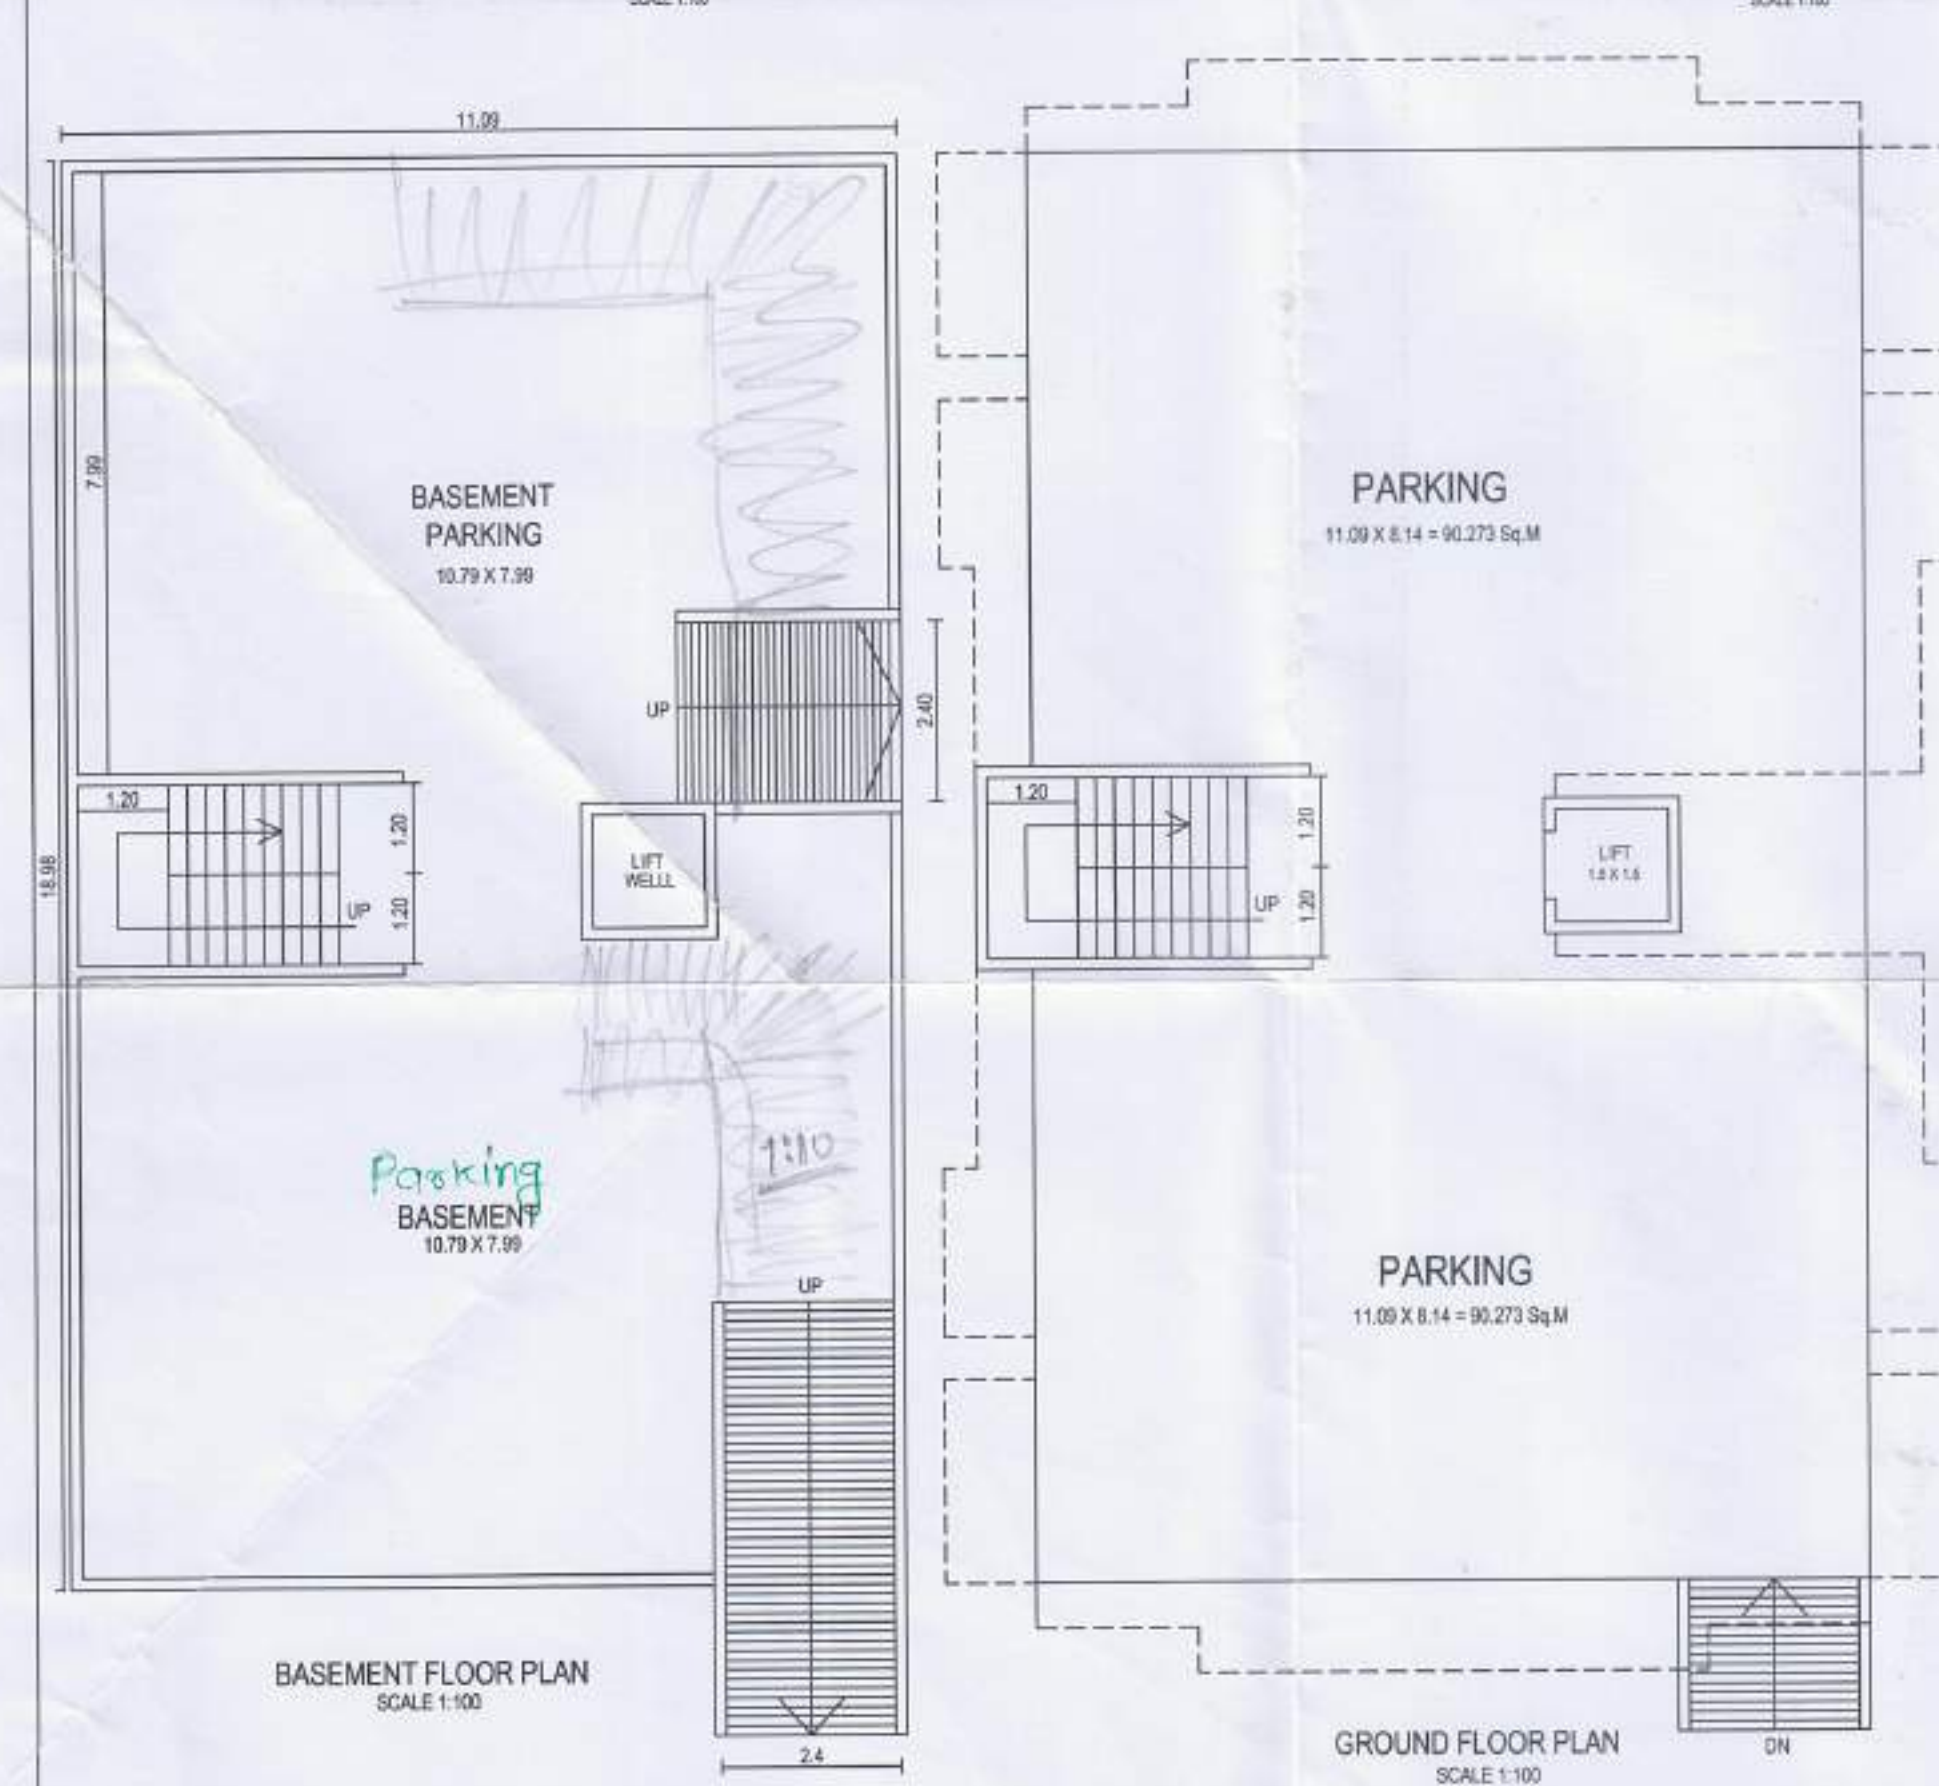
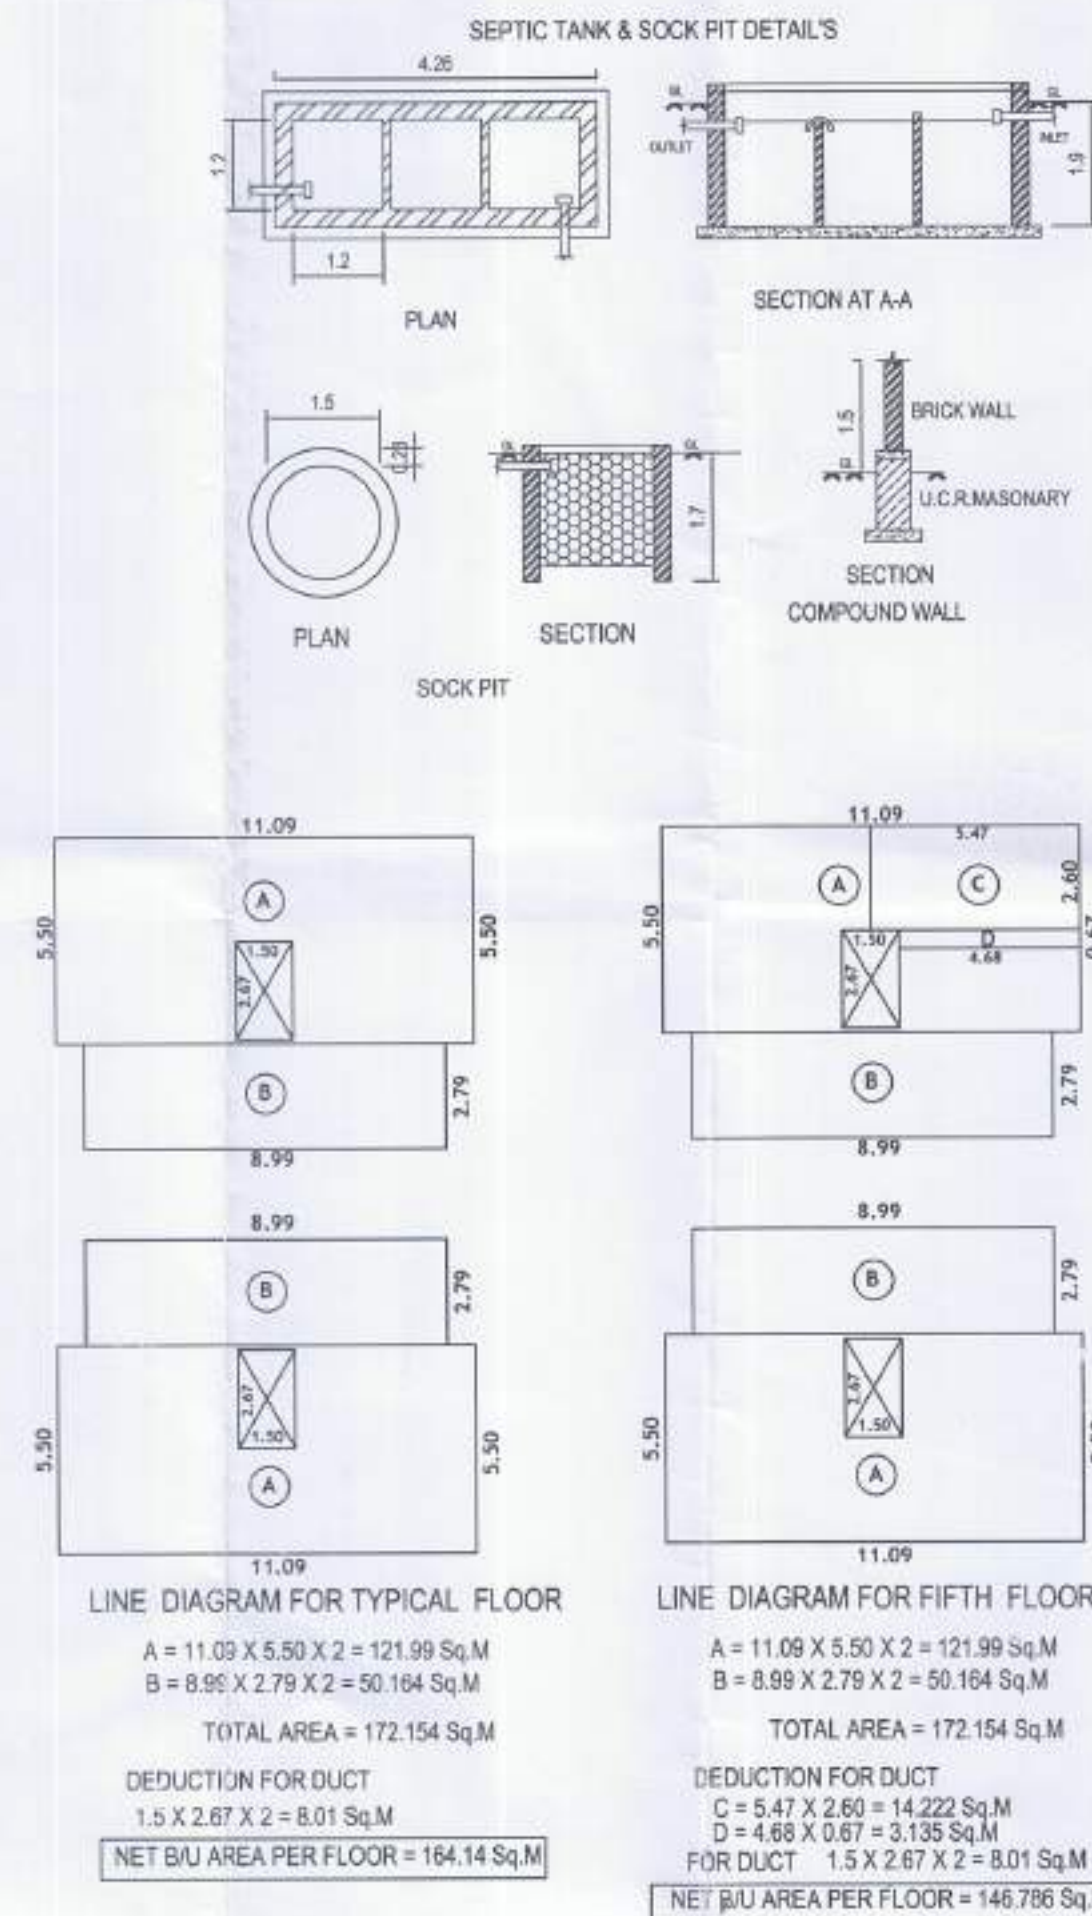
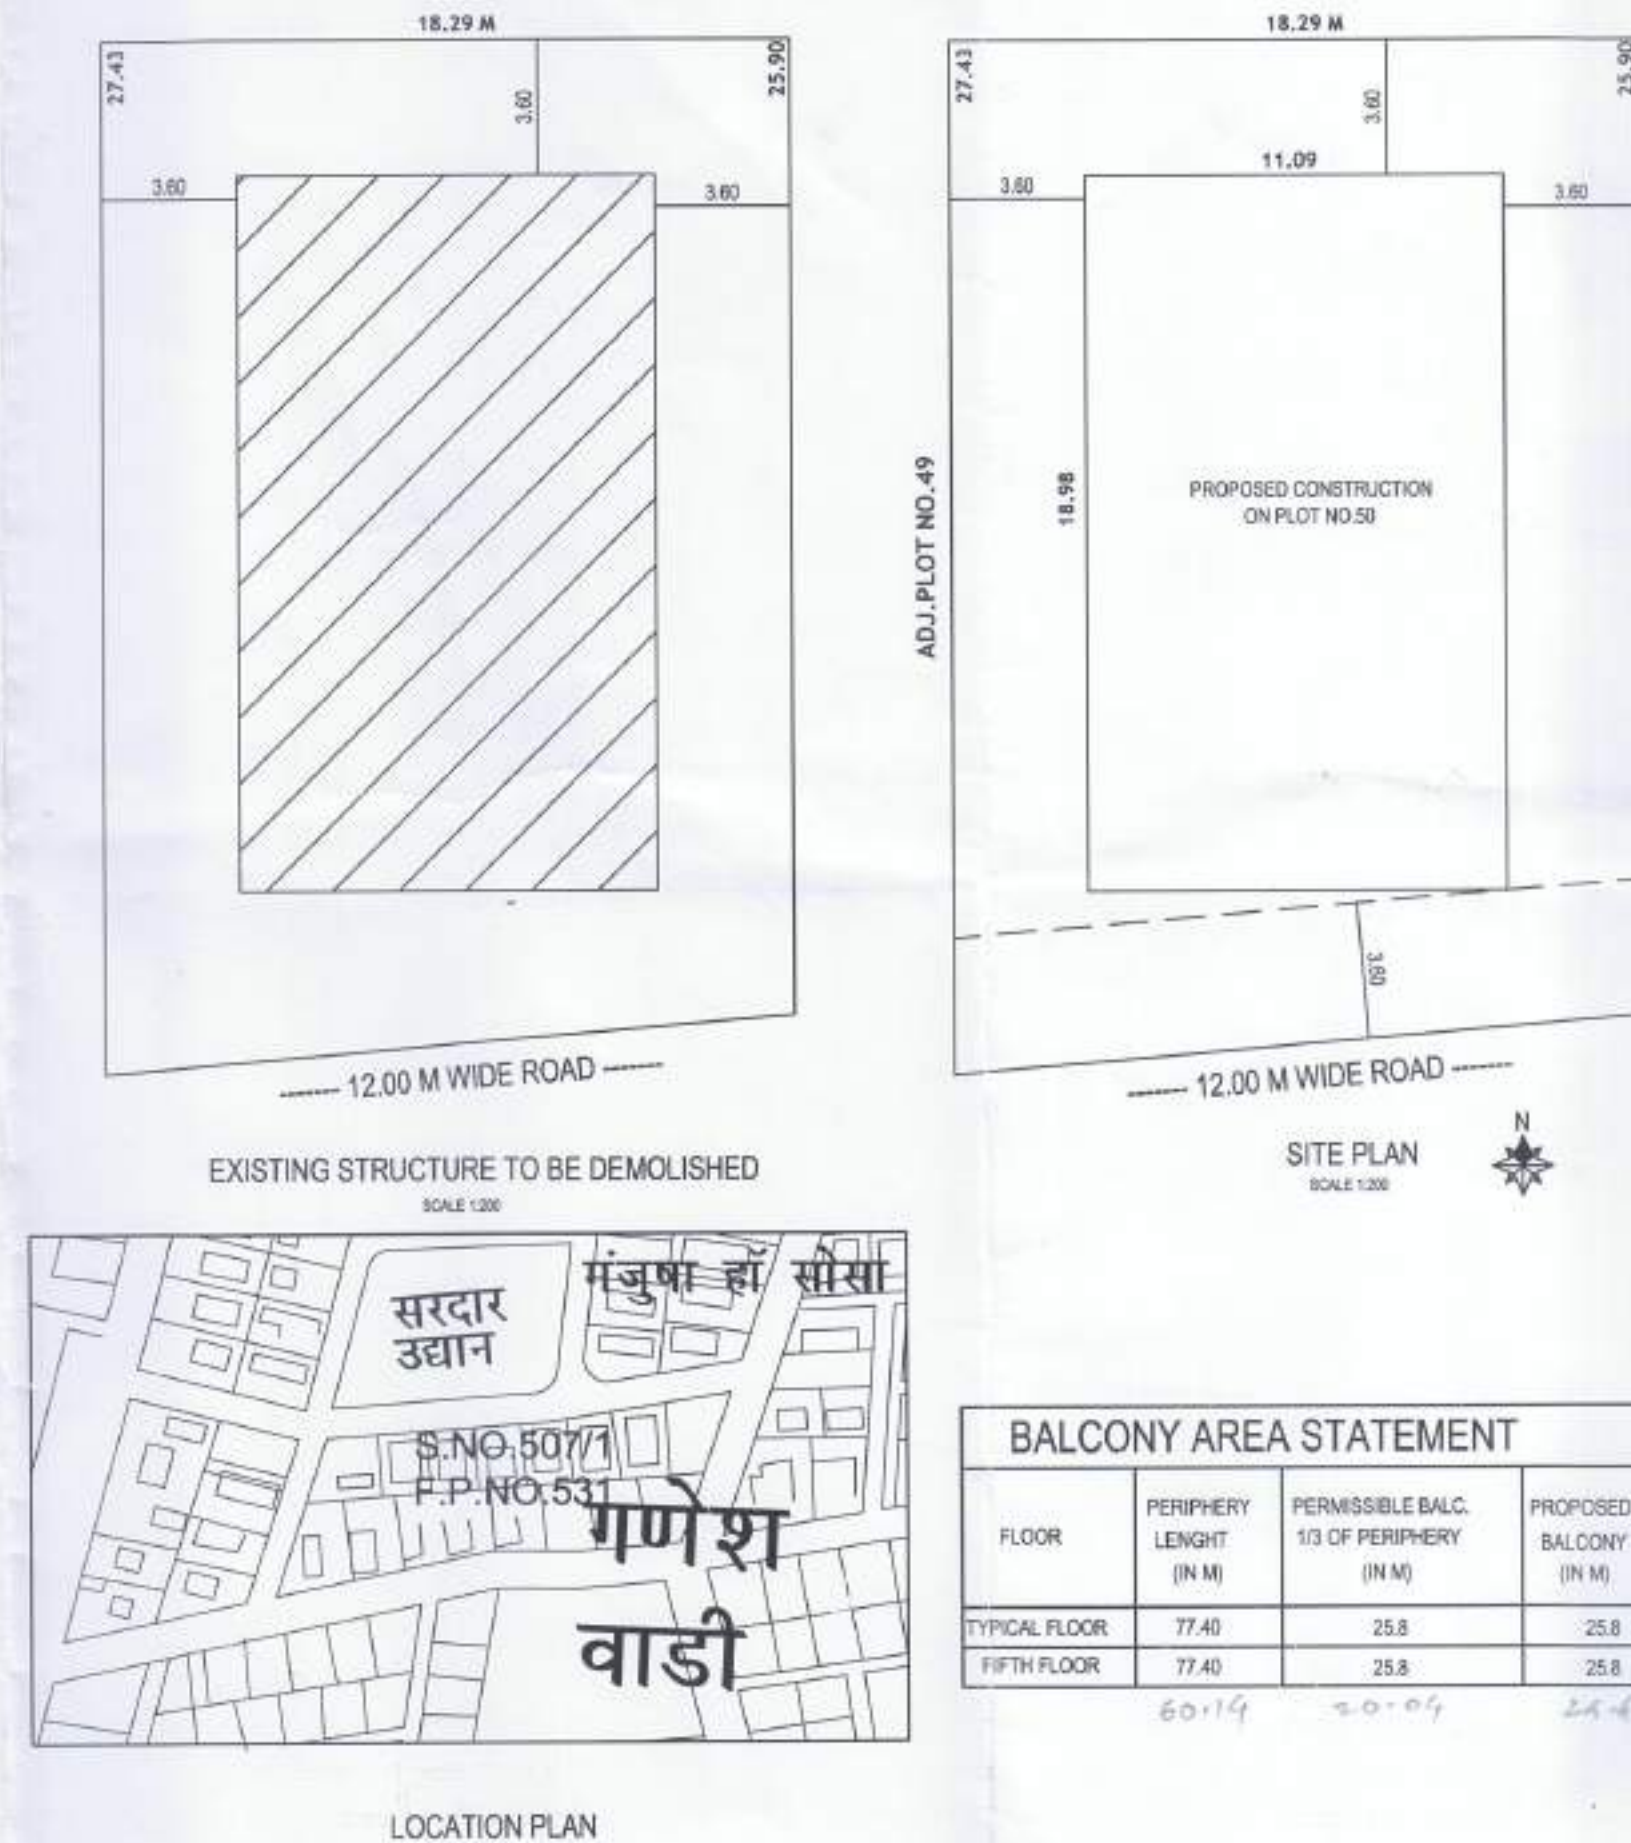


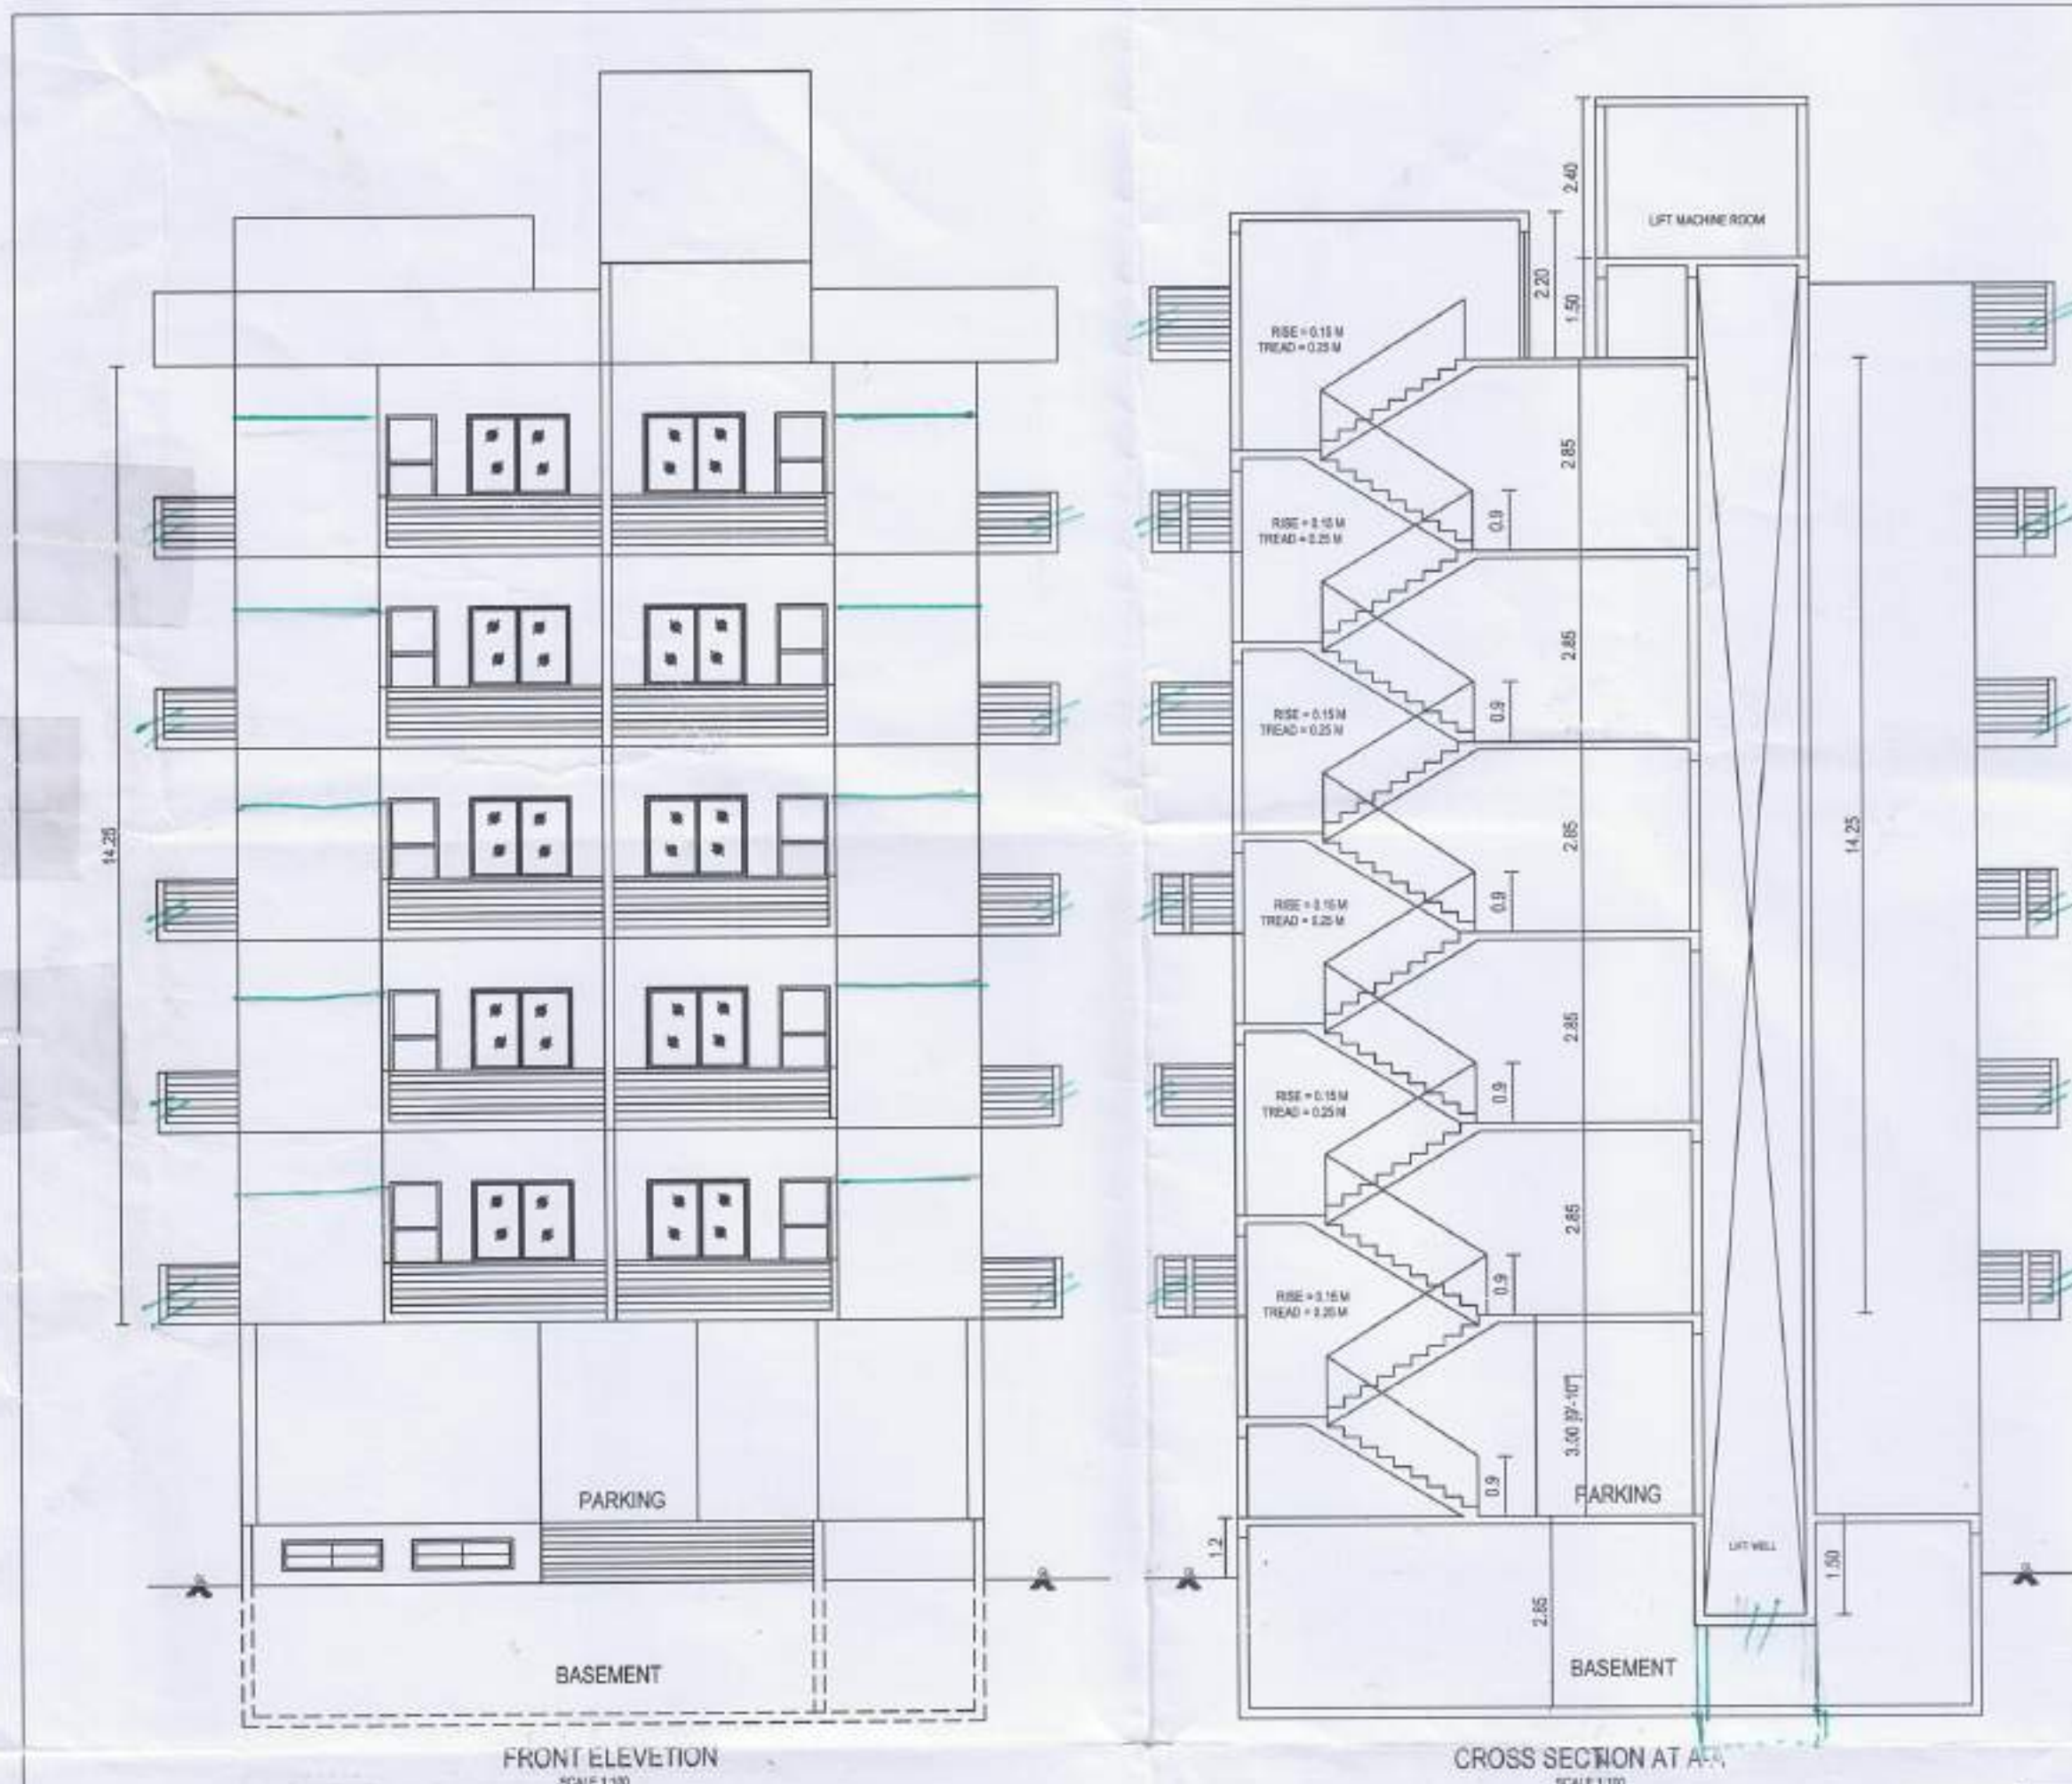

PROJECT
PROPOSED CONSTRUCTION OF RESIDENTIAL BUILDING ON FINAL PLOT NO. 531, S.NO. 177(P) T.P.S-II, TAL & DIST - JALGAON FOR Mr. MEGHSHYAM B. PATIL

APPROVAL

APPROVED
For Residential purpose as per the provisions of the Jalgaon Municipal Corporation Act, 1947. Date: 29/12/2016. 1169. Municipal Corporation of the City of Jalgaon.

PARKING AREA STATEMENT
(AS PER D.C. RULE - TABLE NO. 8 PAGE NO. 55)

FOR EVERY 2 TENEMENTS HAVING AREA 50 Sq.M OR MORE	4 WHEELER	2 WHEELER
PARKING REQUIRED	10 NOS	20 NOS
PARKING PROVIDED	20 NOS	20 NOS

AREA STATEMENT

PLOT NO	SQM.
1. TOTAL PLOT AREA	531
2. APPLICANT PLOT AREA	487.70
3. ADD. TDR 65% (CERT NO. DATE)	317.00
4. TOTAL PERMISSIBLE BUILT UP AREA	804.70
5. PROPOSED FIRST FLOOR B/U AREA	164.14
6. PROPOSED SECOND FLOOR B/U AREA	164.14
7. PROPOSED THIRD FLOOR B/U AREA	164.14
8. PROPOSED FOURTH FLOOR B/U AREA	164.14
9. PROPOSED FIFTH FLOOR B/U AREA	164.14
10. TOTAL BUILT UP AREA PROPOSED	804.70
11. F.S.I. CONSUMED	1.645

NOTES - ALL DIMENSIONS ARE IN METER
PLOT BOUNDARY SHOWN IN BLACK
PROPOSED WORK SHOWN IN RED
DRAINAGE WORK SHOWN IN RED DOTTED
EXTERNAL WALL = 0.15 INTERNAL WALL = 0.115

DOOR AND WINDOWS SCHEDULE

D	T.W. DOOR	W	ALUMINIUM WINDOW
D1 1.2 X 2.10	T.W. DOOR	W1 1.50 X 1.30	ALUMINIUM WINDOW
D2 0.9 X 2.10	T.W. DOOR	W2 1.20 X 1.20	ALUMINIUM WINDOW
D3 0.75 X 2.10	FLUSH DOOR	W3 0.60 X 0.75	LOUVERED VENTILATOR

ANAND A. MUKUND
B.E. CIVIL
Reg. No. 0070
15, 2nd Floor Above Andhra Bank Ring Road, Jalgaon-425002
P: 0257-2734698
ENGINEER'S SIGNATURE

ANAND A. MUKUND
Structural Engineer, R.No. 0026
Jalgaon Municipal Corporation
15, 2nd Floor Above Andhra Bank Ring Road, Jalgaon-425002
P: 0257-2734698
ENGINEER'S SIGNATURE

OWNER'S SIGN.
Mr. Meghshyam B. Patil

ANAND A. MUKUND
PLANNER & STRUCTURAL CONSULTANTS
Office 15, 2nd Floor Above Andhra Bank Ring Road, Jalgaon-02.
Cont: +91 9326299499 E-mail: anamukund1989@gmail.com.

Job: No. - 48/15
PC-1-DATA(d)DRAW. TE.

Drawn by: Anand
Rev Date:

Date: 19/07/16