



REVISED PLAN SHOWING M.I.G. SCHEME ( DETACHED ) IN S.NO 300/1 AT SAKEGAON TAL- BHUSAWAL, DIST- JALGAON.

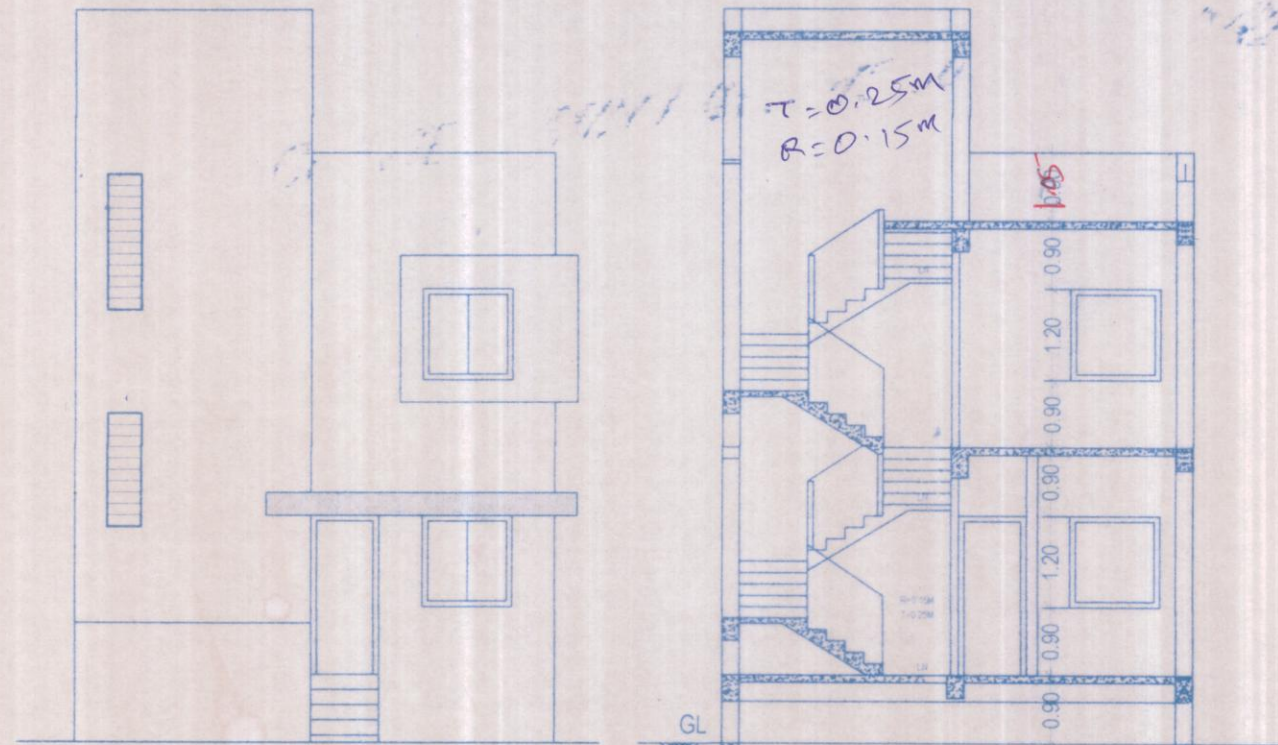

ELEVATION

SECTION AT=A-A1

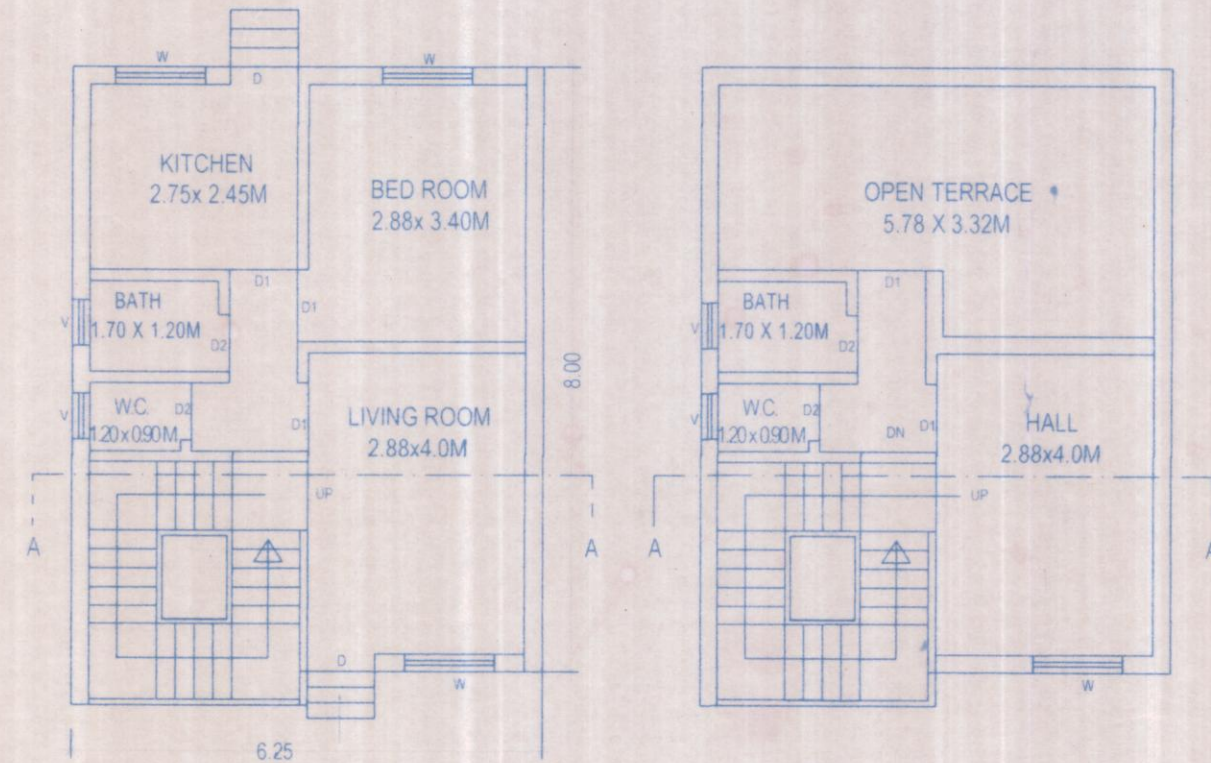

GROUND FLOOR PLAN (DETACHED)


SCALE - 1:100

FIRST FLOOR PLAN


AREA STATEMENT

| PLOT NO | PLOT AREA IN SQ.M | G.F B/UP IN SQ.M         | F.F B/UP IN SQ.M          | TOTAL B/P G.F+F.F IN SQ.M | F.S.I % | CARPET AREA OF G.F IN SQ.M | CARPET AREA OF F.F IN SQ.M | TOTAL CARPET AREA OF G.F+ F.F IN SQ.M |
|---------|-------------------|--------------------------|---------------------------|---------------------------|---------|----------------------------|----------------------------|---------------------------------------|
| 19      | 125.0             | <del>50.0</del><br>54.86 | <del>29.48</del><br>32.52 | 0.63<br>86.60             | 0.63%   | 40.91                      | 24.39                      | 65.30                                 |

B/UP AREA CALCULATION

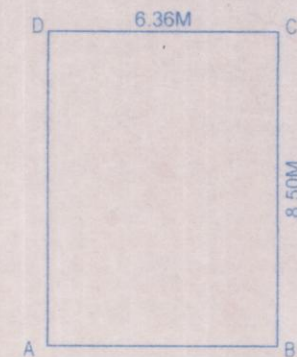

PROPOSED GROUND FLOOR (DETACHED)  
A,B,C,D= 6.36X8.50M = 54.06 SQ.M

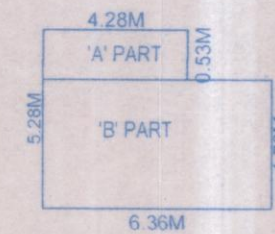

PROPOSED FIRST FLOOR (TWIN)  
'A' PART= 4.28X0.53M = 2.26 SQ.M  
'B' PART= 6.36X4.76M = 30.27 SQ.M  
TOTAL = 32.53 SQ.M

NET B/UP AREA = G.F+F.F.  
54.06 + 32.53 = 86.59 SQ.M

SCHEDULE OF OPENINGS

D = 0.90 X 2.10M  
D1= 0.75 X 2.10M  
GL= 0.90 X 4.49M  
W = 1.20 X 1.20M  
W1= 1.50 X 1.05M  
V = 0.60 X 0.75M

DWG NO= 03 (TYPE= B)

*[Signature]*  
Building Inspector  
Municipal Council, Bhusawal

*[Signature]*  
TOWN PLANNER  
Bhusawal Municipal Council  
BHUSAWAL



Approved Subject to the condition  
mentioned in the Accompanying  
Permission Dated: 28-11-14

*[Signature]*  
Chief Officer  
Bhusawal Municipal Council Bhusawal

*[Signature]*  
Executive Engineer,  
Mukta Housing & Area Devp. Board,  
Division - DHULE.

*[Signature]*  
CHETAN V. SONAR, B. ARCH.  
ARCHITECT & ENGINEER'S  
LIC. NO. CA/87/11097  
"MUKTAI" DHULE ROAD, AMALNER,  
DIST. JALGAON. PH. NO. - 222419  
CELL NO. - 9422278419

**VASTU CHAITANYA**  
CHETAN V SONAR, B.Arch.  
ARCHITECT & INTERIOR DESIGNER  
"MUKTAI" DHULE ROAD, AMALNER.  
DIST= JALGAON. MO = 9422278419