
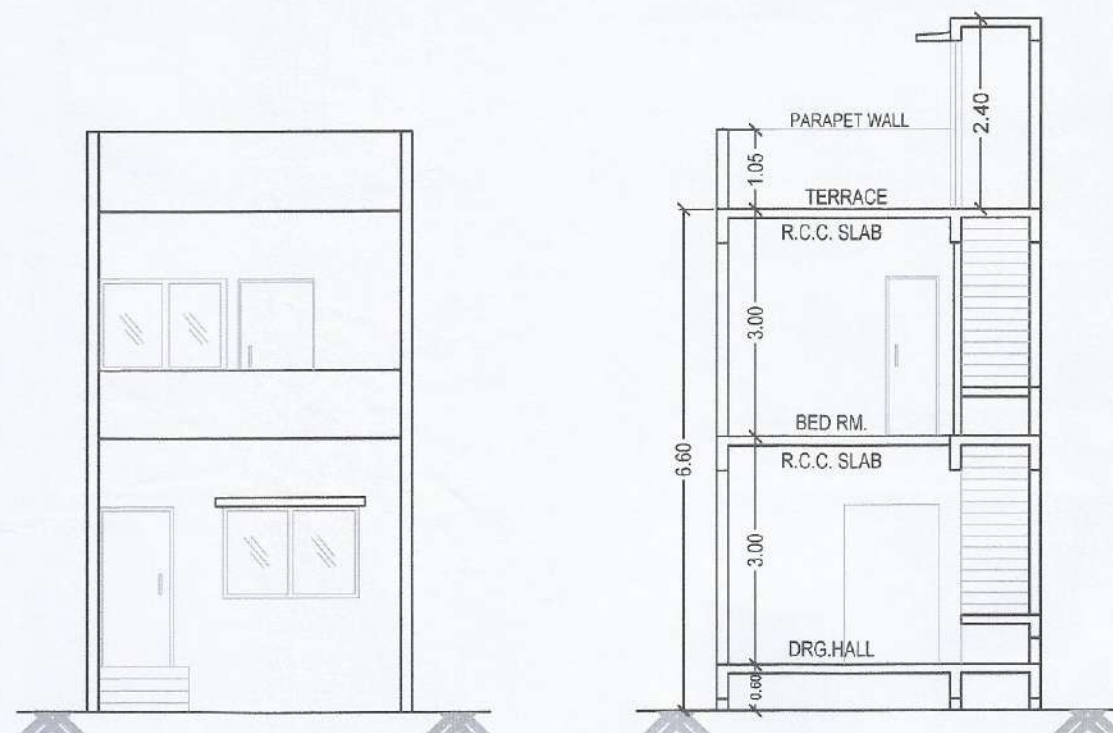
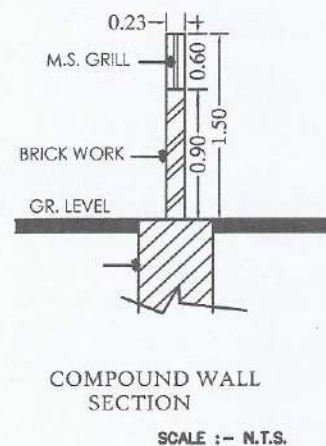
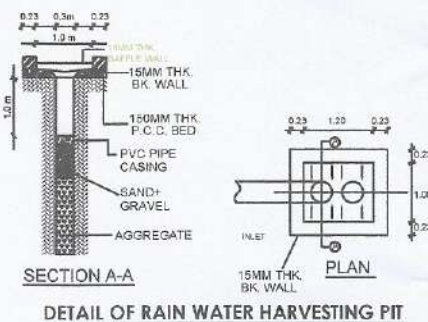


Approved as amended in red, subject of Conditions mentioned in this Office Letter No. 162 dated 19.7.2023

Revised Building Permission

Senior Planner (New Towns)
CIDCO, Aurangabad Fringe Area

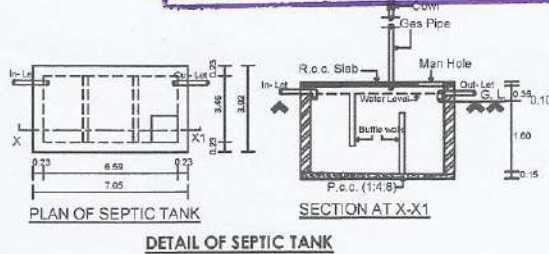


ELEVATION
SCALE 1:100

SECTION A-A'
SCALE 1:100


BLOCK PLAN & P-LINE AREA CAL. FOR
FIRST FLOOR SCALE 1:200

AREA CAL.
OVER ALL DIM. = 4.15 X 8.00 = 33.20 SQ.MT.

NET B/UP AREA = 33.20 SQ.MT.

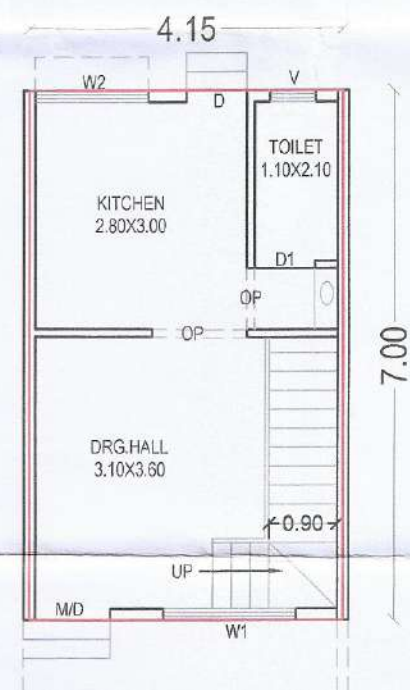

GROUND FLOOR PLAN
SCALE 1:100

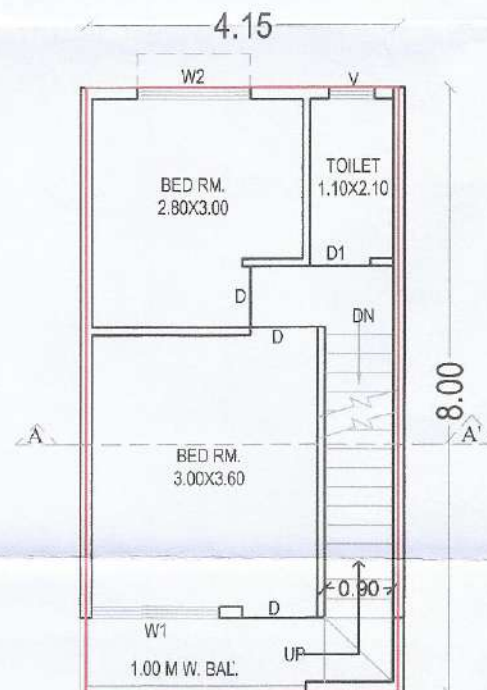

FIRST FLOOR PLAN
SCALE 1:100

BLOCK PLAN & P-LINE AREA CAL. FOR
GROUND FLOOR SCALE 1:200

AREA CAL.
OVER ALL DIM. = 4.15 X 7.00 = 29.05 SQ.MT.

NET B/UP AREA = 29.05 SQ.MT.

FOR OFFICE USE ONLY

02/04

AREA STATEMENT FOR "A-TYPE" TENEMENT UNIT

1. GROUND FLOOR AREA ----- = 29.05 SQ.MT.
2. FIRST FLOOR AREA ----- = 33.20 SQ.MT.
3. TOTAL PROPOSED B/UP AREA --- = 62.25 SQ.MT.
4. TOTAL B/UP AREA (62.25X158nos.)-- = 9835.50 SQ.MT.

SCHEDULE OF OPENINGS

MD/D	- 1.00 X 2.10	T.W. PANNELED
D1	- 1.00 X 2.10	T.W. PANNELED
D2	- 0.83 X 2.10	CONCRETE FRAME & FLUSH DOOR
FD	- 2.40 X 2.10	T.W. PANNELED
W	- 1.80 X 1.20	ALUMINIUM SLIDING
W1	- 1.50 X 1.08	ALUMINIUM SLIDING
W2	- 1.20 X 1.20	ALUMINIUM SLIDING
W3	- 0.90 X 1.20	ALUMINIUM SLIDING
W4	- 0.60 X 1.20	ALUMINIUM SLIDING
W5	- 0.35 X 1.20	ALUMINIUM SLIDING
V	- 0.60 X 0.60	M.S. LOUVERED

NOTES

1. THE STRUCTURE DONE IS R.C.C. FRAME STRUCTURE.
2. THE DEPTH OF FOUNDATION IS UPTO HARD STRATA.
3. THE WALL CONSTRUCTION IS IN BRICK MASONARY.
4. STAIRCASE PROVIDED IS NON SLIPPERY.
5. DADO IS PROVIDED UP TO 2.1 M HEIGHT IN BATH AND W.C.

LEGEND

1. PLOT BOUNDARY SHOWN IN BLACK.
2. PROPOSED CONSTRUCTION SHOWN IN RED.
3. SEWER LINE SHOWN IN RED DOTTED.
4. WATER SUPPLY LINE SHOWN IN BLACK DOTTED THIN.

REVISED BUILDING PLAN FOR GROUP HOUSING
SCHEME FOR LIG & ECONOMICAL WEAKER SECTION
ON GUT NO.-31, SITUATED AT SAWANGI TQ. & DIST.-
AURANGABAD.

FOR - M/S- JAYESH INFRA THROUGH ITS PARTNER'S.

- 01) Mr. IMTIYAZ KHAN S/O SARDAR KHAN. 02) Mr. SANDEEP S/O DAULATRAO BORSE.
03) Mr. ABHIJEET S/O BHASKARRAO DESHMUKH 04) Mr. AMIT S/O LAXMANRAO BHOSALE.
05) Mr. MAHENDRA S/O RAMESHCHAND METHI. 06) Mr. PANKAJ S/O PANJABRAO CHAVAN.
07) Mr. SATISH S/O LIMBAJI METE. 08) Mr. SUBHASH S/O BABURAO PALASKAR.
09) Mr. BABASAHEB S/O RAGHUNATH SABLE. 10) Mr. ANIL S/O DAULATRAO BORSE.

OWNERS SIGN

ARCHITECTS SIGN

[Signature]

[Signature]
ARCHITECT
Mr. Dhananjay B. Doifode
(B.Arch, M.Arch)
CA/2013/60839
"Ganraj" P.No.3 & 4, Gajanan Colony, Aurangabad

SUBMISSION DRAWING

SCALE 1:100

DRAWN BY - D.D.

DT - 05.06.2023

DRWG. NO. 02/04

PLAN FOR A-TYPE TENEMENTS