



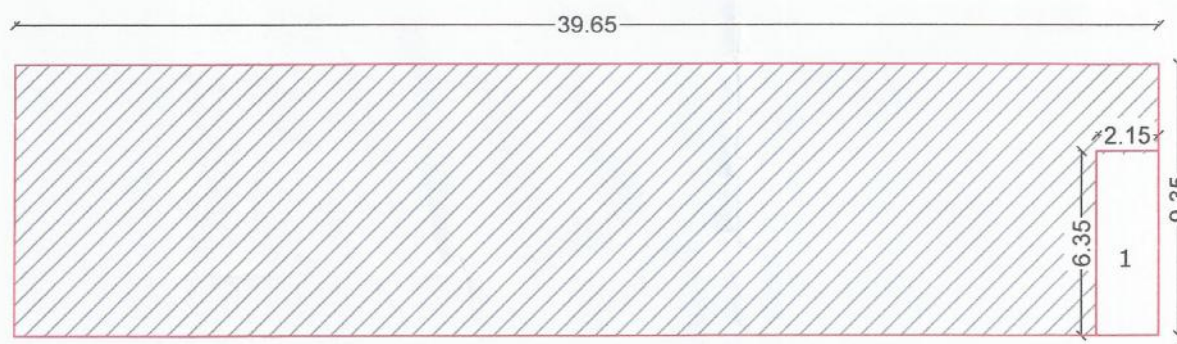

BLOCK PLAN & P-LINE AREA CAL. FOR GROUND FLOOR
SCALE 1:200

AREA CAL.
OVER ALL DIM. = 39.65 X 10.35 = 370.73 SQ.MT.
DEDUCT 1] = 2.15 X 6.35 = 13.65
TOTAL DEDUCTION = 13.65 SQ.MT.

NET B/U AREA = 370.73 - 13.65 = 357.08 SQ.MT.

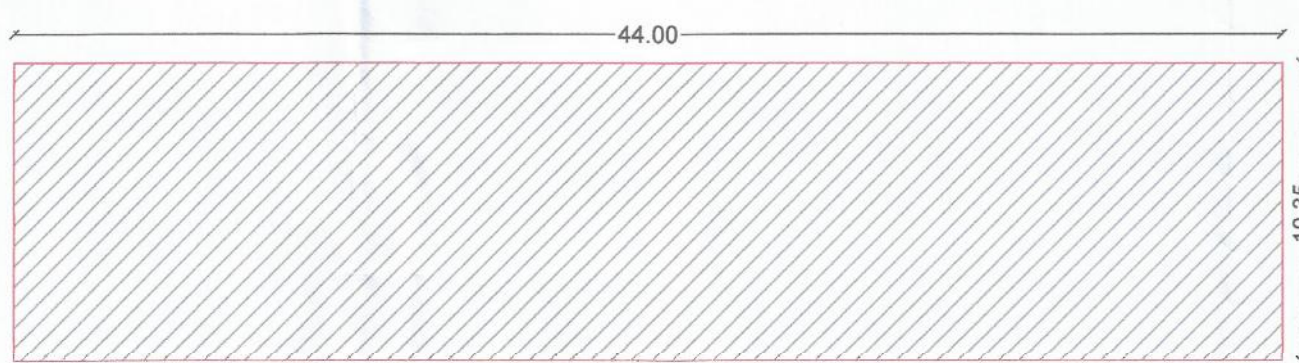


P-LINE AREA CAL. FOR FIRST FLOOR
SCALE 1:200


AREA CAL.
OVER ALL DIM. = 44.00 X 10.35 = 455.40 SQ.MT.

NET B/U AREA = 455.40 SQ.MT.


Approved as amended in red, subject to
Conditions mentioned in this Office Letter
No. 374 date 22/11/2024
Revised Building Permission
Senior Planner (New Towns)
CIDCO, Chh. Sambhajinagar Fringe Area

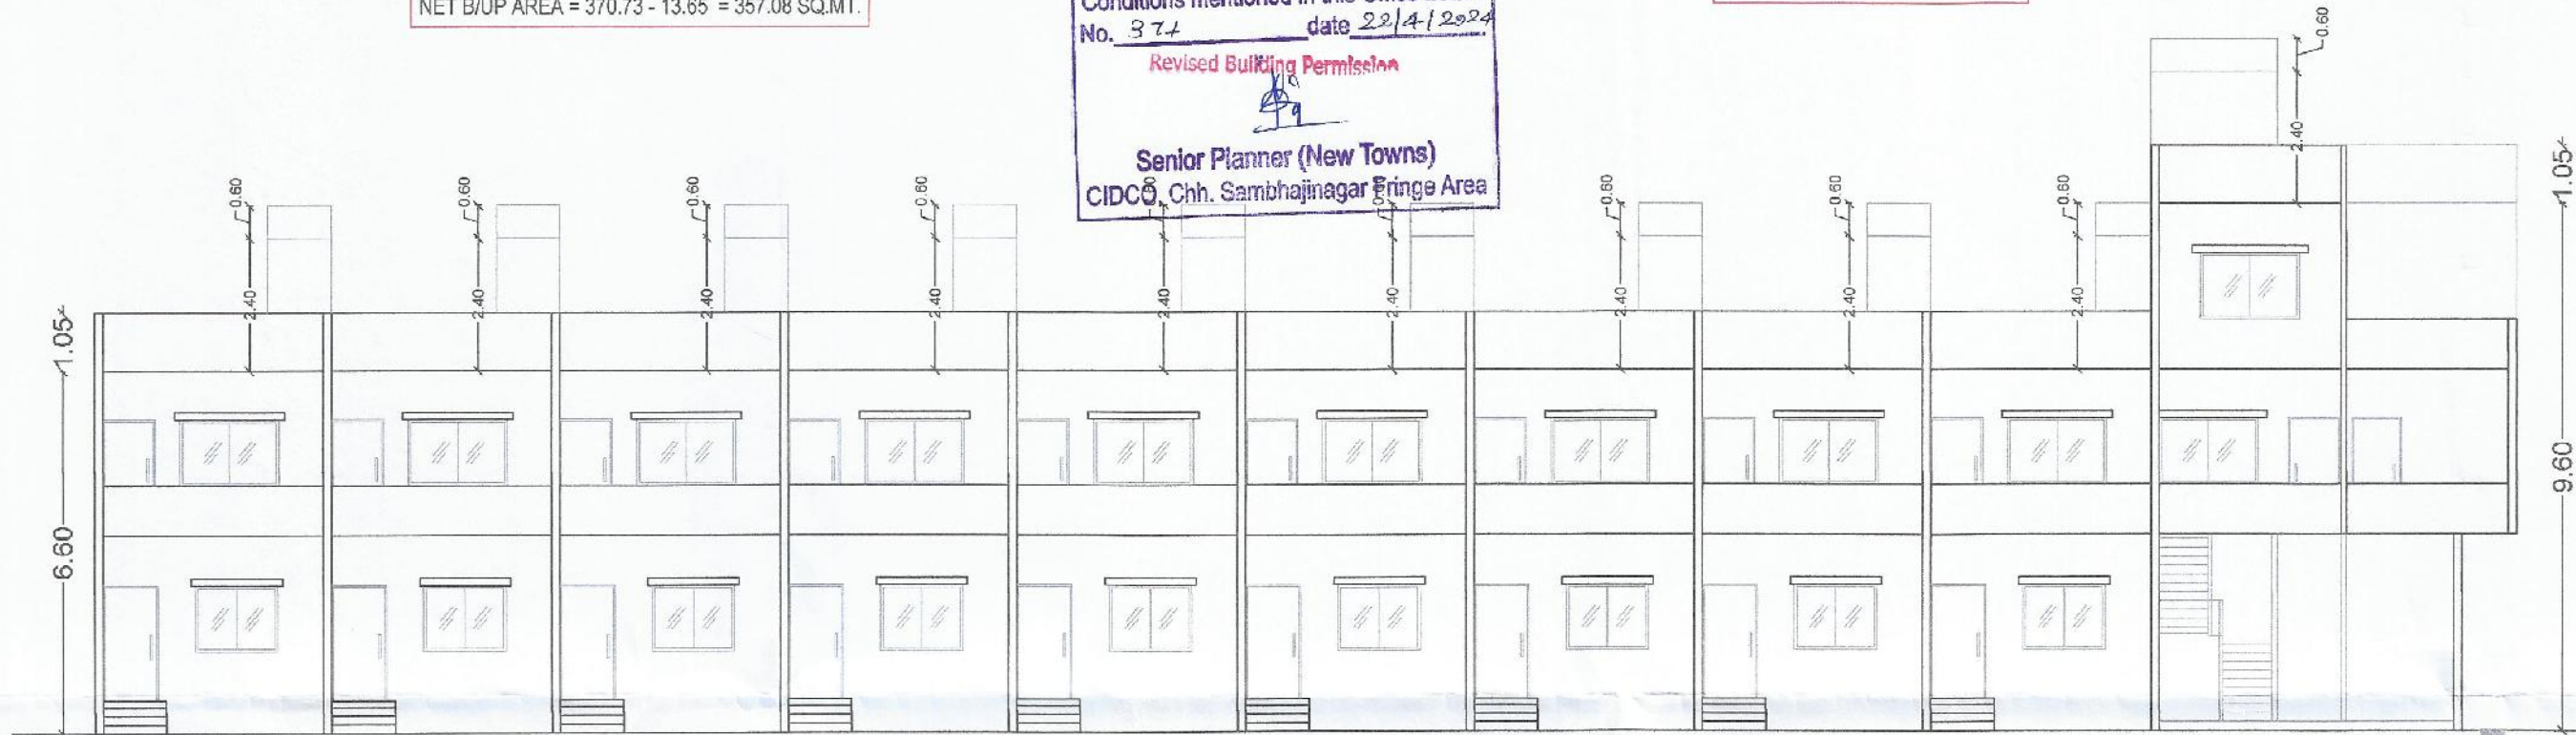

ELEVATION
SCALE 1:100

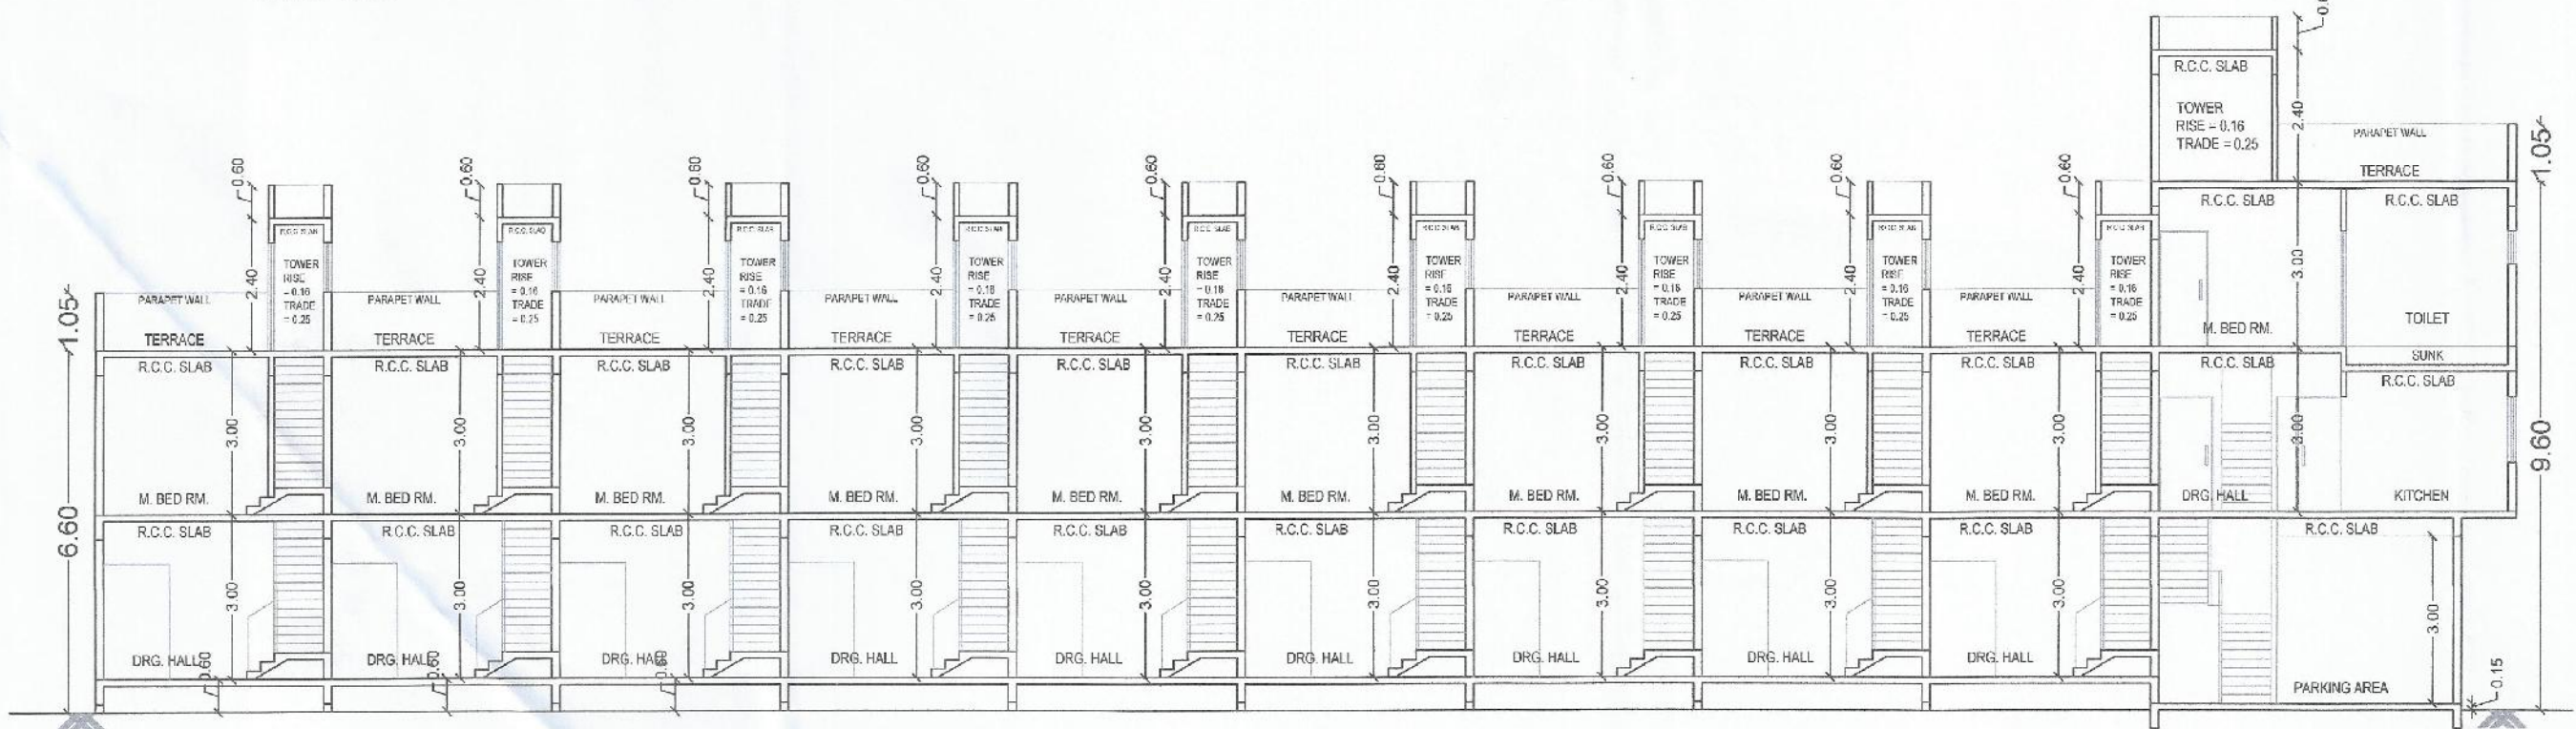


SECTION A-A'
SCALE 1:100

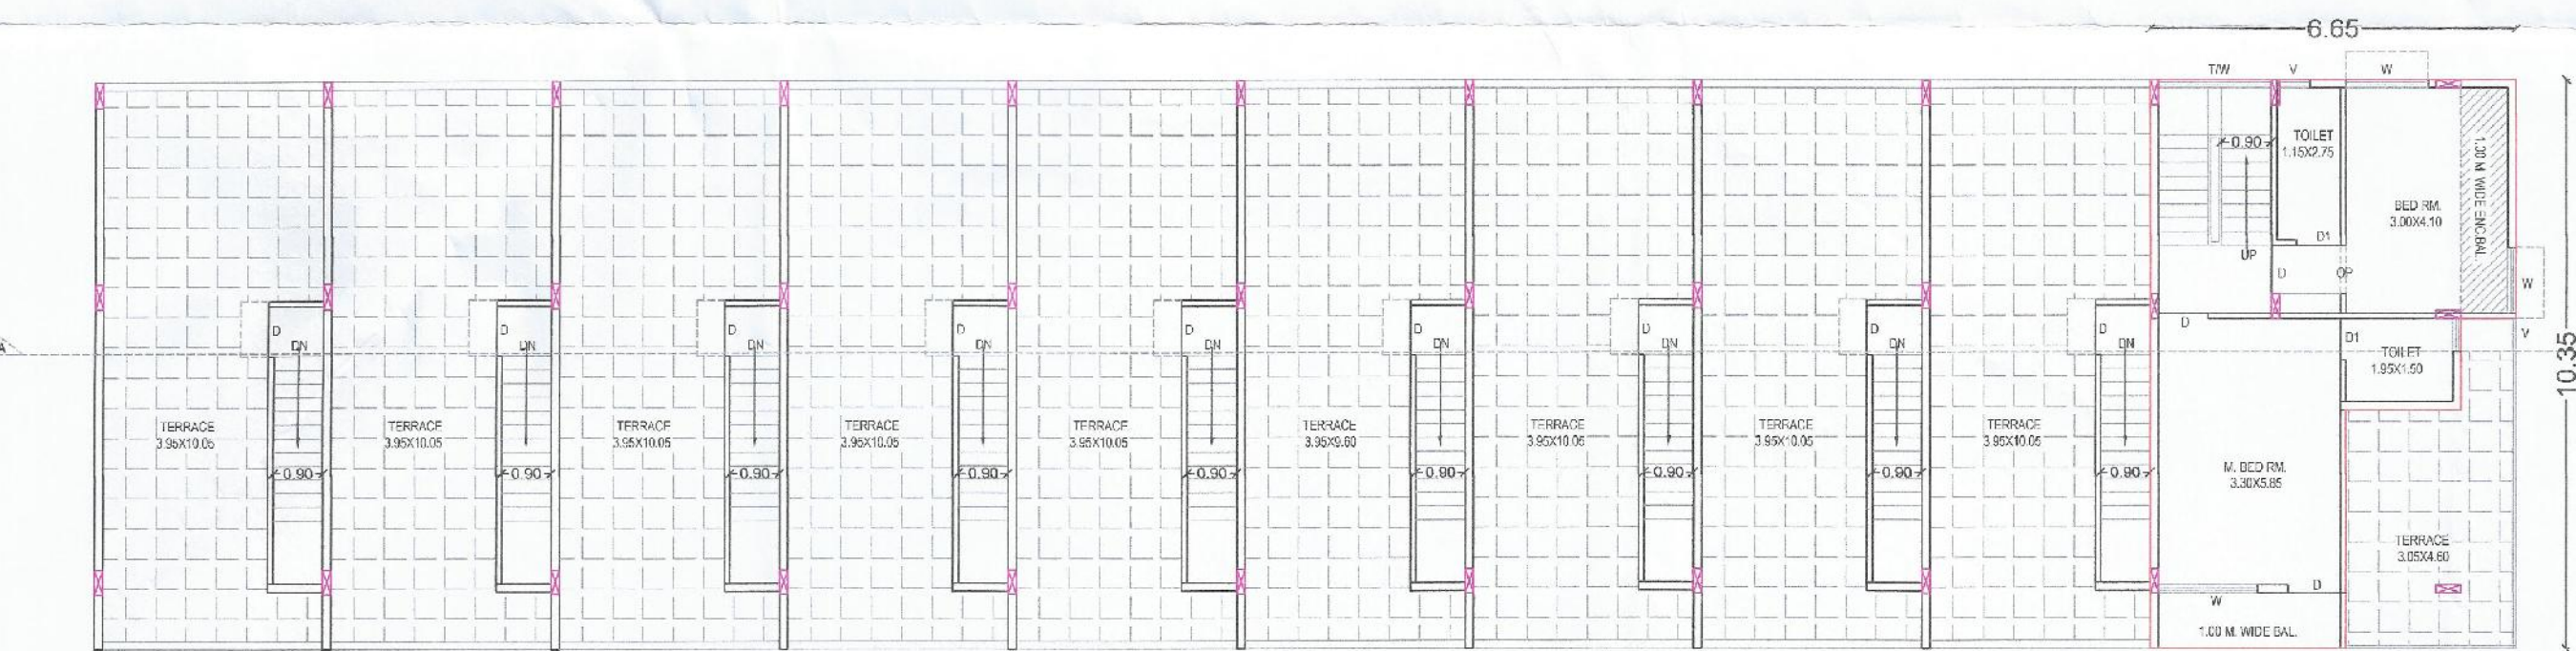

SECOND FLOOR PLAN
SCALE 1:100




FIRST FLOOR PLAN
SCALE 1:100

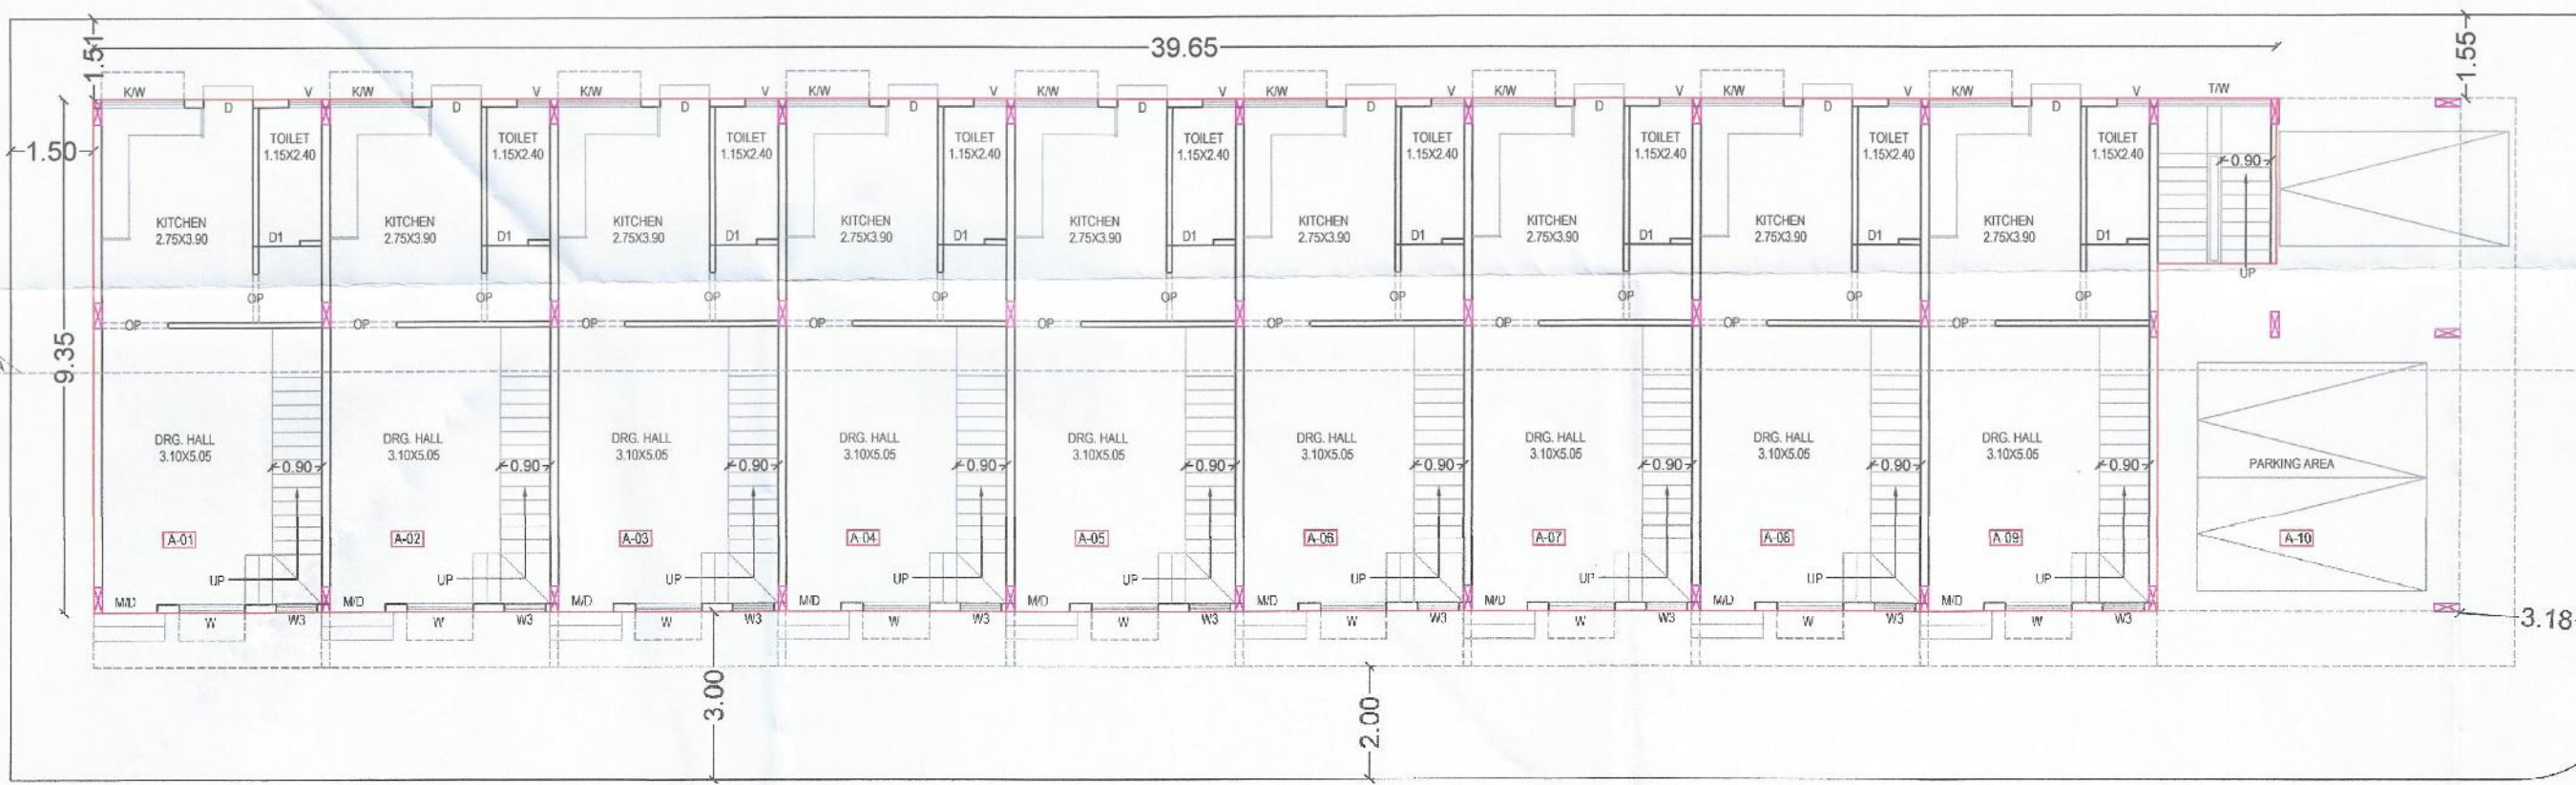

GROUND FLOOR PLAN
SCALE 1:100

7.50 M W A C C E S S

SR. NO.	FLAT NOS.	TOTAL B/U AREA	CARPET AREA
01.	A-01.	79.40 SQ.M	68.80 SQ.M
02.	A-02, A-03, A-04, A-05, A-06, A-07, A-08, A-09.	78.00 SQ.M	68.80 SQ.M
03.	A-10.	122.20 SQ.M	101.40 SQ.M

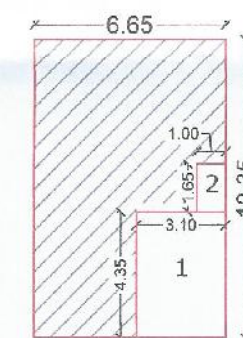


P-LINE AREA CAL. FOR SECOND FLOOR
SCALE 1:200

AREA CAL.
OVER ALL DIM. = 6.65 X 10.35 = 68.83 SQ.MT.
DEDUCT 1] = 3.10 X 4.35 = 13.49
2] = 1.00 X 1.65 = 0.165

TOTAL DEDUCTION = 15.14 SQ.MT.

NET B/U AREA = 68.83 - 15.14 = 53.69 SQ.MT.

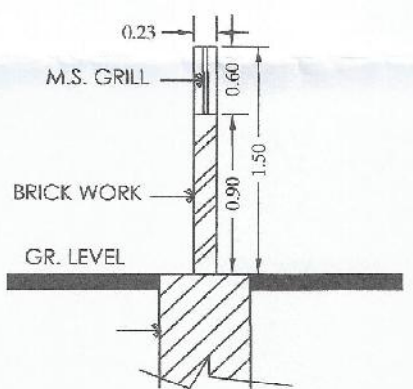

COMPOUND WALL
SECTION

SCALE :- N.T.S.

AREA STATEMENT FOR A BUILDING.

- GROUND FLOOR AREA ----- = 357.08 SQ.MT.
- FIRST FLOOR AREA ----- = 455.40 SQ.MT.
- SECOND FLOOR AREA ----- = 53.69 SQ.MT.
- TOTAL B/U AREA ----- = 866.17 SQ.MT.

SCHEDULE OF OPENINGS

MD/D - 1.00 X 2.10	T.W. PANNELED
D1 - 1.00 X 2.10	T.W. PANNELED
D2 - 0.83 X 2.10	CONCRETE FRAME & FLUSH DOOR
FD - 2.40 X 2.10	T.W. PANNELED
W - 1.50 X 1.20	ALUMINIUM SLIDING
W1 - 1.50 X 1.08	ALUMINIUM SLIDING
W2 - 1.20 X 1.20	ALUMINIUM SLIDING
W3 - 0.90 X 1.20	ALUMINIUM SLIDING
W4 - 0.60 X 1.20	ALUMINIUM SLIDING
W5 - 0.35 X 1.20	ALUMINIUM SLIDING
V - 0.60 X 0.60	M.S. LOUVERED

NOTES

- THE STRUCTURE DONE IS R.C.C. FRAME STRUCTURE.
- THE DEPTH OF FOUNDATION IS UPTO HARD STRATA.
- THE WALL CONSTRUCTION IS IN BRICK MASONARY.
- STAIRCASE PROVIDED IS NON SLIPPERY.
- DADO IS PROVIDED UP TO 2.1 M HEIGHT IN BATH AND W.C.

LEGEND

- PLOT BOUNDRY SHOWN IN BLACK.
- PROPOSED CONSTRUCTION SHOWN IN RED.
- SEWER LINE SHOWN IN RED DOTTED.
- WATER SUPPLY LINE SHOWN IN BLACK DOTTED THIN.

REVISED GROUP HOUSING SCHEME ON GUT
NO.-09(P), SITUATED AT VILLAGE- PISADEVI,
TQ. & DIST.- AURANGABAD.
WITHIN AURANGABAD FRINGE AREA
FOR - 1. MR. KAKASAHEB DAMU KALE.
2. MR. PANDHARINATH DAMU KALE.
3. MR. SANJAY DAMU KALE.

OWNERS SIGN	ARCHITECTS SIGN
1.	2.
3.	3.

REVISED DRAWING	SCALE - 1:100
DRAWN BY-D.D. CHECKED BY - D.D. DT - 19.02.2024	DRWG NO. 02

BUILDING - A