

P-LINE AREA CAL. FOR GROUND FLOOR

SCALE 1:200

AREA CAL.
OVER ALL DIM. = 35.75 X 08.00 = 286.00 SQ.MT.

NET B/UP AREA = 286.00 SQ.MT.

P-LINE AREA CAL. FOR FIRST FLOOR

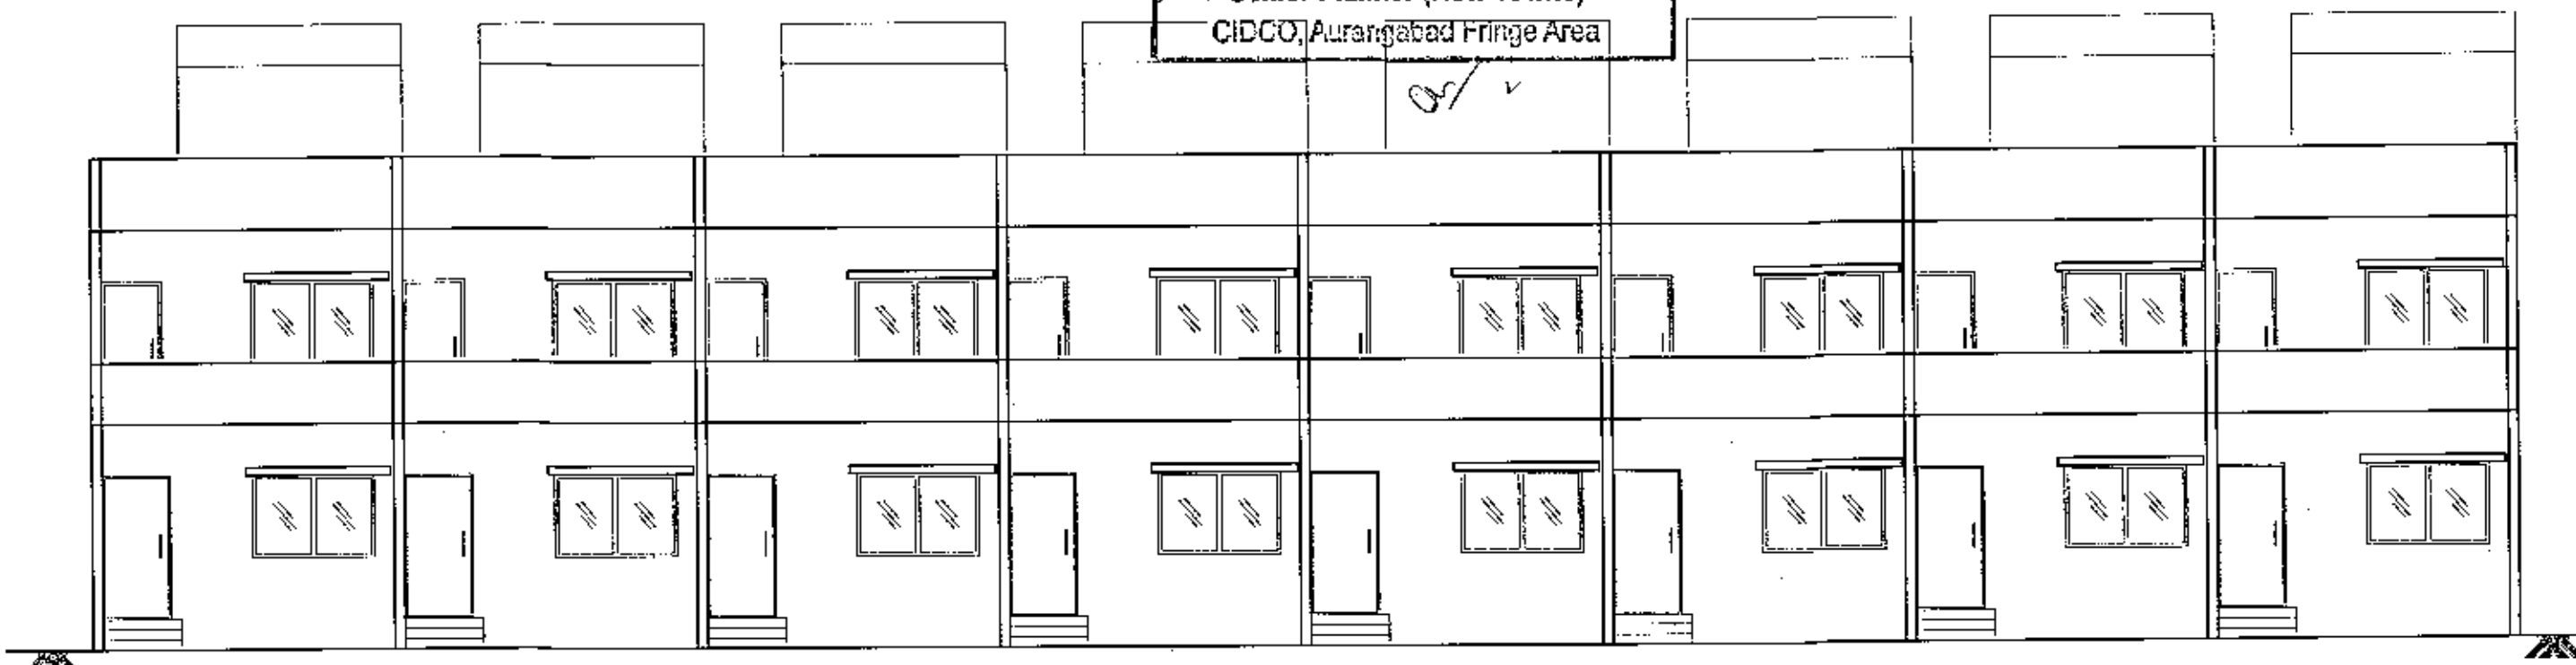
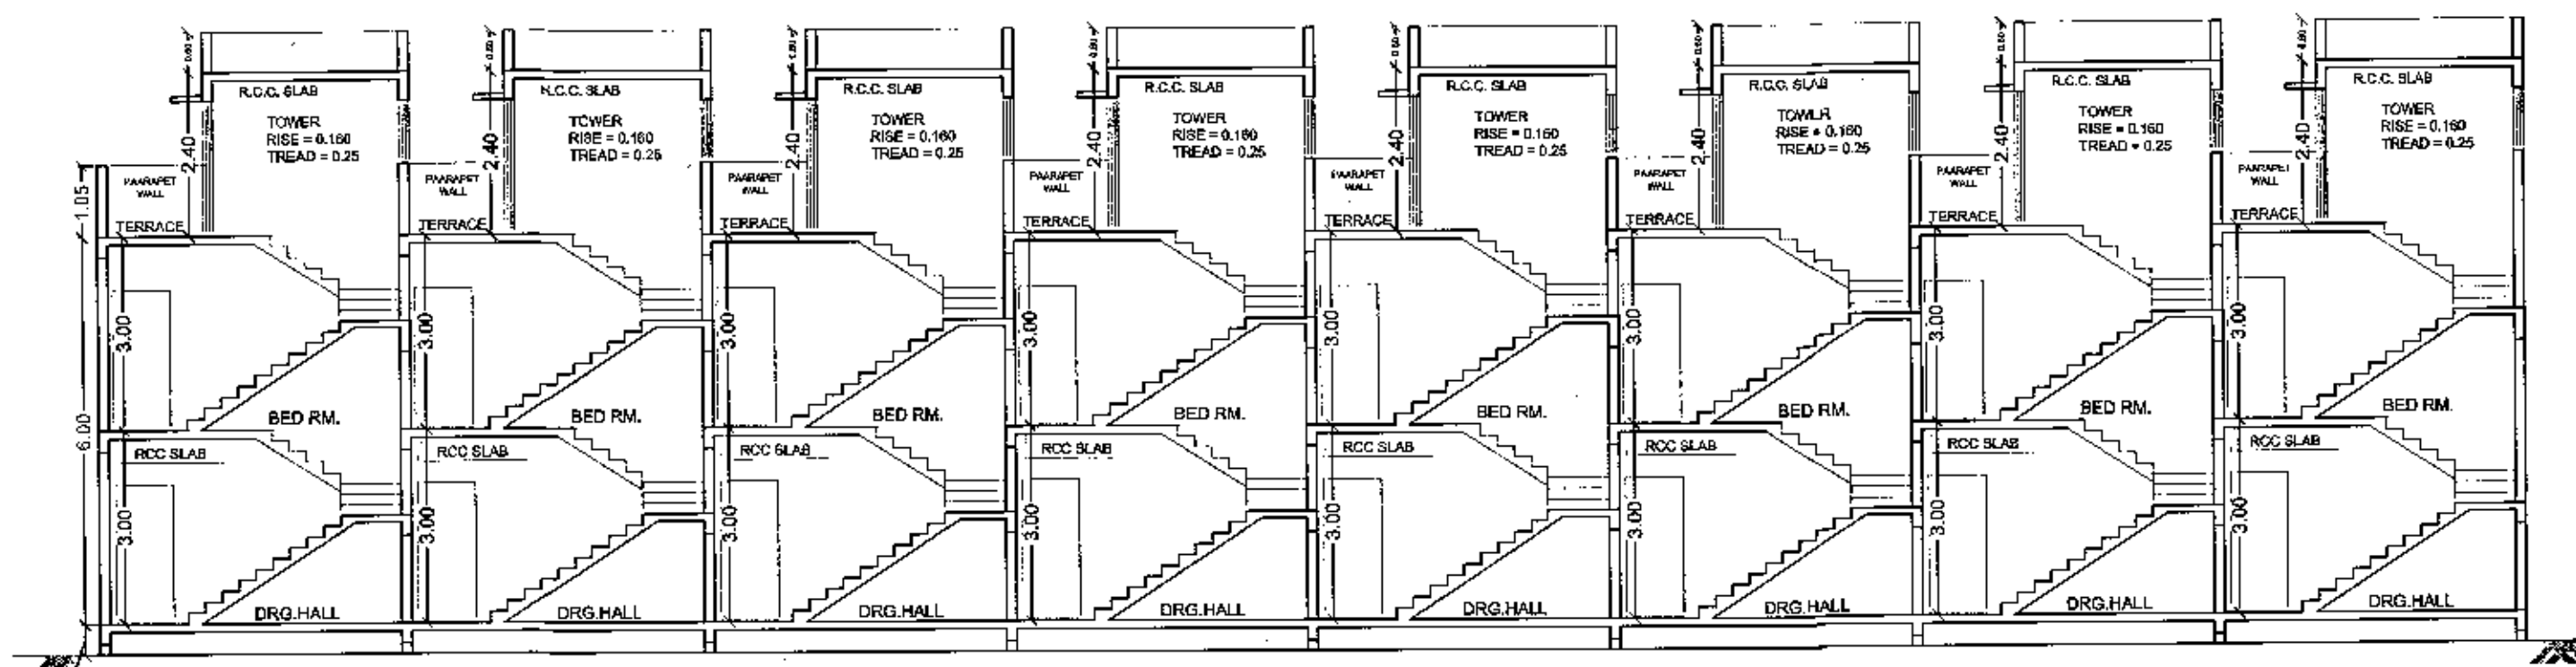
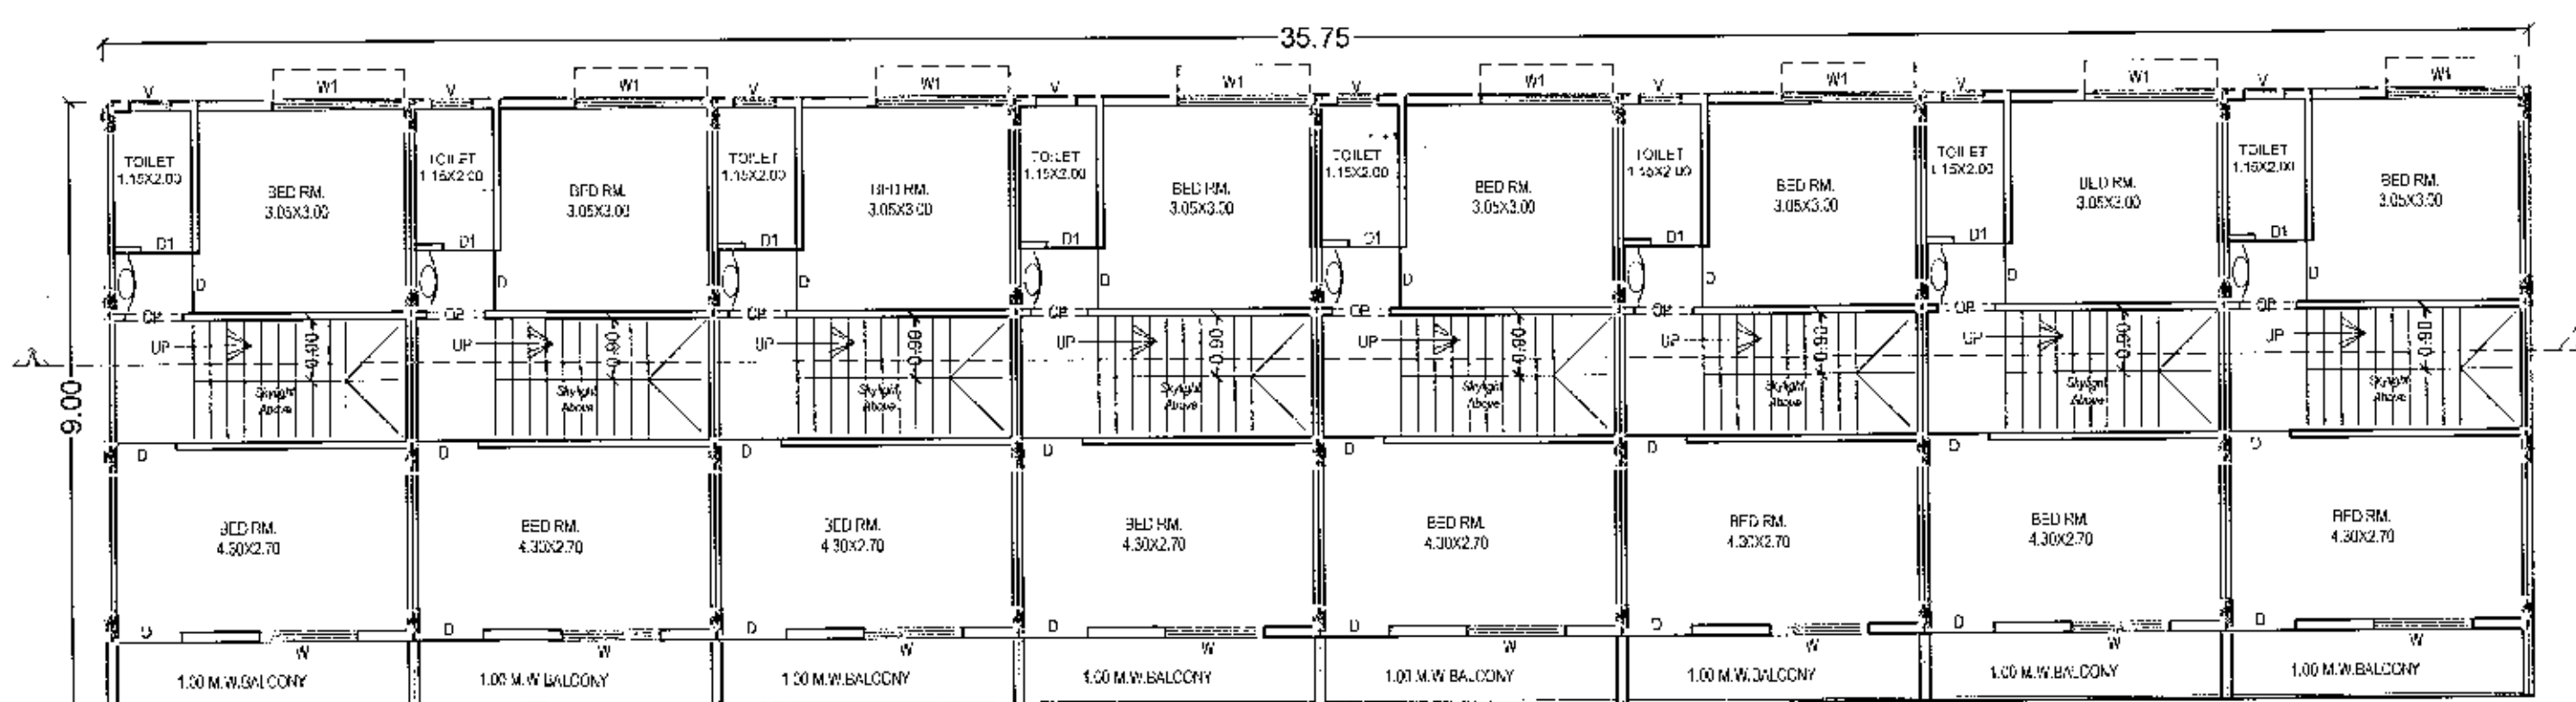
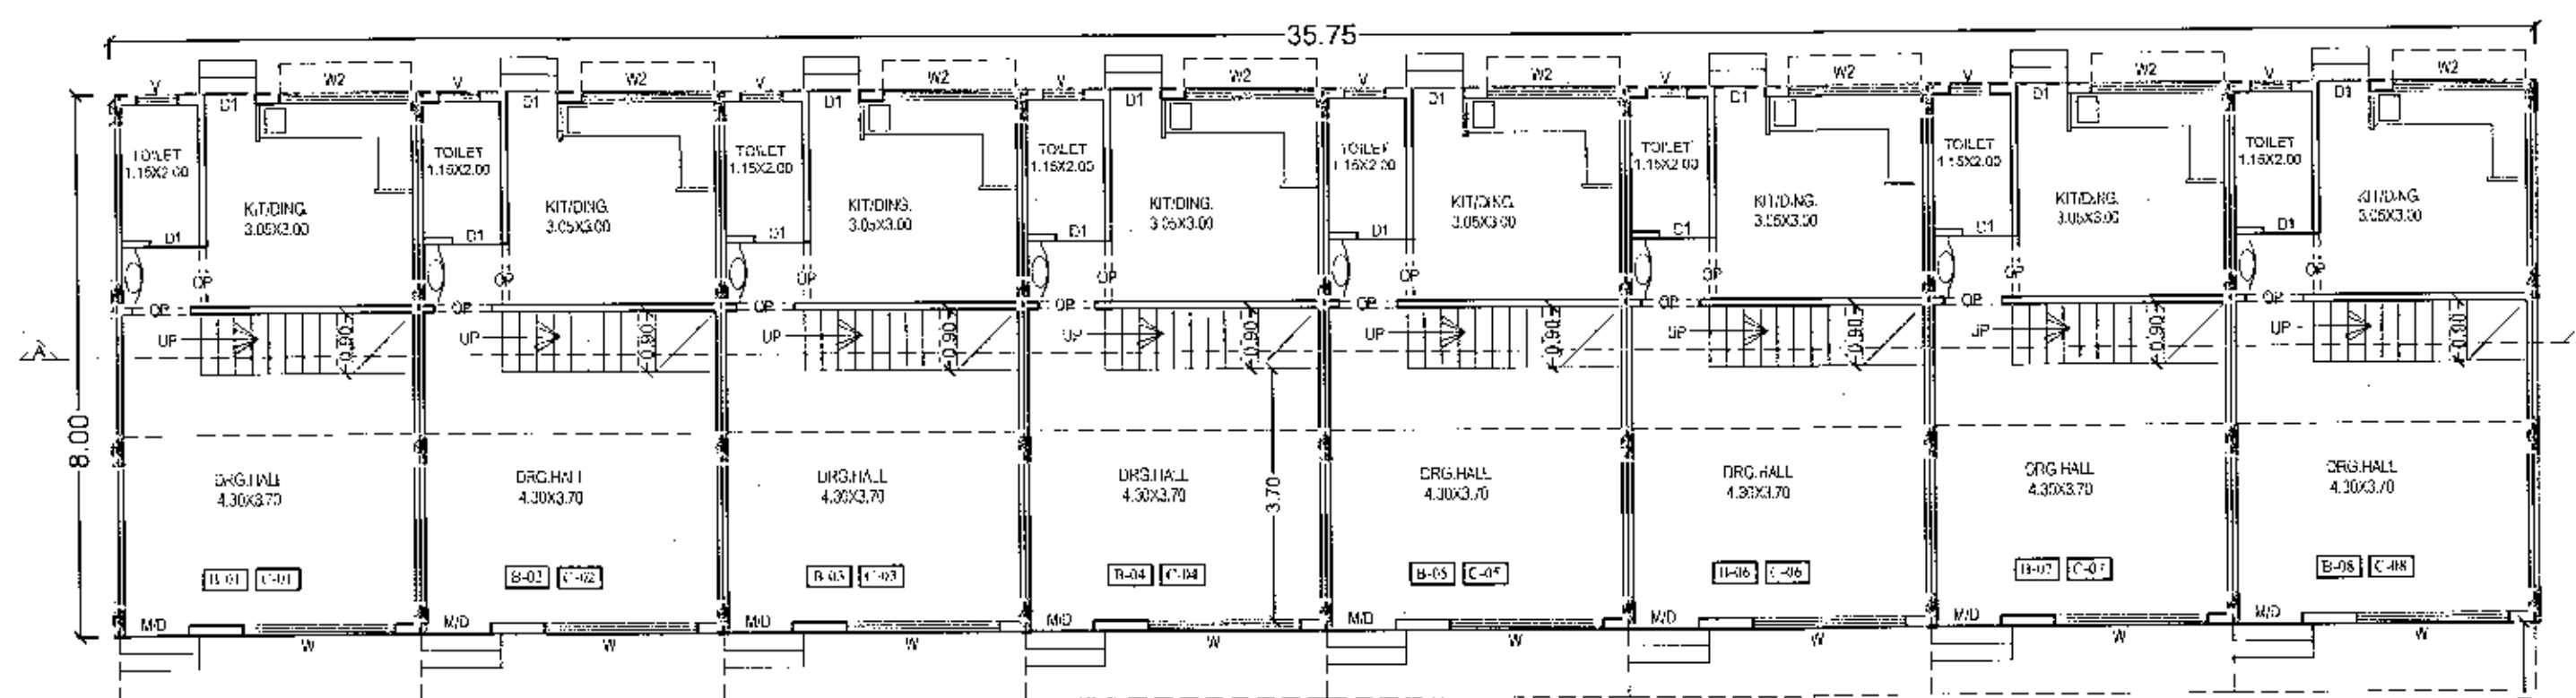
SCALE 1:200

AREA CAL.
OVER ALL DIM. = 35.75 X 09.00 = 321.75 SQ.MT.

NET B/UP AREA = 321.75 SQ.MT.

Approved as amended in red, subject of
Conditions mentioned in this Office Letter
No. 71 dated 18.04.2022.

Senior Planner (New Towns)
CIDCO, Aurangabad Fringe Area

ELEVATION
SCALE 1:100SECTION A-A'
SCALE 1:100FIRST FLOOR PLAN
(SCALE=1:100)GROUND FLOOR PLAN
(SCALE=1:100)

9.00 M. WIDE ROAD

B & C-TYPE BUILDING

B/UP AREA STATEMENT			
SR.NO.	B & C-BUILDING	B/UP AREA	CARPET AREA
1.	B-01, C-01. B-08, C-08.	76.90 SQ.MT.	66.25 SQ.MT.
2.	B-02, C-02. B-03, C-03. B-04, C-04. B-05, C-05. B-06, C-06. B-07, C-07.	75.65 SQ.MT.	66.25 SQ.MT.

B-UP AREA CALCUTATION

B & C-TYPE BUILDING

- 1] GROUND FLOOR AREA = 286.00 SQ.MT.
 2] FIRST FLOOR AREA = 321.75 SQ.MT.
 3] TOTAL B/UP AREA = 607.75 SQ.MT.

SCHEDULE OF OPENINGS

MD/D - 1.00 X 2.10	T.W. PANNELED
D1 - 1.00 X 2.10	T.W. PANNELED
D2 - 0.83 X 2.10	CONCRETE FRAME & FLUSH DOOR
FD - 2.40 X 2.10	T.W. PANNELED
W - 1.50 X 1.20	ALUMINIUM SLIDING
W1 - 1.50 X 1.08	ALUMINIUM SLIDING
W2 - 1.20 X 1.20	ALUMINIUM SLIDING
W3 - 0.90 X 1.20	ALUMINIUM SLIDING
W4 - 0.80 X 1.20	ALUMINIUM SLIDING
W5 - 0.35 X 1.20	ALUMINIUM SLIDING
V - 0.60 X 0.60	M.S. LOUVERED

NOTES

1. THE STRUCTURE DONE IS R.C.C. FRAME STRUCTURE.
 2. THE DEPTH OF FOUNDATION IS UPTO HARD STRATA.
 3. THE WALL CONSTRUCTION IS IN BRICK MASONRY.
 4. STAIRCASE PROVIDED IS NON SLIPPERY.
 5. DADO IS PROVIDED UP TO 2.1 M HEIGHT IN BATH AND W.C.

LEGEND

1. PLOT BOUNDRY SHOWN IN BLACK.
 2. PROPOSED CONSTRUCTION SHOWN IN RED.
 3. SEWER LINE SHOWN IN RED DOTTED.
 4. WATER SUPPLY LINE SHOWN IN BLACK DOTTED THIN.

PROPOSED LAYOUT PLAN FOR GROUP HOUSING
SCHEME ON GUT NO.-91(P) AT PISADEVI,
TQ.& DIST.-AURANGABAD.

FOR

1. MR. - ARUN VITTHAL KALE.

OWNER'S SIGN

1. *[Signature]*

ARCHITECT'S SIGN

[Signature]

ARCHITECT
 Mr. Dhananjay B. Dofode
 (B.Arch, M.Arch)
 CA/2013/60839
 "Ganga" P.No.3 & 4, Gajanan Colony, Aurangabad

D² ARCHITECT'S & INTERIOR DESIGNER'S
 (DEVA'S GROUP)
 AR.DHANANJAY DOFODE
 "GANGA" PLOT NO.3 & 4, GAJANAN
 COLONY, GARKHEDA, AURANGABAD.
 MO - 9767455995 email: dofoadkhananajay@gmail.com

SUBMISSION DRAWING

SCALE - 1:100

DRAWN BY - D.D.

DT - 04.03.2022

DRWG NO. 03/05