


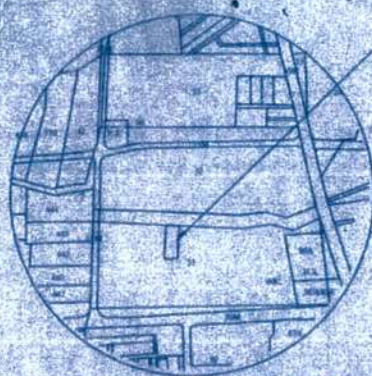

LOCATION PLAN
[SCALE 1:10,000] (D.P. PAGE NO. 10)


PROP. SITE

PLOT AREA STATEMENT

PLOT NO.	AREA IN SQM
1	373.29
2	409.35
3	682.22
4	674.32
5	678.39
TOTAL = 2817.57 SQM.	

HISSA LAND AREA STATEMENT

S. NO.	AREA
31/1/2/2/1	2000.00
31/1/2/2/4	2000.00
TOTAL AREA = 4000.00 SQM.	

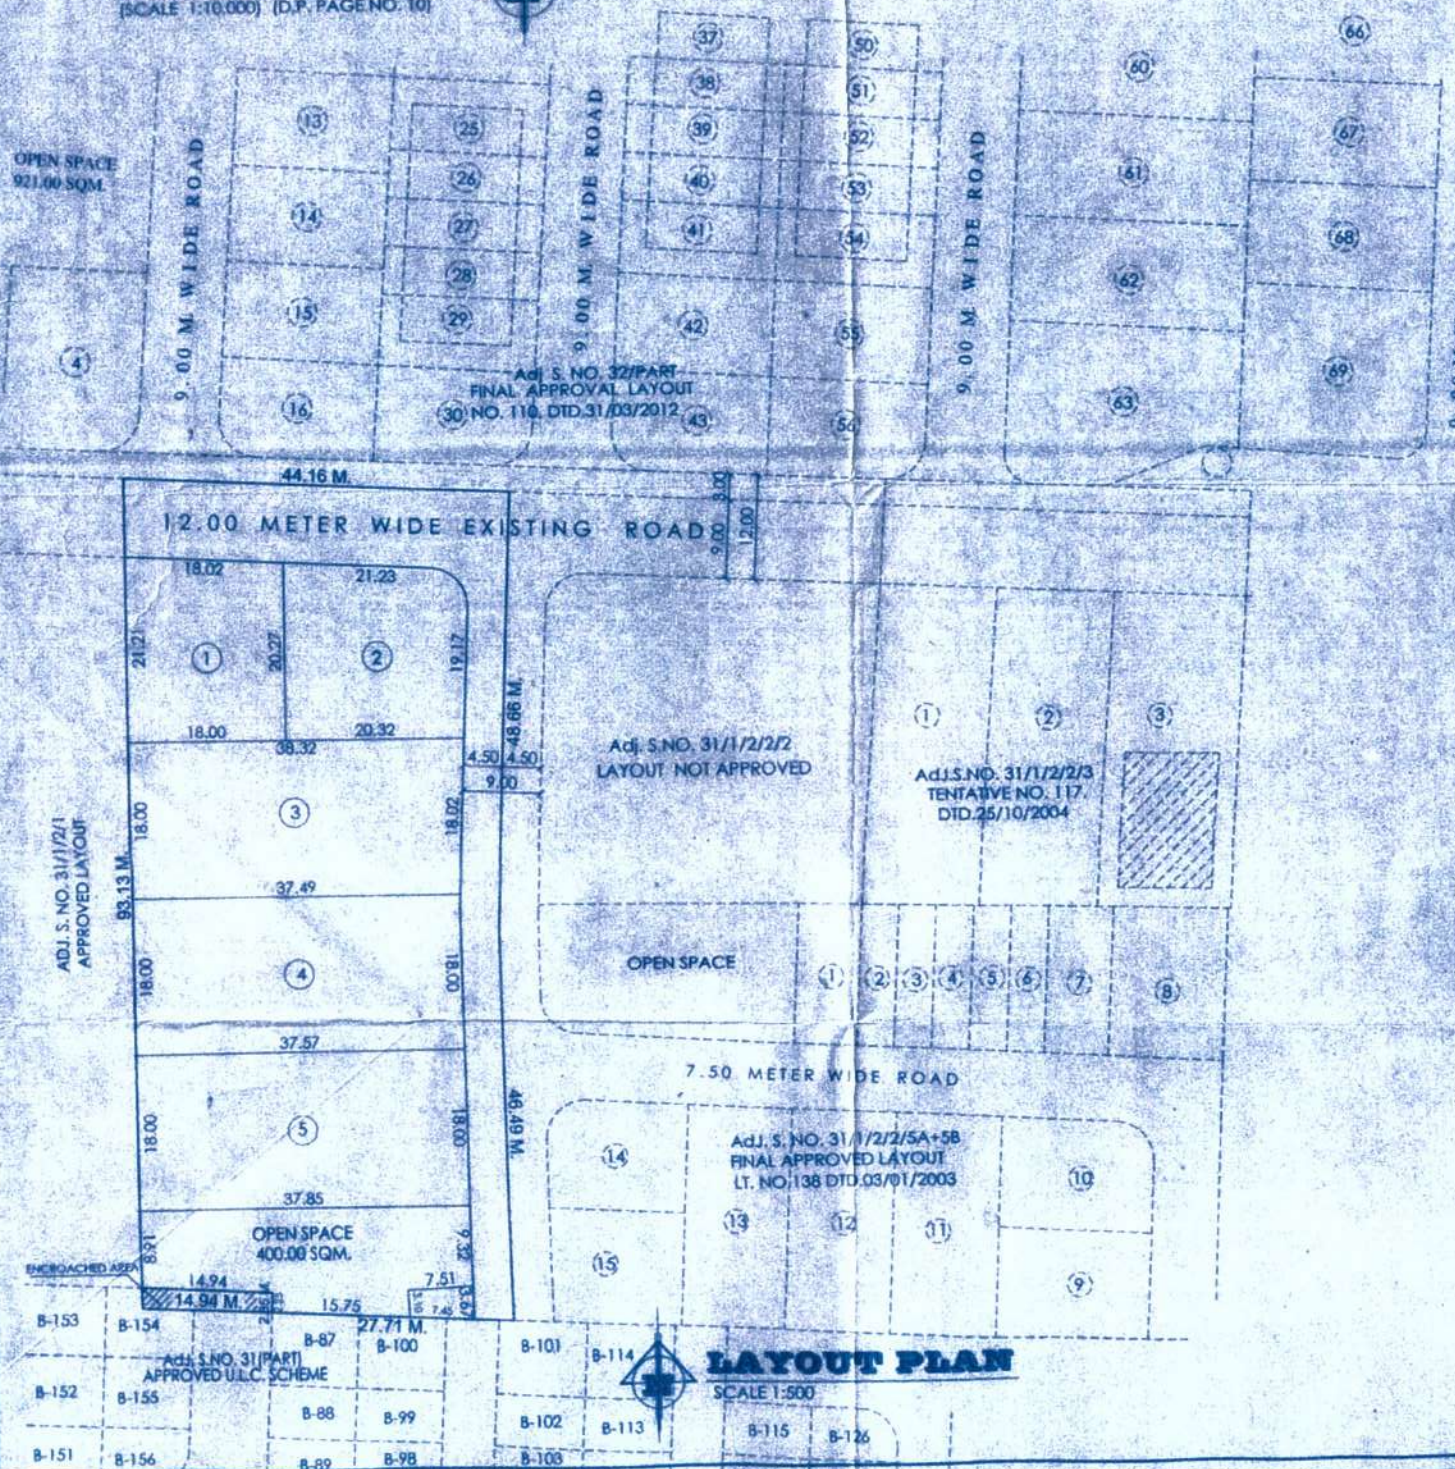

APPROVAL

APPROVED
(Demarcated Final) Layout as per conditions
Mentioned in letter No. UND/WS/C-2/78.
Date: 06/09/2012. View of Section 152(13)
& 49 of The Maharashtra Regional & Town
Planning Act 1966.

SD/- X-X-X
Assistant Director of Town Planning TOWN
PLANNING
Nashik Municipal Corporation Nashik

DEMARCATION CERTIFICATE

THIS IS TO CERTIFY THAT I HAVE VERIFIED
DEMARCATED LAYOUT WHICH IS TENTATIVELY
APPROVED BY NASHIK MUNICIPAL CORPORATION
NASHIK VIDE LETTER NO. TPD/TTL (PANCHI)/76
DT.23/11/2012 AND FURTHER CERTIFY THAT THE
MEASUREMENTS OF PLOTS, AND ROADS ETC.
SHOWN IN DEMARCATION PLAN ARE AT SITE.

ARCHITECT SIGN.

NOTES -

- ALL DIMENSION ARE IN METER
- LAND BOUNDARY SHOWN IN BLACK
- OPEN SPACE SHOWN IN GREEN

AREA STATEMENT

	AREA IN SQM.
1) AREA OF THE LAND (AS PER 7/12)	4000.00
2) AREA UNDER OPEN SPACE	400.00
3) AREA UNDER M.S.E.D.C.L.	25.00
4) AREA UNDER ROADS	757.43
5) AREA UNDER PLOTS	2817.57

**DEMARCATED RESIDENTIAL FINAL LAYOUT
PLAN IN S.NO.31/1/2/2/1 & S. NO31/1/2/2/4
MAKHAMALABAD SHIWAR IN NASHIK
FOR SHRI AKASH ANIRUDHA GAWADE**

AR. SHRI. G. V. KATALE

ARCHITECTS SIGN

SHRI AKASH ANIRUDHA GAWADE

OWNERS SIGN



G.V. KATALE AND ASSOCIATES

CONSULTING ENGINEERS & ARCHITECTS

OFFICE No. 01, KAMAL RESIDENCY
PAST LANE No. 4, COLLEGE ROAD,
NASHIK-2, PH. (021) 2586038, 2586927
Email - gvkatale@gmail.com

ACCESS BY: DASHINIL V. KATALE	DATE: 06/09/2012	CAD: BY: KATALE G. V.
DRG. REF: AS PER P. J. SHEET	SCALE: 1:500	DRG. BY: J.P. PANDHARKAR