
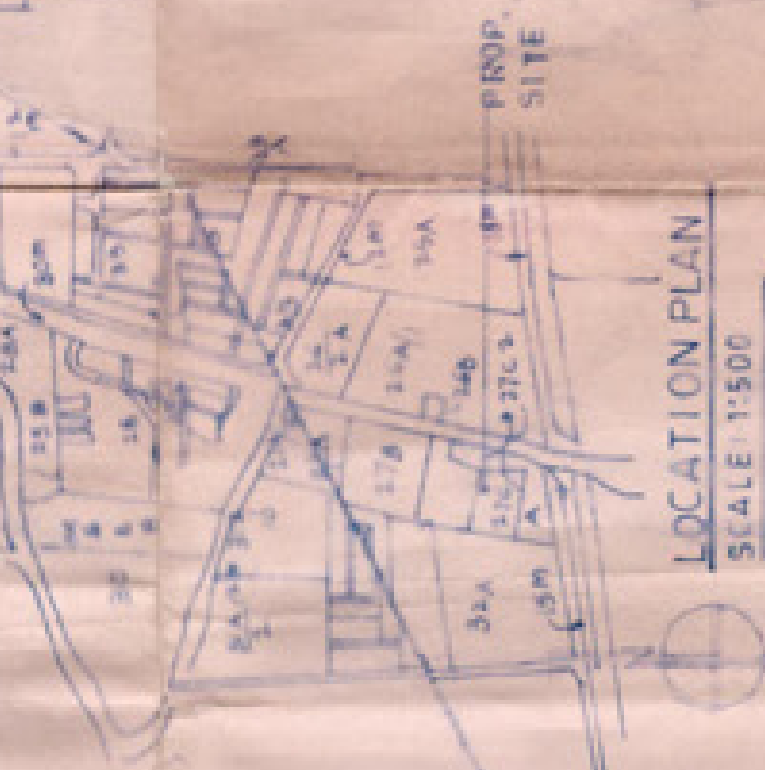


ADJOINING SNO. 27 B
FINAL APPROVED LAYOUT
DV/NR/215/2000 DATED 15/8/73

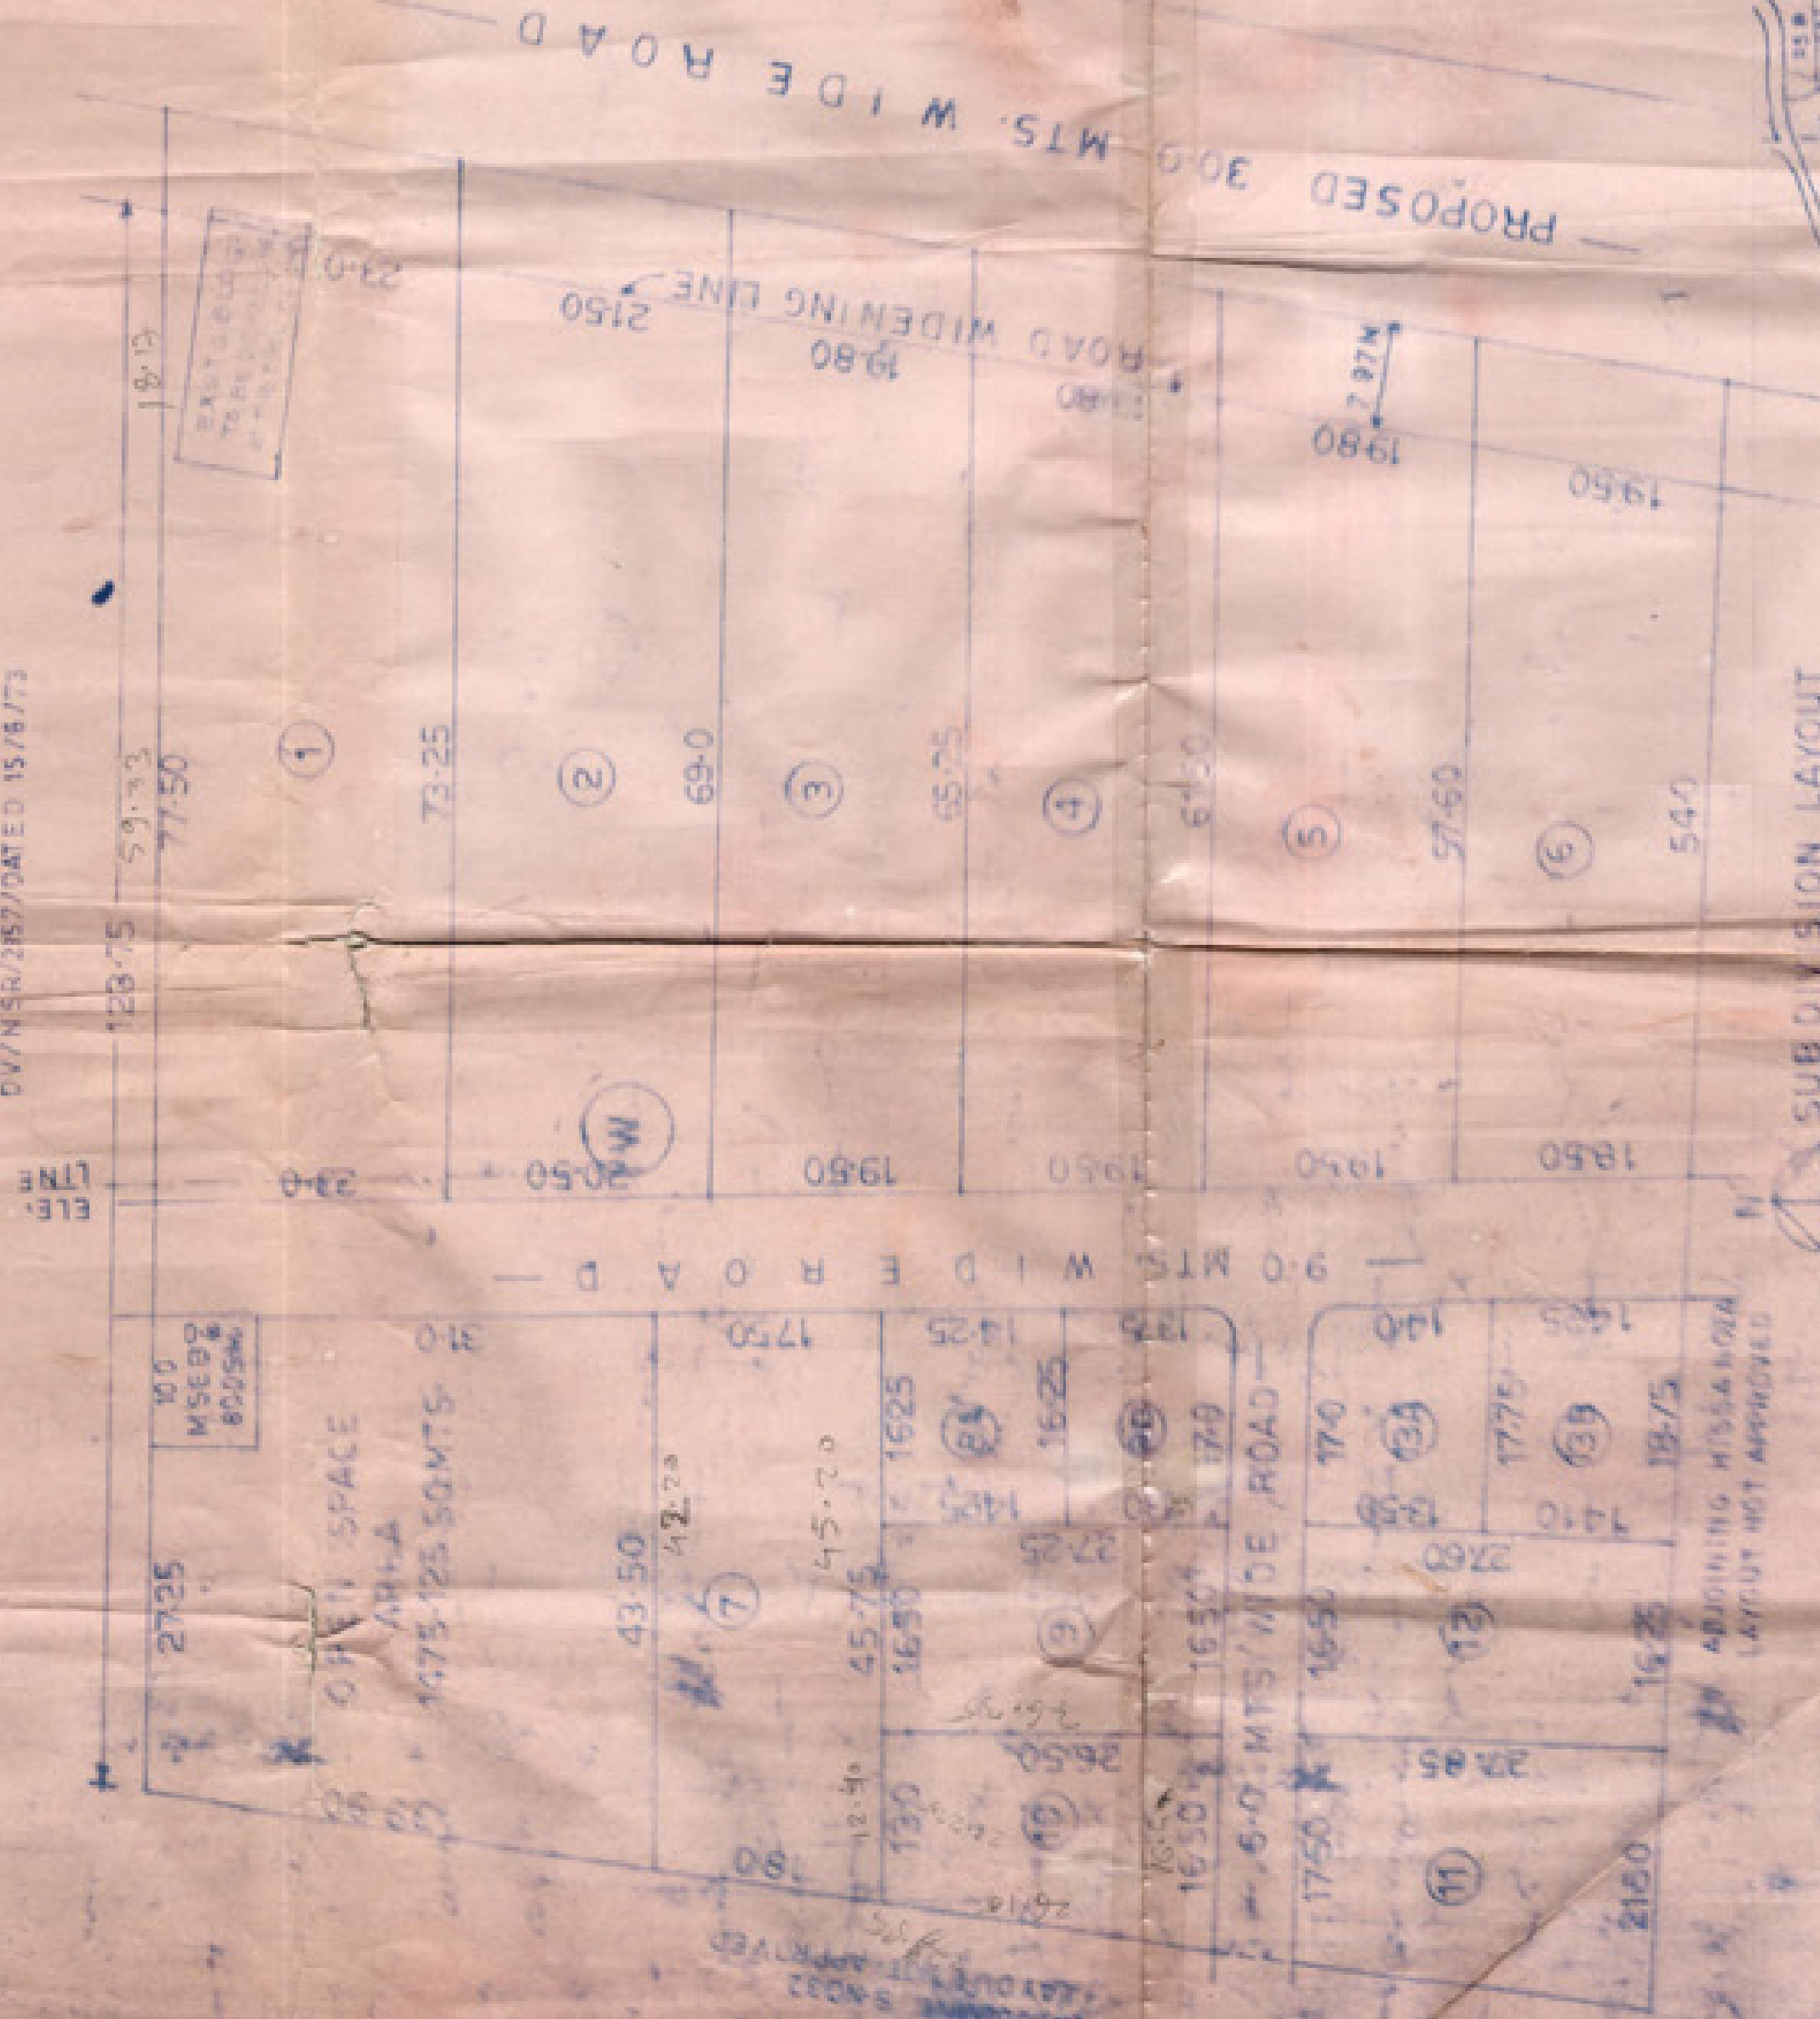

AREA STATEMENT OF THE LAND	
TOTAL AREA AS PER 7/2 EXTRACTS	
SNO 27C/A/1	11880.00 SQ. MTS
SNO 27C/1/2	2780.00 --
TOTAL	14660.000 --
AREA UNDER D.P. ROAD & AREA UNDER INT. ROADS	1595.985 --
AREA UNDER PLOTS	11508.89 --
AREA UNDER OPENS SPACE	1475.125 --
AREA UNDER MSEB	80.000 --

NOTES: ALL THE DIMENSIONS ARE IN METERS
- PLOT BOUNDARY SHOWN IN BLACK
- OPEN SPACE SHOWN IN GREEN
- PLOT NO. 1 IS A NON VECANT PLOT.

LOT NOS.	NET AREA IN SQ. MTS.
1	1724.525
2	1468.130
3	1300.030
4	1235.720
5	1170.800
6	1071.000
7	780.000
8A	231.560
8B	217.340
9	446.875
10	395.130
11	517.820
12	448.200
3A	247.500
3B	254.250
TOTAL	11508.890

PLOT STATEMENT FOR THE PLOTS ON D.P. ROAD			
LOT NOS.	NET AREA IN SQ. MTS.	PERMISSIBLE 40% AREA IN SQ. MTS.	D.P. ROAD AREA IN SQ. MTS.
1	1724.525	689.81	69.43
2	1468.130	587.25	78.31
3	1300.030	520.01	57.88
4	1235.720	494.29	50.10
5	1170.800	468.32	42.48
6	1071.000	428.40	30.10
TOTAL	7970.215		358.00

TOTAL P.S.I. OF PLOT IN SQ. MTS.
1933.955
1646.440
1457.910
1385.820
1312.990
1201.100
8938.215

APPROVING AUTHORITY

DEMARKATION CERTIFICATE

THIS IS TO CERTIFY THAT I HAVE PERSONALLY DEMARKED THIS LAYOUT WHICH IS TENTATIVELY APPROVED BY NASHIK MUNICIPAL CORPORATION NASHIK VIDE LETTER NO. LND/1/TENT LAYOUT/17 OF 73/2000 AND FURTHER CERTIFY THAT THE MEASUREMENTS OF PLOTS ROADS AND OPEN SPACE SET DOWN IN DEMARKATION PLAN ARE ACTUALLY ON SITE.

ARCHITECT'S SIGN

DEMARKED FINAL LAYOUT IN SNO S. 27C/A/1 & 1/2 AT DASAK NASHIK FOR ARTSHNAKAMAL BANERJI A HOLDER RAJENDRA R. SHAH

GR. HOLDER RAJENDRA R. SHAH ARCHITECT'S SIGNATURE OWNERS SIGNATURE ARCHITECT CA/B4/8452

C. G. MAYUR, 1/2 MAYUR MILAN, PLOT NO. 8, DATE 14/08/2000, NEAR MATE NURSERY OFF GANGAPUR ROAD, NASHIK. TELE 340605

JOB NO. DATE 10/1/2000 CKD C.S. MAYUR DRG NO. 1 SCALE 1:500 DRN DEEPAK