

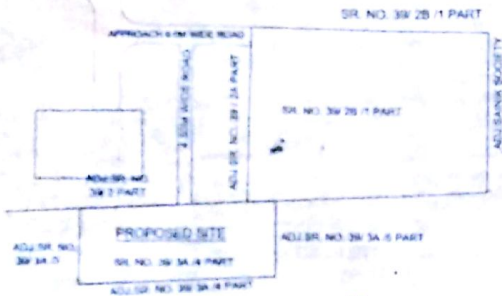
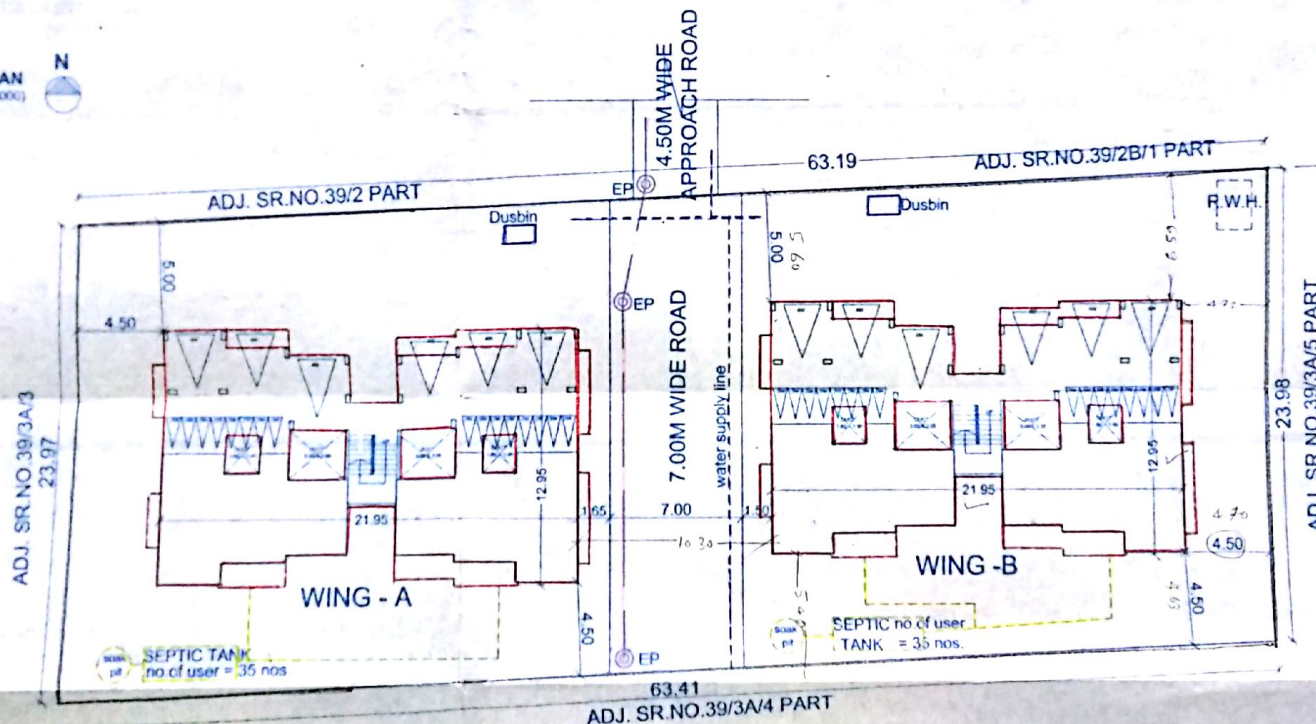
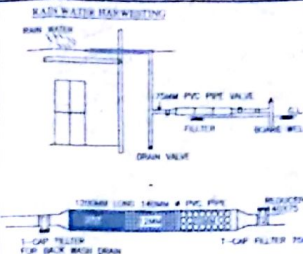
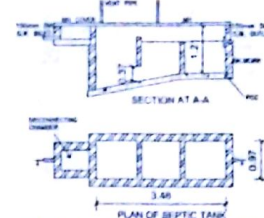


DISBUR AIR BASE ROAD

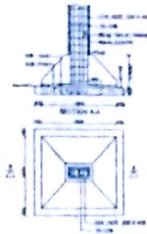

LOCATION PLAN  
SCALE (1:1000)

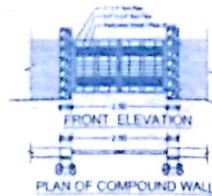

SITE PLAN  
(SCALE 1:200)



SHEET TITLE  
**SITE PLAN**

SHEET NO.  
**2/2**

**AREA STATEMENT**

|                                        |         |
|----------------------------------------|---------|
| A) AREA STATEMENT                      | 50.00   |
| 1) TOTAL PLOT AREA AS PER 7/12 EXTRACT | 1500.00 |
| 2) TOTAL PLOT AREA AS PER SITE         | 1500.00 |
| 3) ALLOWABLE F.S.T. (0.50)             | 750.00  |
| A) PROPOSED AREA STATEMENT             | 50.00   |
| 1) TOTAL B.U.P. AREA OF WING - A       | 574.661 |
| 2) TOTAL B.U.P. AREA OF WING - B       | 574.661 |
| 4) TOTAL B.U.P. AREA                   | 749.322 |
| 5) TOTAL BALANCE AREA                  | 0.678   |

**NOTES**

- a) BOUNDARY OF THE LAND SHOWN IN THICK BLACK
- b) PROPOSED WORK SHOWN IN RED
- c) DRAINAGE LINE SHOWN IN YELLOW
- d) ELECTRIC LINE & ELECTRIC POLE SHOWN IN PINK
- e) DUSTBIN SHOWN IN BLUE
- f) WATER SUPPLY LINE SHOWN IN DOTTED BLUE

**SPECIFICATION**

- a) P.C.C. 1:4:8
- b) R.C.C. FOOTING, COLUMNS, BEAM & SLAB
- c) EXTERNAL BRICK WALLS 0.15MM THICK
- d) INTERNAL BRICK WALLS 0.10MM THICK
- e) INTERNAL NEERU PLASTER
- f) EXTERNAL DOUBLE COAT PLASTER
- g) FLOORING MOSAIC TILES
- h) G.I. PIPE FITTING FOR BATH, W.C. & KITCHEN
- i) GLAZED TILES FOR BATH, W.C. & KITCHEN DADO

| OWNER SIGN         | ARCHITECT SIGN                                            |
|--------------------|-----------------------------------------------------------|
|                    |                                                           |
| MR. VINOD J. YERAM | AR. SHEETAL CHOUGULE<br>CA/98/23841<br>AR. S. V. CHOUGULE |

PROPOSED RESIDENTIAL BUILDING PLAN  
(TIRUPATI GARDEN PHASE-III) ON  
SR NO 39/3A/4 PART, BHAGUR VILLAGE, DEOLALI  
CANTONMENT, TAL & DIST NASHIK FOR G.P.A.  
HOLDER MR. VINOD JAIRAM YERAM  
FOR M/S. RIDDHI SIDDHI CONSTRUCTION

|                                                                                                                                                                                                            |                                         |                                                                             |
|------------------------------------------------------------------------------------------------------------------------------------------------------------------------------------------------------------|-----------------------------------------|-----------------------------------------------------------------------------|
| ARCHITECTURE, INTERIOR DESIGN, VALUATION<br>P. NO. - 155, Gopi-Krishna Chouza Colony<br>Opp college Road Police Station Nashik-05<br>email - chougulearchitect@gmail.com<br>Ph. 0253 2314820 MO 9623010920 | DRG NO - 1<br>JOB NO -<br>SCALE - 1:100 | DATE - 05/12/2015<br>CHD BY - Ar. S.V. CHOUGULE<br>DRG BY - Ar. Rahul Patil |
|------------------------------------------------------------------------------------------------------------------------------------------------------------------------------------------------------------|-----------------------------------------|-----------------------------------------------------------------------------|