


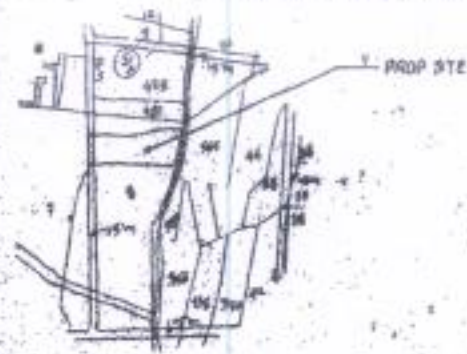


LOCATION PLAN
Scale: 1:10000

AREA STATEMENT OF PLOTS

PLOT NOS.	AREA IN M ²	PLOT NOS.	AREA IN M ²	PLOT NOS.	AREA IN M ²
1	392.46	15	242.10	44	184.50
2	458.00	16	198.00	45	197.00
3	432.65	23, 24	220.50	46	196.00
4	304.00	25, 26	198.00	52	202.50
5, 6, 7	180.00	29	177.15	53	207.00
8	158.40	30	153.00	54	180.00
9	408.10	31, 32	180.00	59	359.25
10, 11, 12	150.00	36, 37	207.00		
13, 14	207.00	38	180.00		
15, 16, 17	180.00	43	158.00		

TOTAL PLOTTED AREA = 12209.17 SQM
PLOT NO: 60 (AMINITY PLOT) = 924.25 SQM

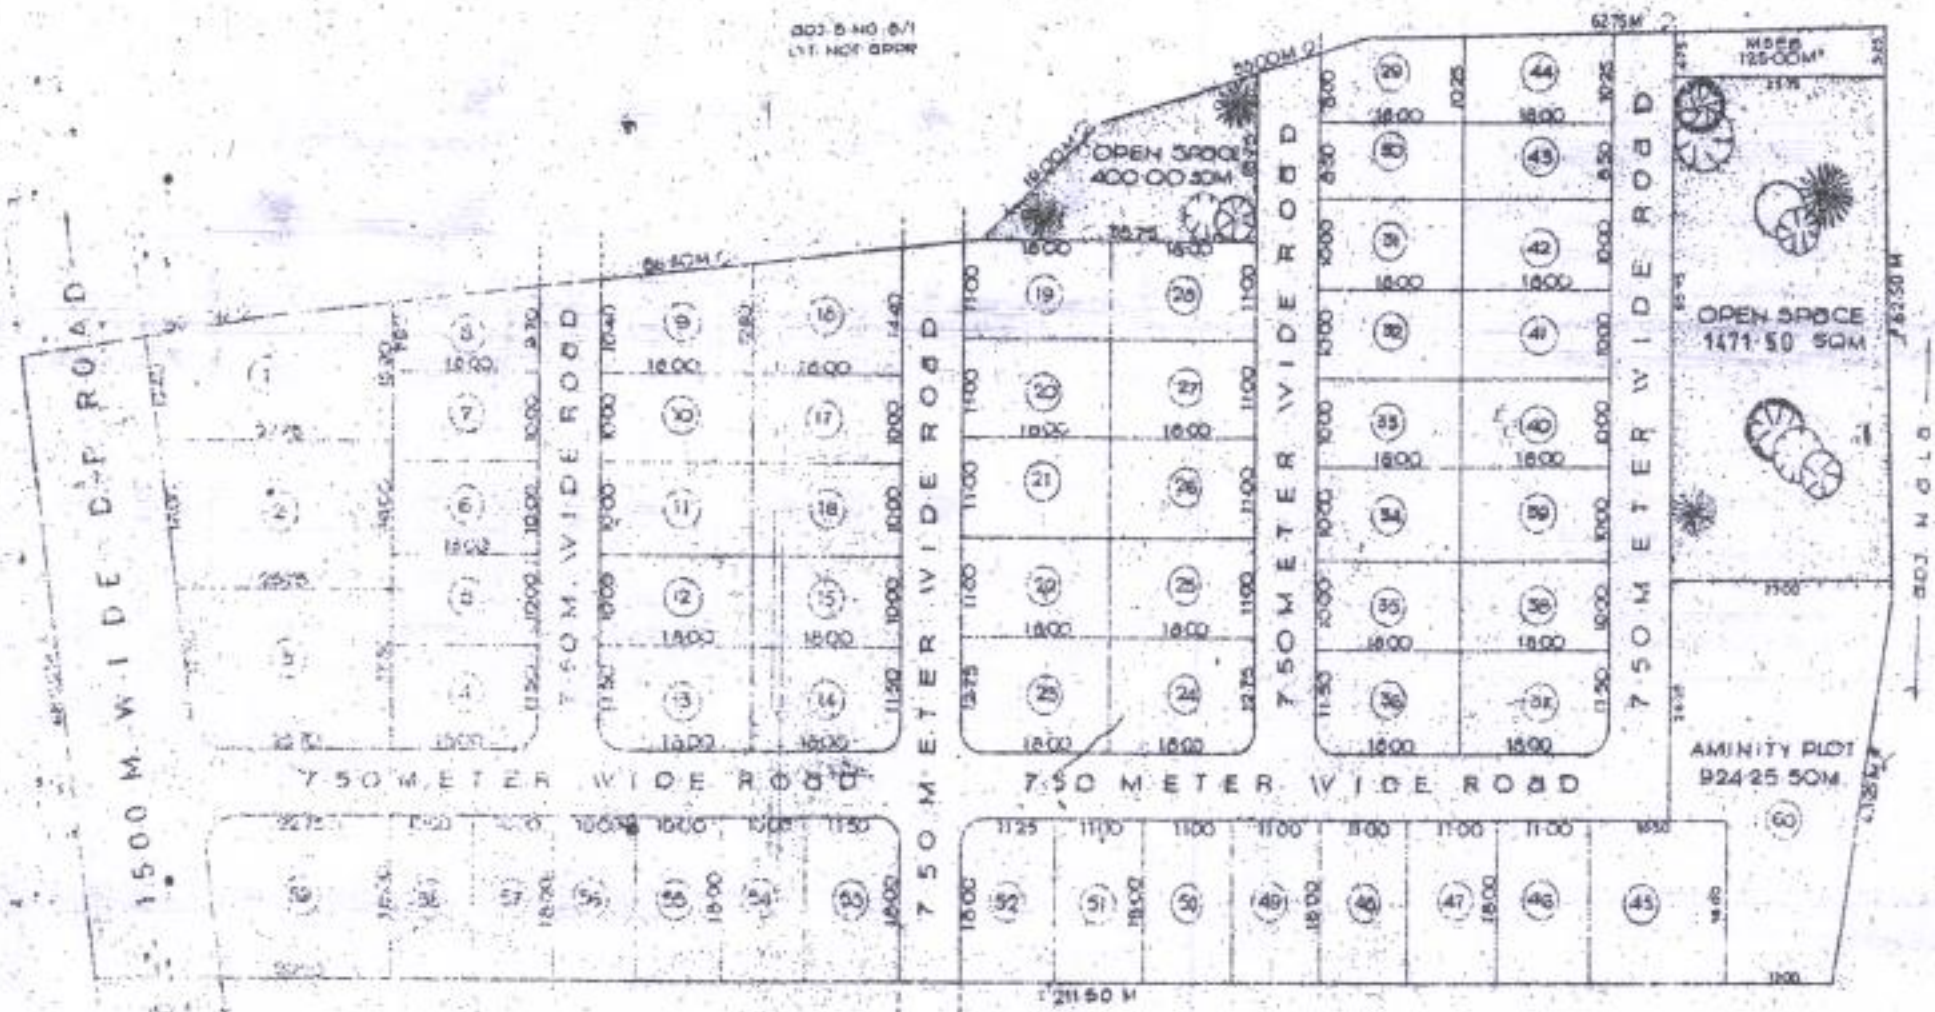

LAY OUT PLAN
Scale: 1:500

APPROVED
(Sealed and Signed) by the Local
Authority, Nashik, on 10/05/2008, Resolution
No. 100/2008, dated 10/05/2008, for the
proposed layout plan of the project.
Date: 10/05/2008
Signature: [Signature]
Official Stamp: [Stamp]
Scale: 1:10000

DEMARCATON CERTIFICATE
This is to certify that I have personally
demarcated this layout plan which is
submitted by Shri. Baburao B. Pansale, Nashik.
Date: 10/05/2008 and further
certify that the Plots, Roads & Open Space etc.
shown in demarcation plan are correctly on site.
Signature: [Signature]
Official Stamp: [Stamp]

AREA STATEMENT

AREA OF THE LAND AS PER 7/2-1/192000	12209.17 SQM
AREA UNDER LAYOUT	12209.17 SQM
AREA UNDER D.P. ROAD	1000.00 SQM
NET AREA UNDER LAYOUT	11209.17 SQM
AREA UNDER OPEN SPACE	1471.50 SQM
AREA UNDER AMINITY PLOT	924.25 SQM
AREA UNDER M.S.E.B.	120.00 SQM
AREA UNDER ROAD	1500.00 SQM
AREA UNDER PLOTS	12209.17 SQM

NOTES
1. All dimensions are in Meter.
2. Land boundary shown in Black.
3. Open Space shown in Green.
4. Amenity Plot shown in Pink.

**DEMARKETED FINAL
LAYOUT PLAN IN S.N.O. NO. 100/2008
AT MOKHAMALEBOD, NASHIK
FOR
SHRI. BABURAO B. PANSALE &
OTHERS
G.R. HOLDER, SHRI. H. A. HIRANI**

D. V. KATHE & ASSOCIATES
CONSULTING ENGINEERS & ARCHITECTS
OFF: 103, 104, 'SHRIKANT' BUILDING,
OPP. HOTEL 'SUNSHINE', WARD-MAN,
NASHIK-1. PH: 200111, 200112, 200113

JOB NO. - 8-69	DATE - 10/05/2008	DESIGN - H. A. HIRANI
REV. NO. -	SCALE - 1:500	DESIGN - H. A. HIRANI