


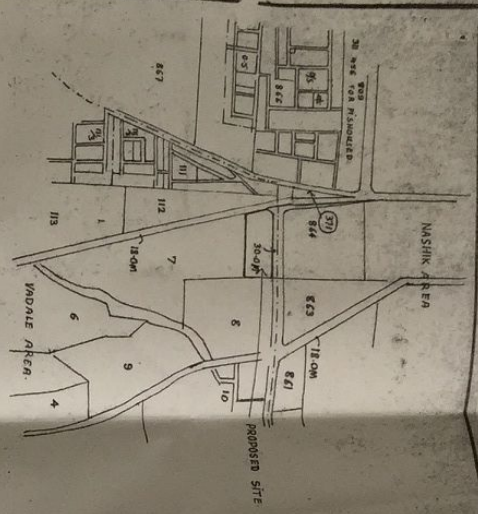


LOCATION PLAN SCALE 1:10000



NOTE
REVISED TENTATIVE LAYOUT IS APPROVED VIDE LT NO. LND/M/S/301/16.05/95 BY A.D.T.P. N.M.C. NASHIK

PLOTWISE AREA STATEMENT			
PLOT NOS	AREA IN SQ.M.	PLOT NOS	AREA IN SQ.M.
1	631.56	18	510.625
2,3	601.75	19	754.12
4 TO 8	601.25	20,21	238.00
9	603.25	22 TO 25	184.25
10	619.125	26,27	180.06
11, 12	239.687	28	142.375
13 TO 16	251.875	29	167.50
17	654.0		
		TOTAL	11862.29

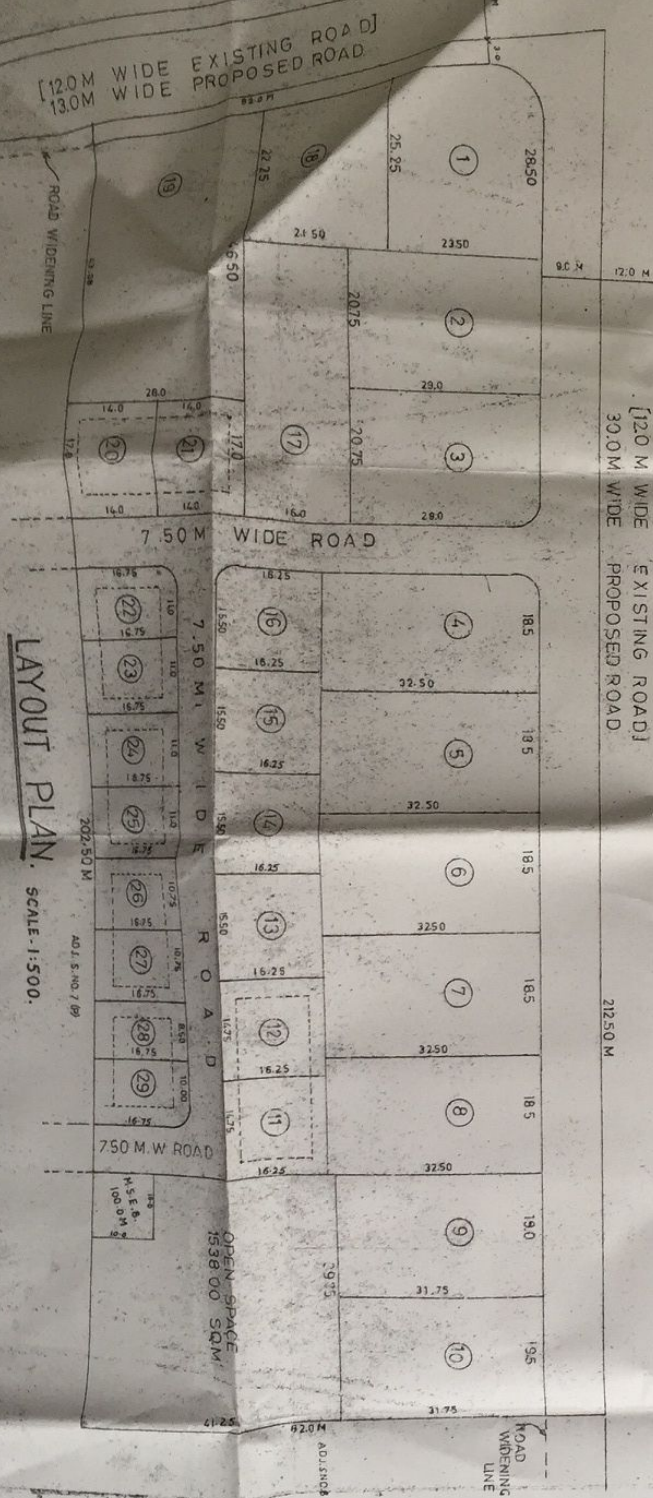

LAYOUT PLAN SCALE 1:500

APPROVAL

APPROVED
DEMARKATED FINAL LAYOUT AS PER
CONDITION MENTIONED IN THE LETTER
NO LND/WS/442 DTD 12.02.96 IN VIEW
OF SECTION 152(1) & 59 OF THE
MAHARASHTRA REGIONAL & TOWN
PLANNING ACT 1966

ASSISTANT DIRECTOR OF TOWN
PLANNING NASHIK MUNICIPAL
CORPORATION, NASHIK.

(KATALE G. V.)
ARCHITECT

DEMARKATION CERTIFICATE

THIS IS TO CERTIFY THAT I HAVE PERSONALLY
DEMARKATED THIS LAYOUT ON SITE WHICH WAS
APPROVED TENTATIVELY BY NASHIK MUNICIPAL CORPN.
VIDE LETTER NO LND/WS/53 DTD 16.05/95 AND FURTHER
CERTIFY THAT THE MEASUREMENTS OF PLOTS, OPEN SPACE,
ROADS ETC. ON SHOWN DEMARKATION PLAN ARE
ACTUALLY ON SITE.

ARCHITECT'S SIGN

NOTES

ALL DIMENSIONS ARE IN METER
LAND BOUNDARY SHOWN IN BLACK
OPEN SPACE SHOWN IN GREEN
ROAD WIDENING SHOWN IN RED DOTTED
ORIGINAL LAYOUT IS APPROVED VIDE LETTER NO
LND/WS/212 DTD 29/11/94

AREA STATEMENT

TOTAL LAND AREA	17500.00
AREA UNDER ROAD WIDENING	2131.50
NET AREA UNDER LAYOUT	15368.50
AREA UNDER OPEN SPACE	1538.00
AREA UNDER COLONY ROADS	1868.28
AREA UNDER PLOTS	11862.29
M.S.E.B. TRANSFORMER	100.00

DEMARKATED

FINAL LAYOUT PLAN ON S.NO. 7/1
AT VADALA TAL. & DIST. NASHIK
FOR SHRI B.C. SHAH & OTHERS
GPA HOLDER SHRI G.B. SHAH

ARCHITECTS SIGN OWNERS SIGN

G.V. KATALE & ASSOCIATES
CONSULTING ENGINEERS ARCHITECTS

8/5-8/54 SAMUK FIRST FLOOR
OPP. HOTEL PANCHWAT, VADALA
583224

JOB NO.	DATE	DRAWN
LIT 287	18-09-93	SUNIL KATHE
DWG NO.	SCALE	DECODED BY
A3	1500/10000	KATALE G.V.