




SITE
PLAN
SCALE
1" = 100'

(Demarcated Final) Layout as per
condition mentioned in the L.R.
No. LNT/3/44 dt 20/4/1955
in view of Section 19, (1) of
the Maharashtra Regional
and Town Planning Act 1966

Assistant Director
Town Planning, Nasik Municipal
Corporation, Nasik

Adj. H-NO 2

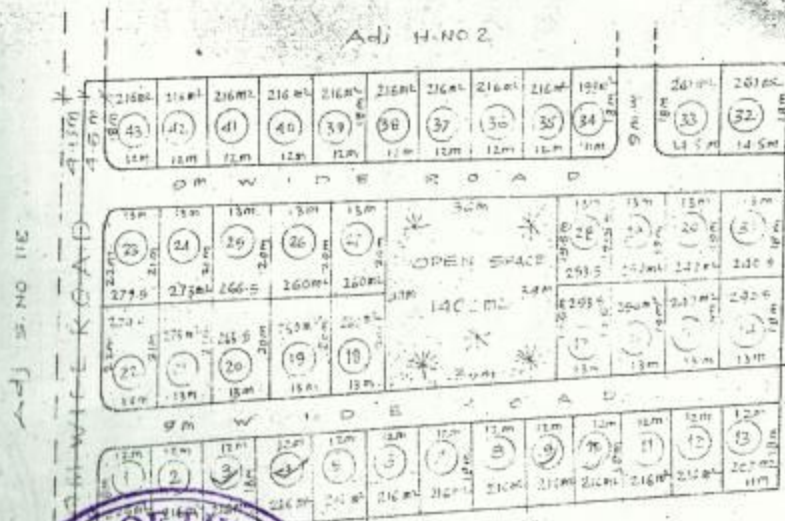

SCALE
1" = 100'

Handwritten text in a box: 'फा. 1/ 9928' and '20-1-55'.

TOTAL AREA OF LAND AS PER
7/12 ABSTRACT : 77800 M

AREA OWNED BY SHRI K.D. NAWALE
1/3 OF THE TOTAL AREA : 38900 M

AREA UNDER SURPLUS LAND : 24900 M

AREA UNDER RETAINED LAND
1/3 AREA UNDER LAYOUT : 14000 M

AREA UNDER PLOTS : 10132 M

AREA UNDER OPEN SPACE : 1402 M

AREA UNDER ROADS : 2466 M

LAYOUT BOUNDARY SHOWN IN RED
OPEN SPACE SHOWN IN GREEN

OWNER

THAKKERS

1516 BHADRAKALI

PHONE 75458

A S H I K

Demarcation Verified on Site

SHAYANI
ENGINEER

DEMARCATED LAYOUT PLAN OF S.NO. 119 OF 40500/1
H.NO. 1 (PART) AT ADGAON THE 3 DIST