




Plot Areas After Amalgamation	
Plot No.	Plot Area
(04+05+06+07)	- 1144.95 M ²

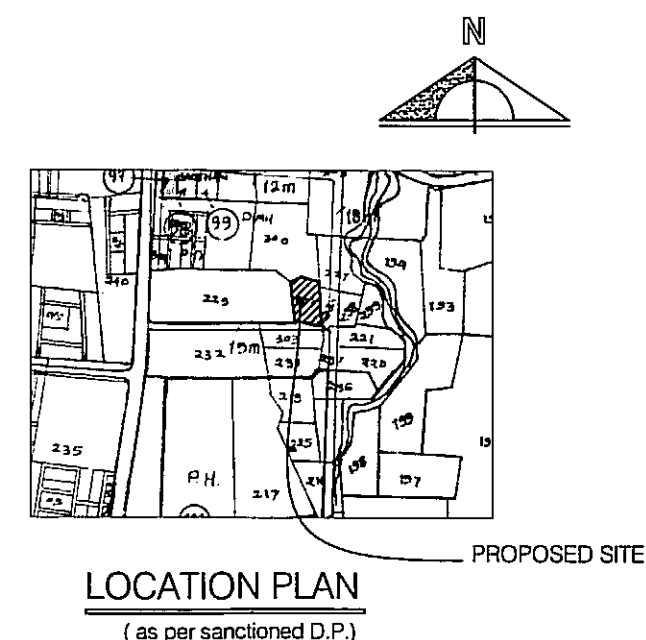

Proposed Amalgamation on Plot No. 4+5+6+7,
Survey No. 301 of Mhasrual Shiwar, Nashik for
Dhanait Ahire Associates thru' Partner
Shri. V. K. Dhanait & Shri D. M. Ahire

Approved For Amalgamations/Subdivision of Plots
as amended in Colour
As per Conditions Mentioned
in The Later No. NMC/ADTP/ 120 Date
C2/AML/58 09/03/2018

[Signature]
Assistant Director of Town Planning
Nashik Municipal Corporation
Nashik

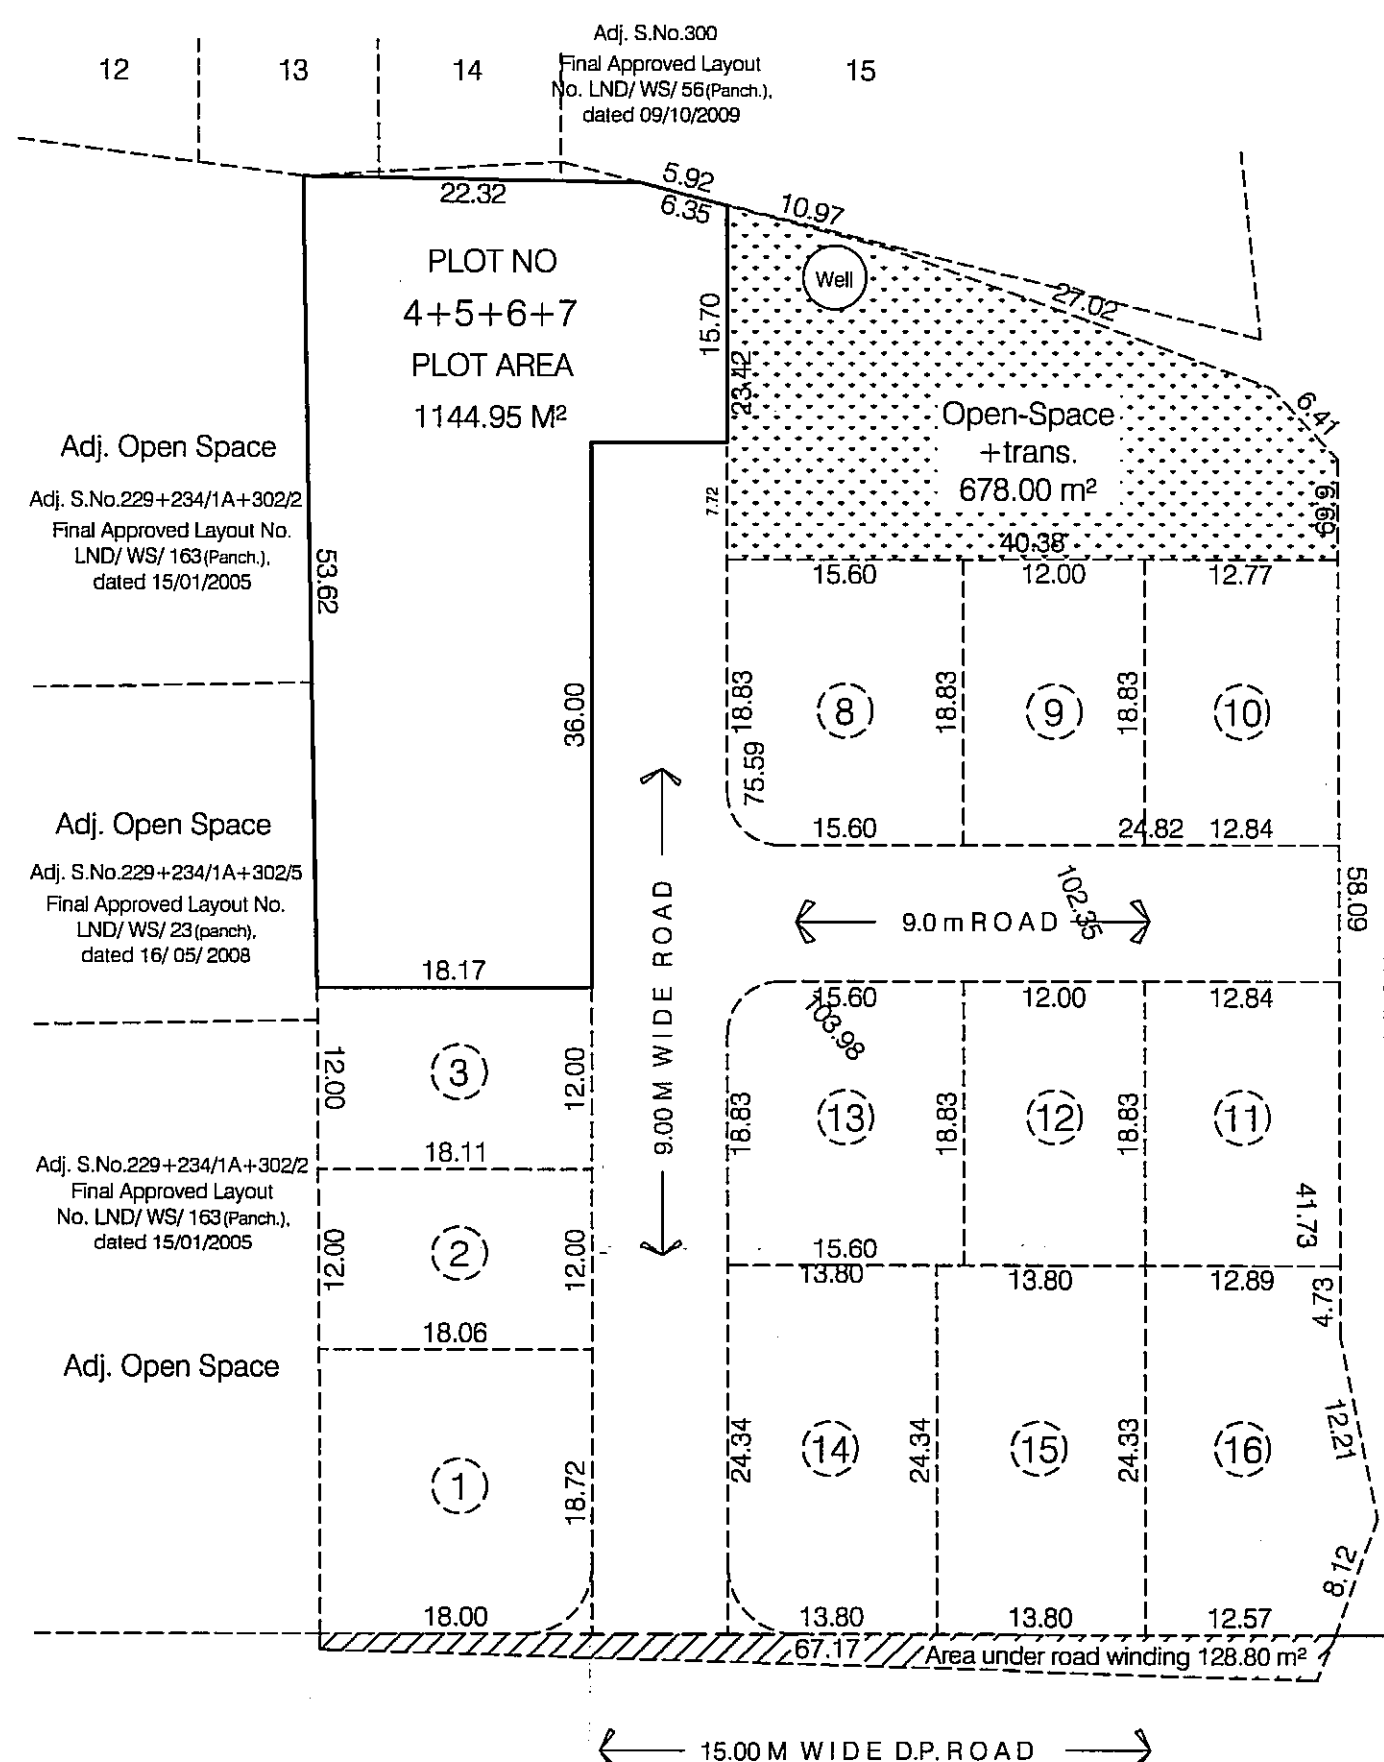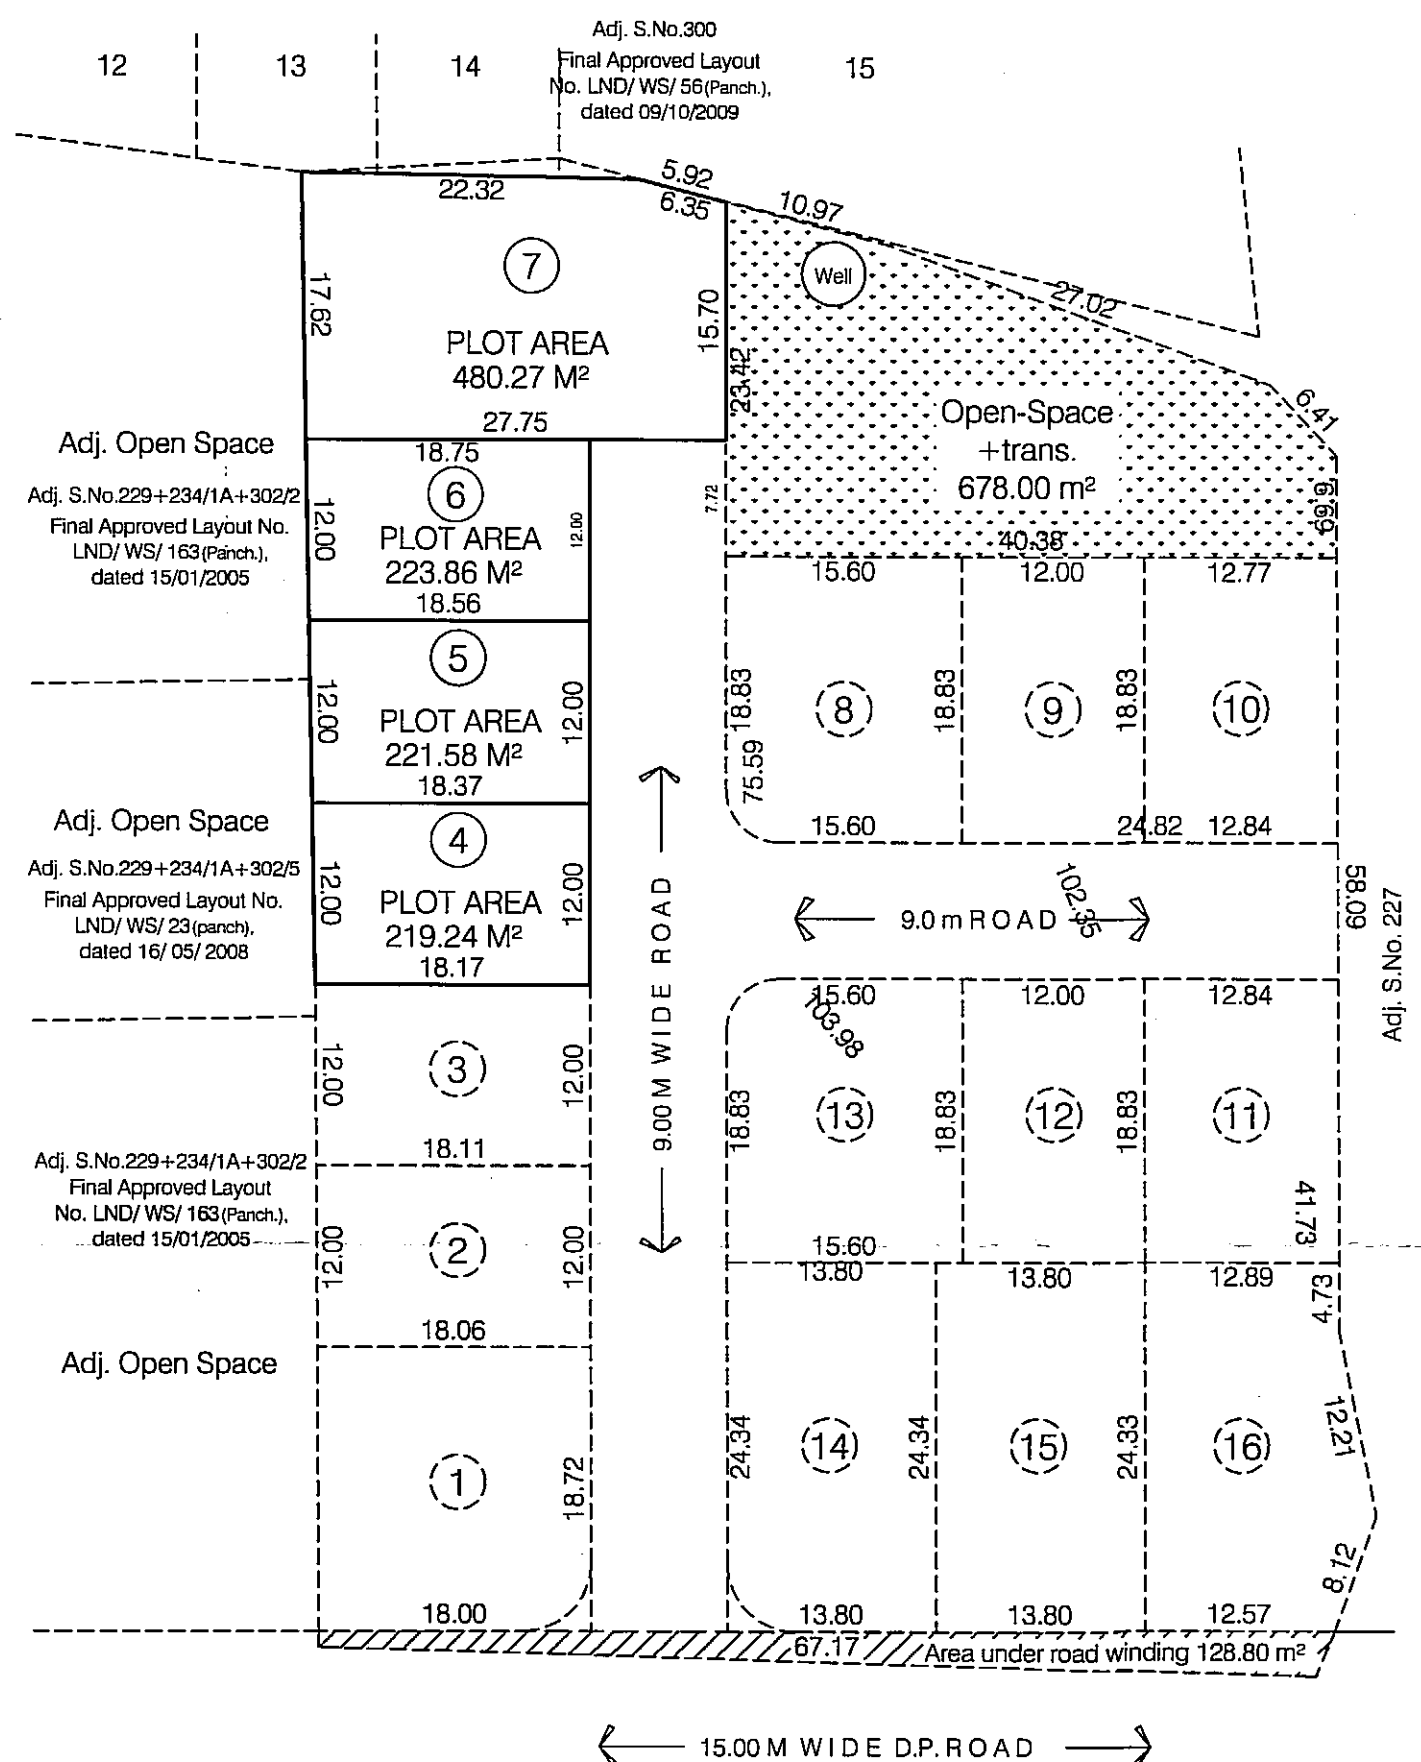

AREA STATEMENT

AREA BEFORE AMALGAMATION	
AREA of PLOT NO. 04	- 219.24 m ²
AREA of PLOT NO. 05	- 221.58 m ²
AREA of PLOT NO. 06	- 223.86 m ²
AREA of PLOT NO. 07	- 480.27 m ²
AREA AFTER AMALGAMATION	
AREA of PLOT NO. 4+5+6+7	- 1144.95 m ²
NOTES	
LAND BOUNDARY SHOWN IN BLACK	
OPEN SPACE SHOWN IN GREEN	
ALL DIMENSIONS ARE IN METER	

CERTIFICATE OF AREA

Certified that the plot under reference was surveyed by me on 18.09.2017 & dimensions of all sides etc. of plot stated on plan are as measured on site and the area so worked out tallies with the area stated in document of ownership / T.P. Act.



[Signature]
Er. Vijay K. Sanap.
Regd. No. 115 (NMC)

<i>[Signature]</i>	<i>[Signature]</i>
Signature of Engineer	Signature of Owner
DEALT : Ravi Pawar	DRG. NO. :
CHECKED : Vijay Sanap	M 1.1
SCALE : as shown	JOB NO. : SVS/11/400/D
DATE : 12.02.2018	

PLOTS BEFORE AMALGAMATION
(scale - 1:500)



PLOTS AFTER AMALGAMATION
(scale - 1:500)

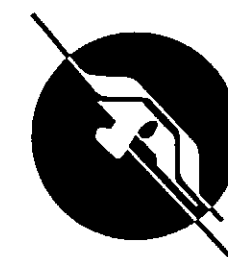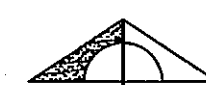

SOHAM
Architectural
Engineering
Services

CONSULTANCY, DESIGN, ENGINEERING, PROJECT MANAGEMENT
34/35, Surkaan Arcade, Behind HDFC Bank, Bhujbal Farm Road, New Nashik-9,
e-mail: vijay.sanap@sohamaes.com, Phone: 0253 3204080 Cell: 098220 20996