


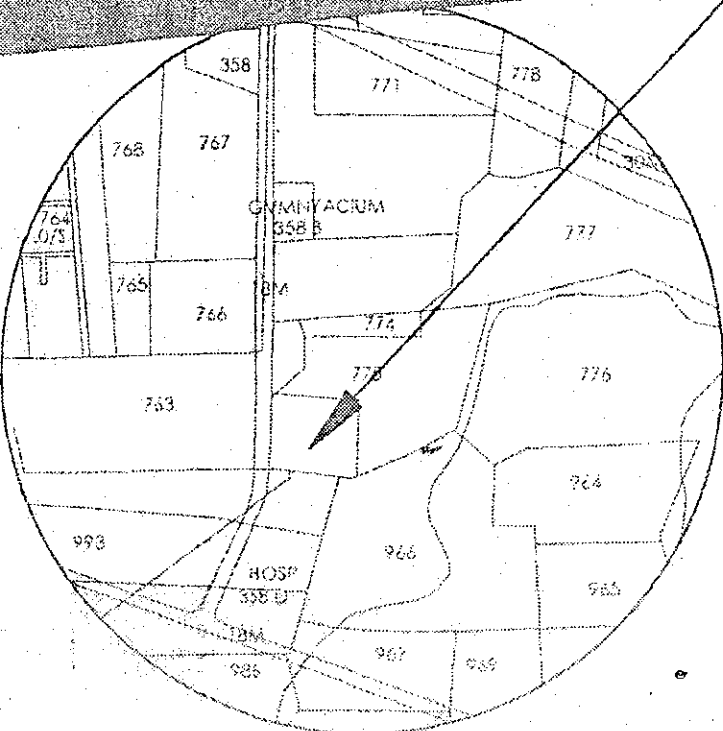


LOCATION PLAN
[SCALE 1:10,000] D.P. PAGE No. 11

PLOT AREA STATEMENT

PLOT Nos.	AREA IN SQM	PLOT Nos.	AREA IN SQM
1	1032.25	6	486.09
2	1119.65	7	506.28
3	621.07	8	647.04
4	343.82	9, 10, 11	373.50
5	903.12	12	393.16
TOTAL AREA = 7172.98 SQM.			

NOTES :-

- ① ALL DIMENSIONS ARE IN METER
- ② LAND BOUNDARY SHOWN IN BLACK
- ③ OPEN SPACE SHOWN IN GREEN

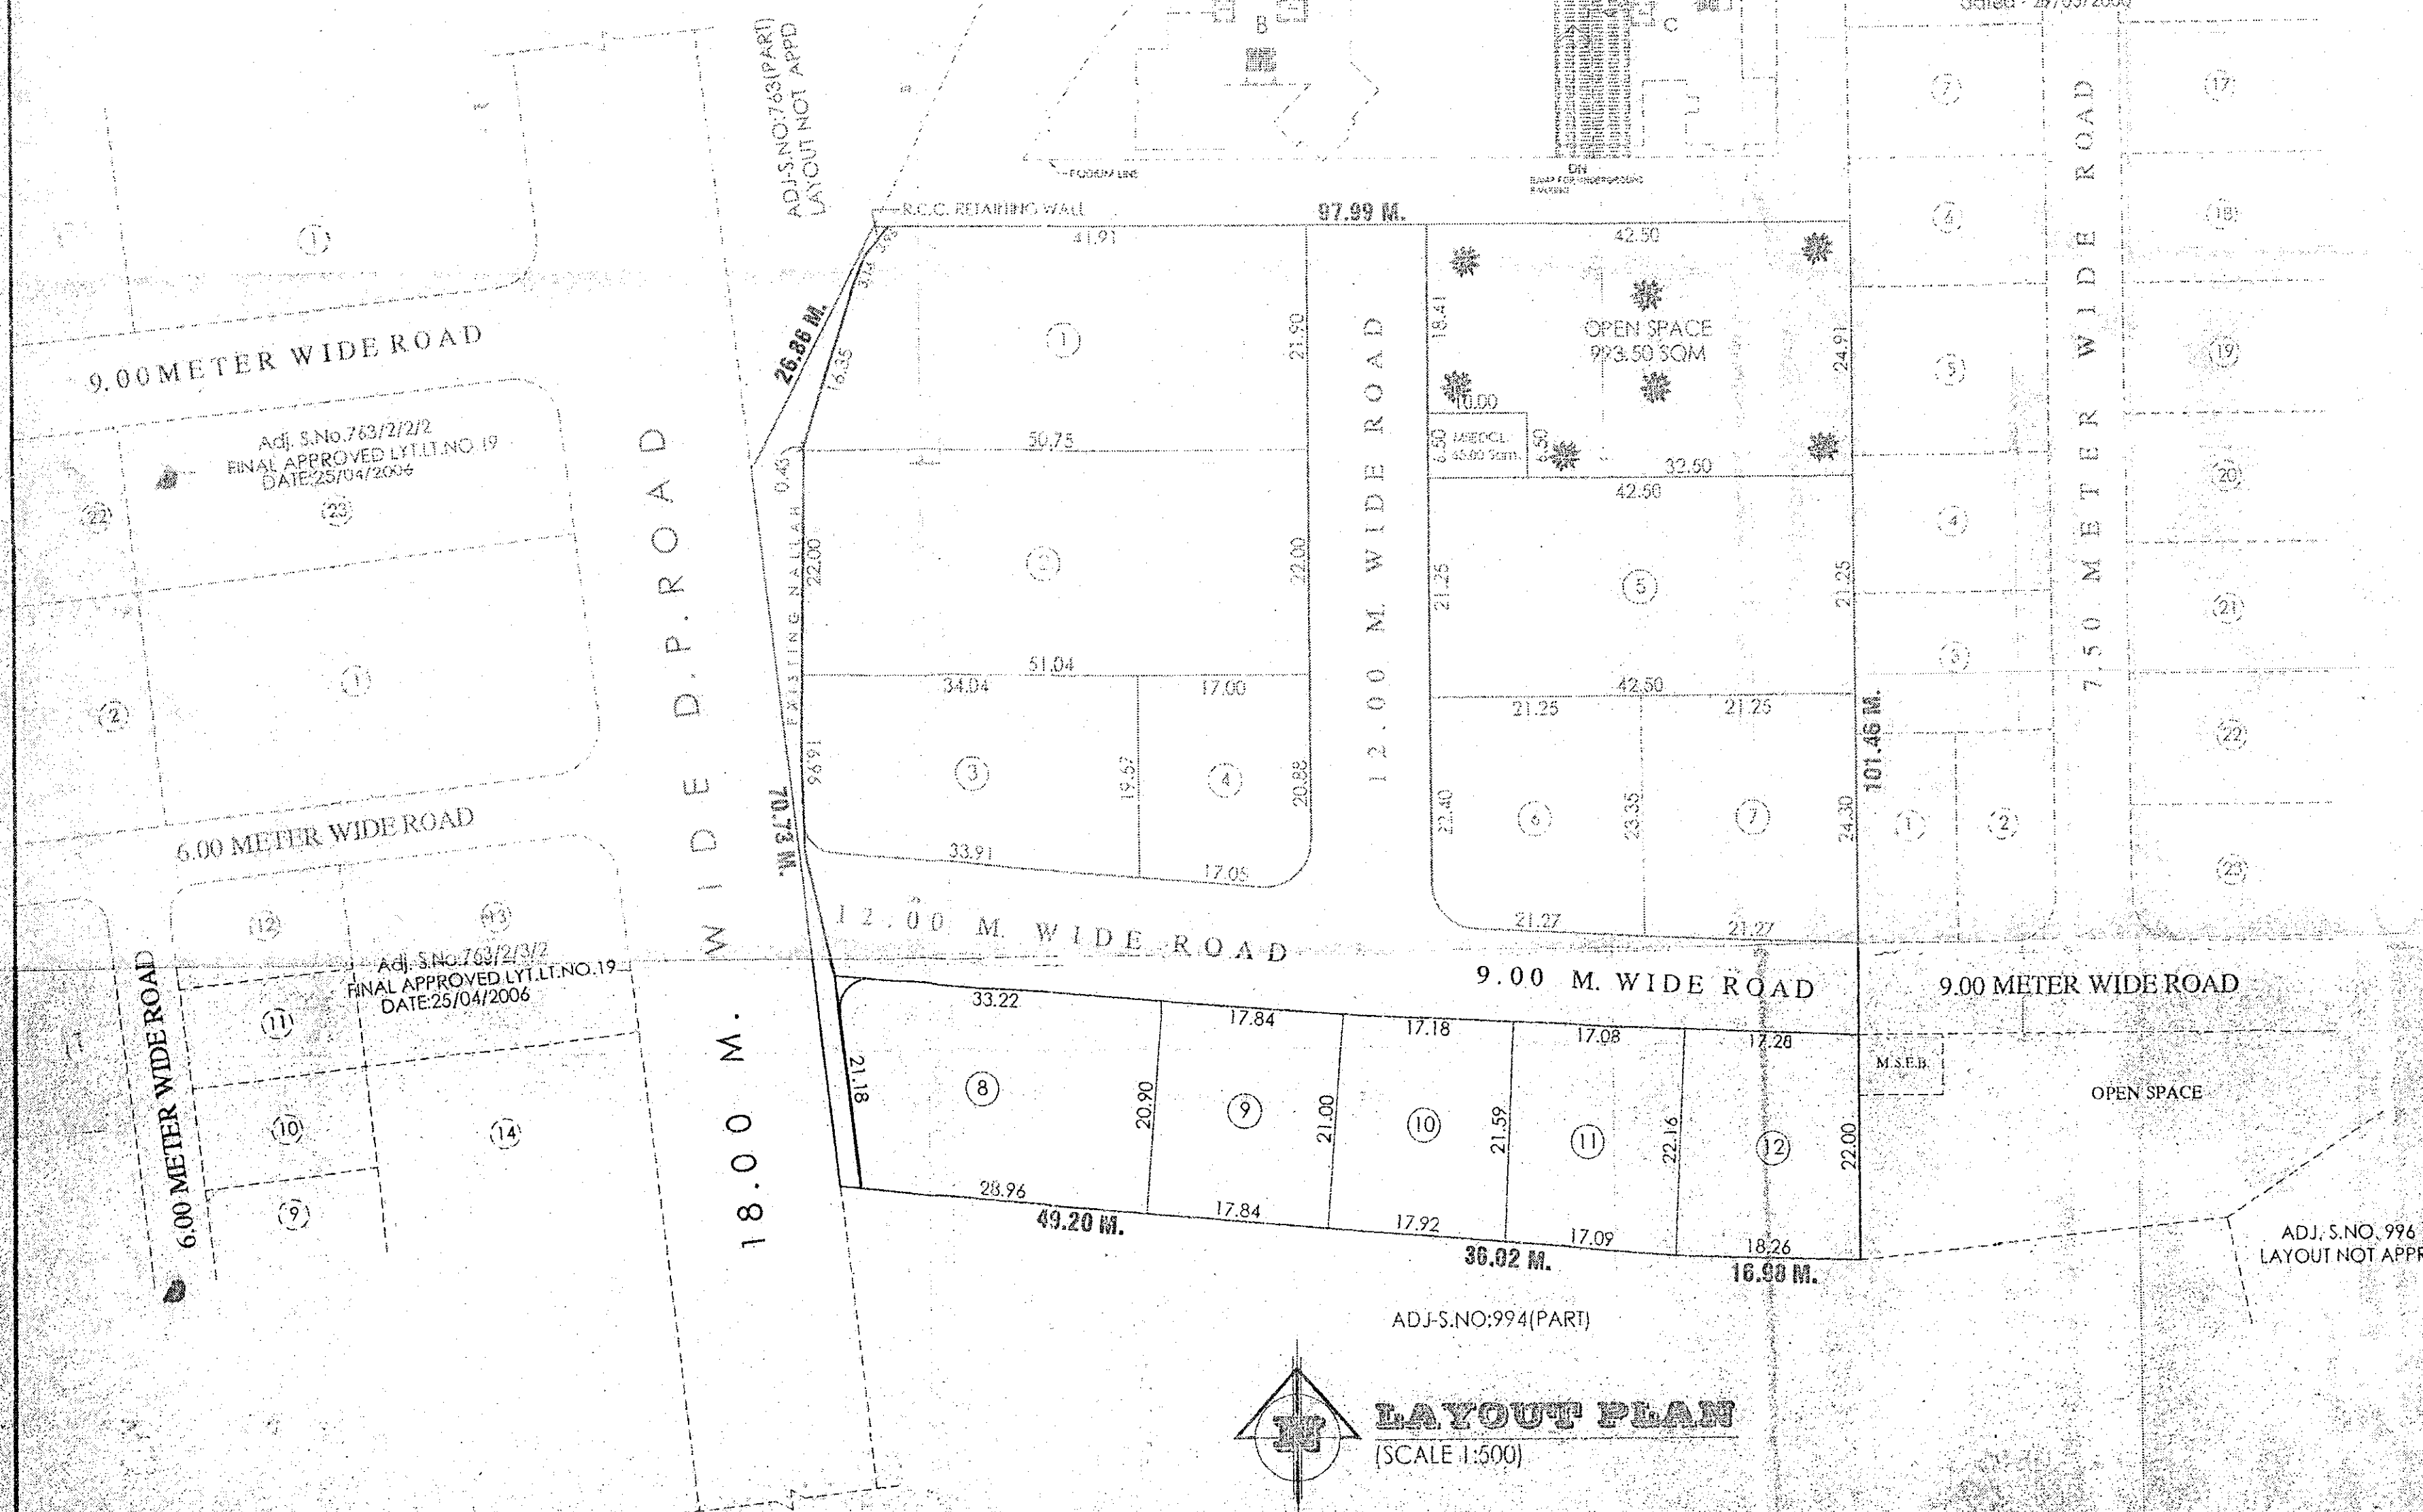

ADJ-S.NO:994(PART)

LAYOUT PLAN
[SCALE 1:500]

APPROVAL

APPROVED

(Demarcated Final) Layout as per Conditions. Mentioned in the letter No. LND/WS/B-3/18, dated 10/07/2012 View of Section 152 (13) and 69 of the Maharashtra Regional and Town Planning Act 1966.

Sd /- x-x-x

Assistant Director of Town Planning
Nashik Municipal Corporation
Nashik

TRUE COPY
[Signature]

DEMARCATION CERTIFICATE

THIS IS TO CERTIFY THAT I HAVE PERSONALLY DEMARCATED THIS LAYOUT WHICH IS TENTATIVELY APPROVED BY NASHIK MUNICIPAL CORPORATION, NASHIK VIDE LETTER NO. TPD/CD/06, DATED-17/04/2010 AND FURTHER TO CERTIFY THAT THE MEASUREMENTS OF PLOTS, ROADS AND OPEN SPACE ETC. SHOWN IN DEMARCATION PLAN ARE ACTUALLY ON SITE.

ARCHITECT'S SIGN

AREA STATEMENT

AREA IN SQM.

1) AREA OF THE LAND (AS PER 7/12)	11500.00
2) AREA OF THE LAND (AS PER T.L.R.)	10170.00
3) AREA UNDER NALLAH	235.00
4) NET AREA DEVELOPMENT (LAYOUT)	993.50
5) AREA UNDER OPEN SPACE	993.50
6) AREA UNDER M.S.E.D.C.L.	65.00
7) AREA UNDER ROADS	1703.52
8) AREA UNDER PLOTS	7172.98

DEMARCATED RESIDENTIAL FINAL LAYOUT PLAN IN S.No.775/4 OF NASHIK SHIWAR IN NASHIK FOR

- A) MR.NAZIMODDIN A.S.KOKANI & OTHERS-4 G.P.A.H.FOR SELF OTHERS MR. ABDULKADIR A.S. KOKANI
- B) MR.GULAMKHAJA A.S. KOKANI & OTHERS-2

(A) MR. NAZIMODDIN A.S. KOKANI G.P.A.HOLDER MR.ABDULKADIR A.S. KOKANI	(B) MR. GULAMKHAJA A.S. KOKANI
(C) MRS. FARUKA I.A. KOKANI	(D) MRS. HUSNA B. G. KOKANI

OWNER SIGN

[Signature]
AR. SHRI G.V. KATALE
ARCHITECT SIGN



G.V. KATALE AND ASSOCIATES
CONSULTING ENGINEERS & ARCHITECTS

OFFICE - 01, KAMAL RESIDENCY,
PATIL LANE NO. 4, COLLEGE ROAD, NASHIK-5.
PH. (0) 2580928, 2579927
Email : gv.katale@shy.com

ACCESS KEY : D:\NASHIK\S.NO.775/PART	DATE : 26 April 2012	CHKD BY : KATALE G.V.
DRG. REF. : AS PER P.1 SHEET	SCALE : 1:500	DRN. BY : S