


PLOT AREA STATEMENT

PLOT NO.	AREA sqm.	PLOT NO.	AREA
1	217.41	11	427.53
2	209.78	12	245.30
3	209.78	13	245.92
4	209.78	14	249.93
5	250.51	15	254.60
6	231.19	16	262.11
7	200.24	17	265.13
8	200.24	18	268.14
9	200.24	19	324.20
TOTAL	2100.70		4643.56 sqm.

PROPOSED SITE

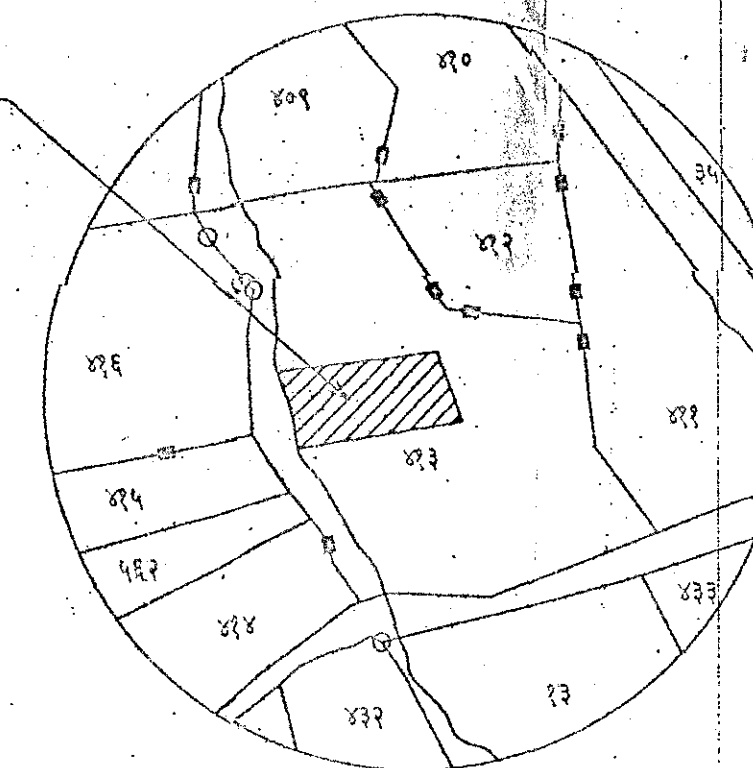

LOCATION PLAN N
SCALE 1:10000

APPROVING AUTHORITY

DEMARKED FINAL

LAYOUT AS PER CONDITIONS MENTIONED IN THE ACCOMPANYING LETTER NO. PANCH/2/1/10/2013 DATED 11/10/2013
VIEW OF SECTION 152 (13) AND 69 OF MAHARASHTRA REGIONAL AND TOWN PLANNING ACT 1955

SD/XXX
ASSISTANT DIRECTOR OF TOWN PLANNING
NASHIK MUNICIPAL CORPORATION, NASHIK

AREA STATEMENT

1) PARTICULAR	SQM.
2) AREA OF S. NO. 413/1B/1 (AS PER 7/12)	15000.00
3) AREA OF NOT FOR DEVELOPMENT	8265.13
4) AREA UNDER PROPOSED LAY-OUT (AREA ON MEASURED ON SITE)	6734.87
5) AREA UNDER NALA	407.84
7) NET AREA UNDER LAY-OUT (4-5)	6327.03
8) AREA UNDER OPEN SPACE 10%	632.70
9) AREA UNDER M.S.E.B.	39.00
10) AREA UNDER COLONY ROAD	1011.77
11) AREA UNDER PLOT	4643.56

*DEMARCATON CERTIFICATE

THIS IS TO CERTIFY THAT I HAVE PERSONALLY DEMARCATED THIS LAY-OUT WHICH WAS TENTATIVELY APPROVED BY NASHIK MUNICIPAL CORPORATION VIDE LETTER NO. LND/WS PANCHAVATI TPD-82 DT. 02/11/2001 AND FURTHER CERTIFY THAT THE MASUREMENTS OF PLOTS, ROADS AND OPEN SPACE ETC. SHOWN IN DEMARCATON PLAN ARE ACTUALLY ON SITE.

SIGN. OF LIC. ENGINEER'S / ARCHITECT'S

*NOTES

- * LAYOUT BOUNDARY SHOWN IN THICK BLACK.
- * OPEN SPACE SHOWN IN GREEN COLOUR
- * M.S.E.B. ELECT. TRFM. SHOWN IN YELLOW
- * ALL DIAMENTIONS ARE IN METER.

DEMARCATED FINAL LAY-OUT IN G.NO. 413/1B AT VILLAGE MAKHAMALABAD TAL. DIST. NASHIK.
FOR. SHRI. TAMBE R.P. & OTHER ONE


1) अल्लर. पो. ताल्ले
2) अल्लर. पो. ताल्ले

SIGN. OF ENGINEER'S (CONSULTING ENGG. NMC 214/99) (STRUCTURAL ENGG. NMC 77/01) SIGN. OF OWNER

SUNIL BHOR & ASSOCIATES
CONSULTING ENGINEERS & BUILDING PLANNERS

65/1A-WING SECOND FLOOR MARKET SHOPPING COMPLEX OFF PANCHAVATI POLICE STATION, DINDORI ROAD, NASHIK - 422003, PH. NO. 2518288

CADD. BY	CHD. BY	SCALE	DATE	JOB NO.
SUNIL KHAIRNAR	SUNIL BHOR	1:500	03/07/2013	615

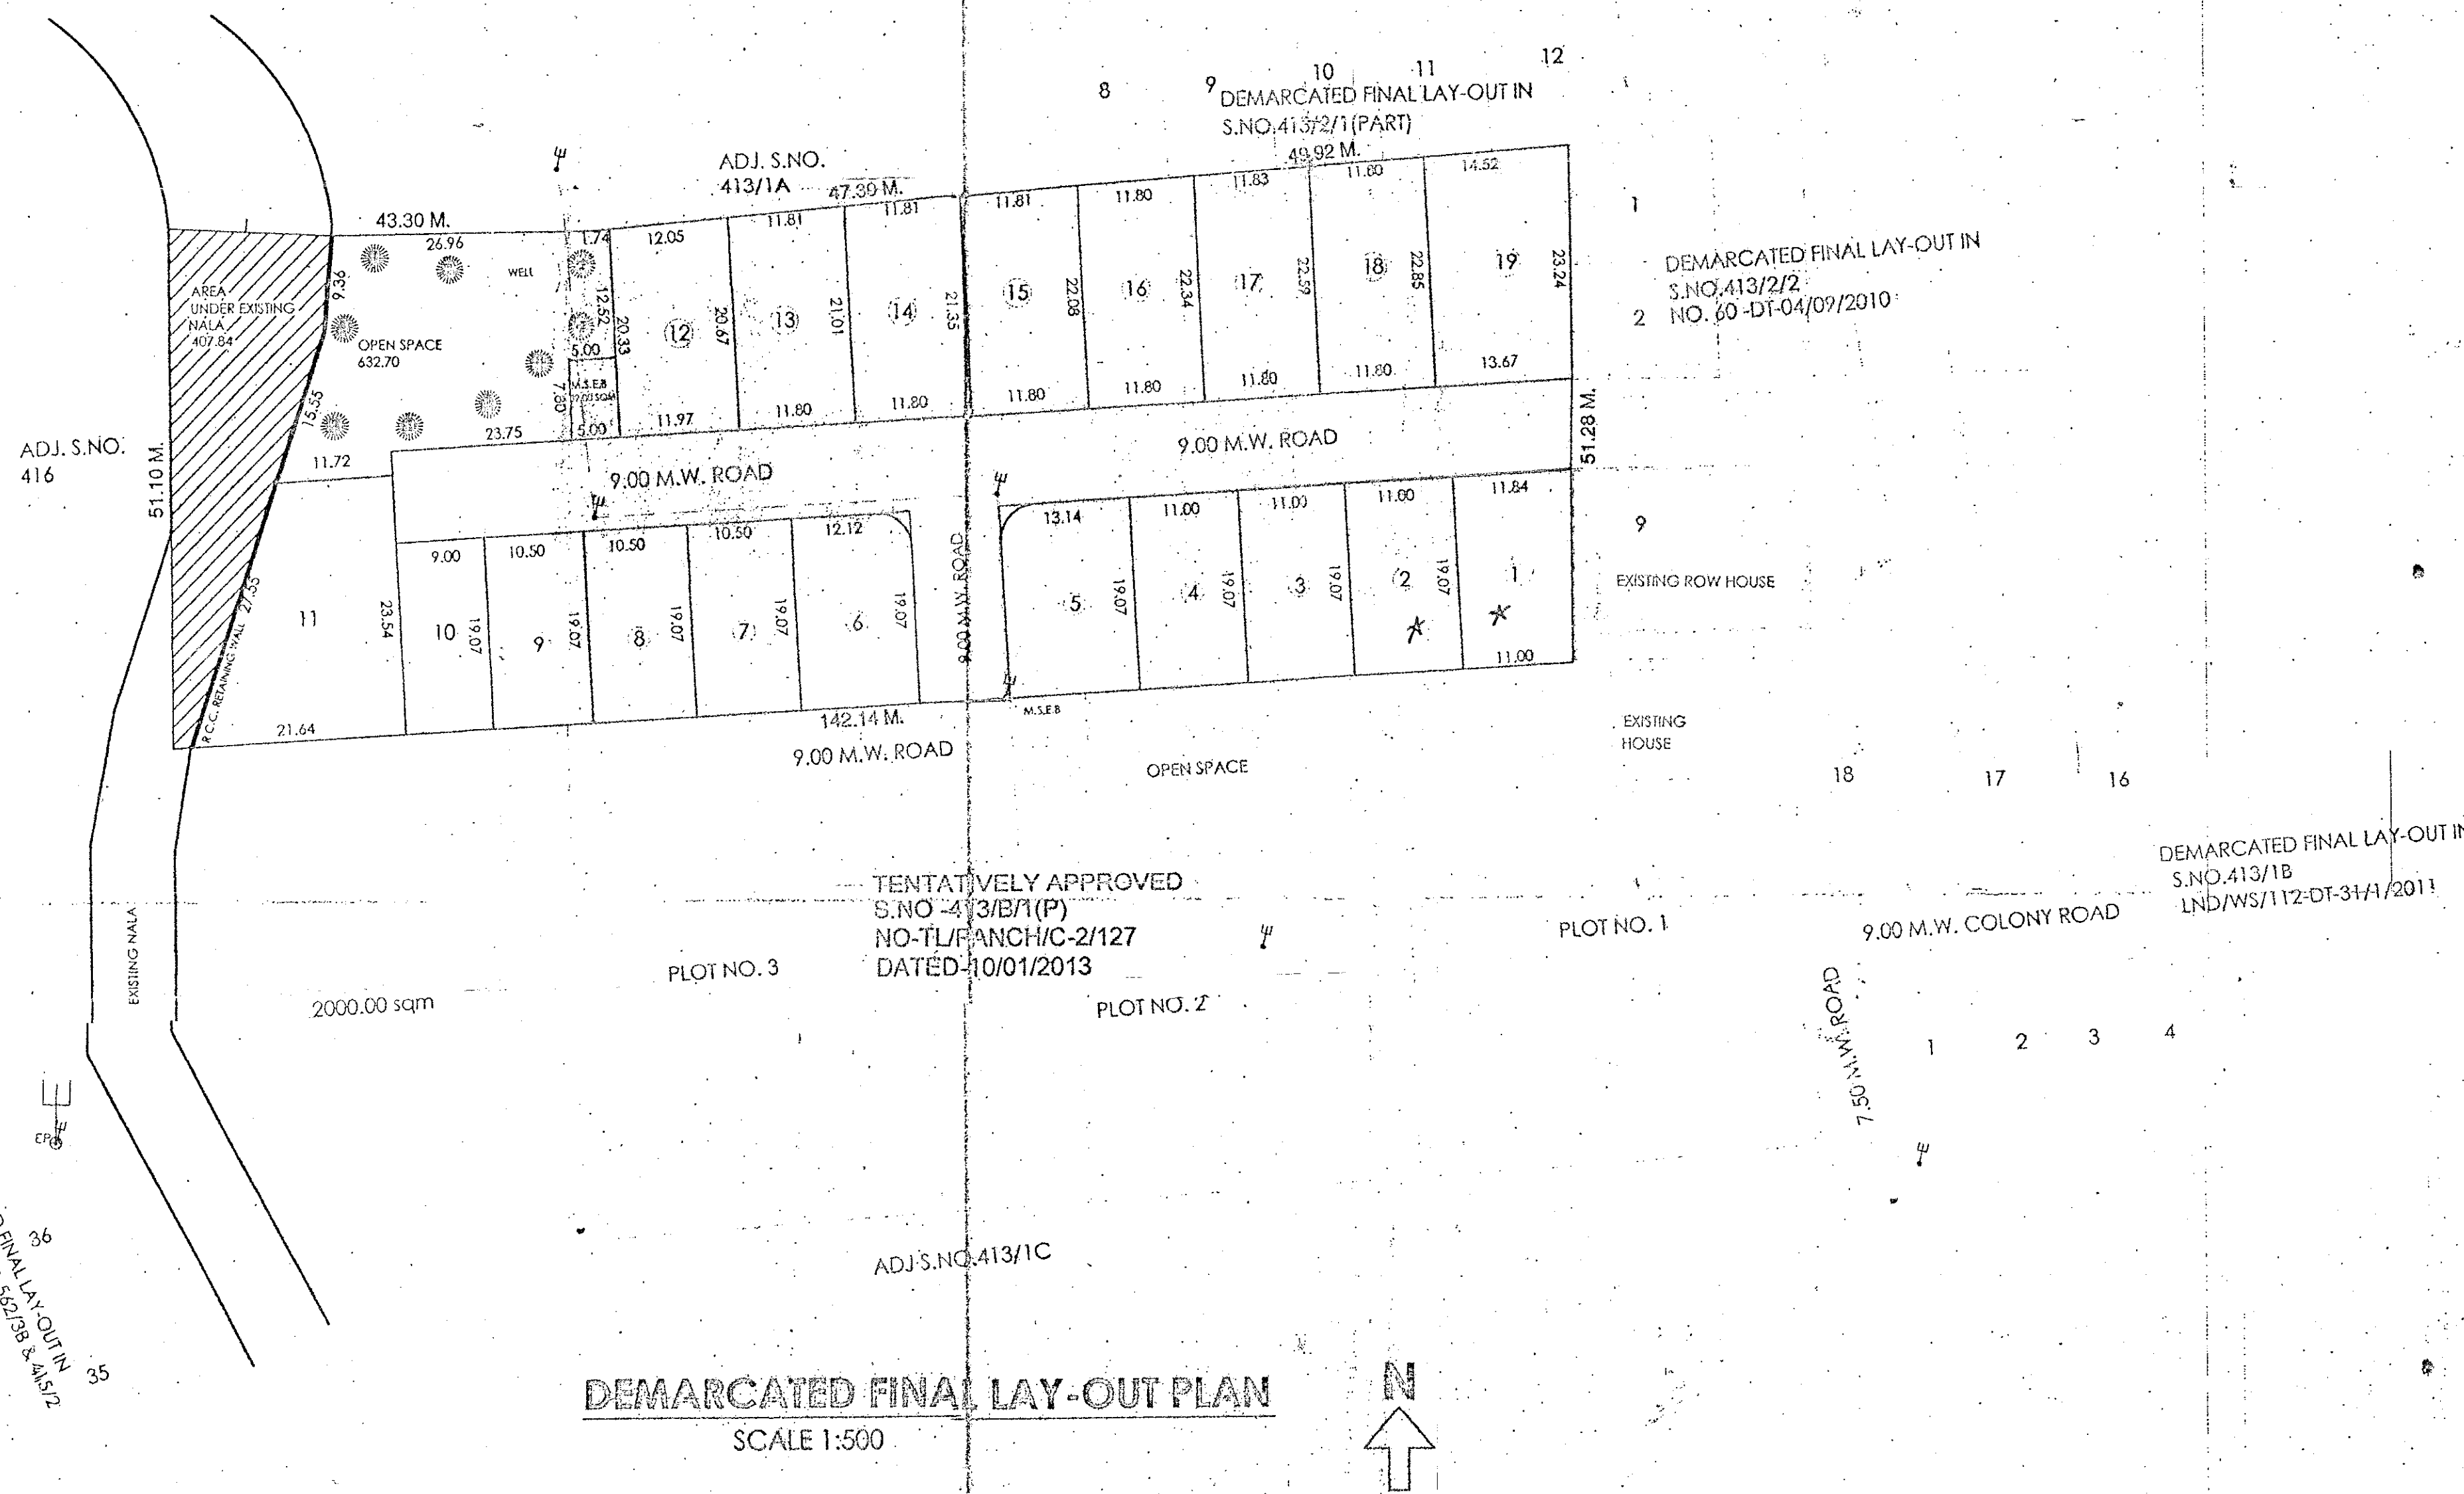

DEMARCATED FINAL LAY-OUT PLAN
SCALE 1:500