



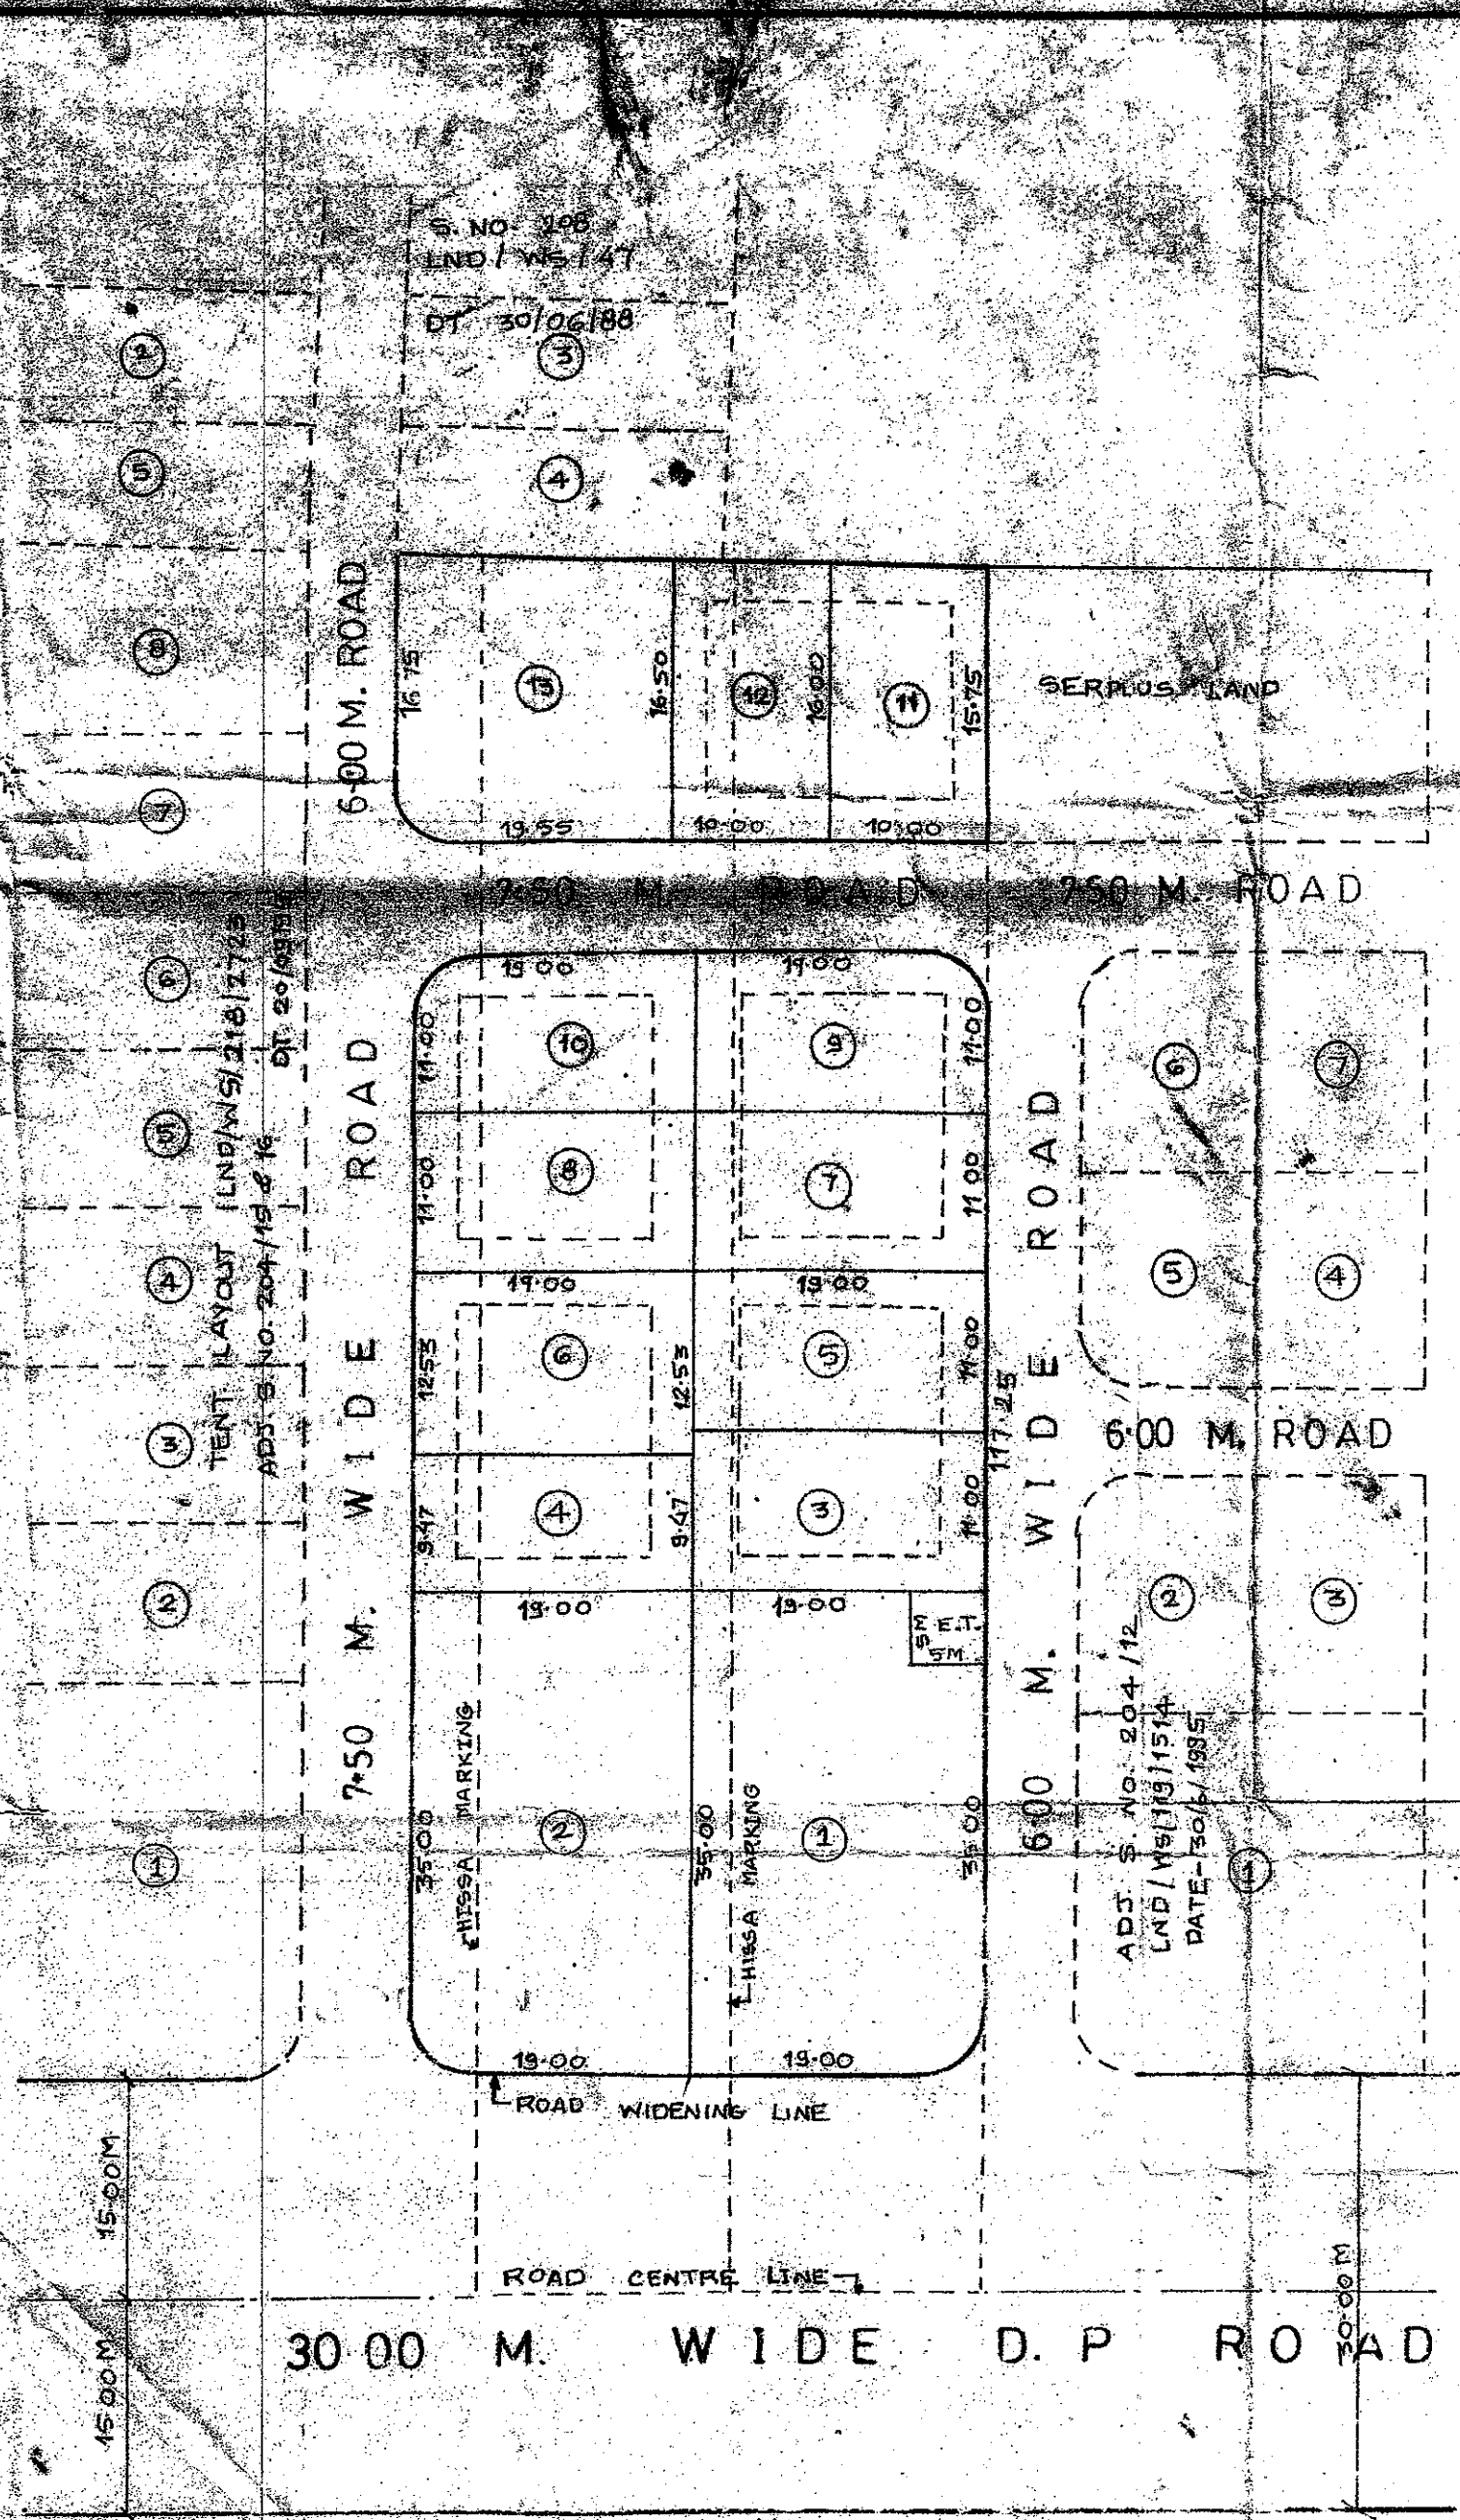

DEMARCATED LAY-OUT PLAN

SCALE: 1:500

AREA STATEMENT OF PLOTS			
PLOT NO.	PLOT AREA IN SQ.M.	PLOT NO.	PLOT AREA IN SQ.M.
1	640.00	8	209.00
2	665.00	9	209.00
3	209.00	10	209.00
4	180.00	11	158.75
5	209.00	12	162.50
6	128.00	13	115.00
7	215.00	TOTAL	2412.25 SQ.M.

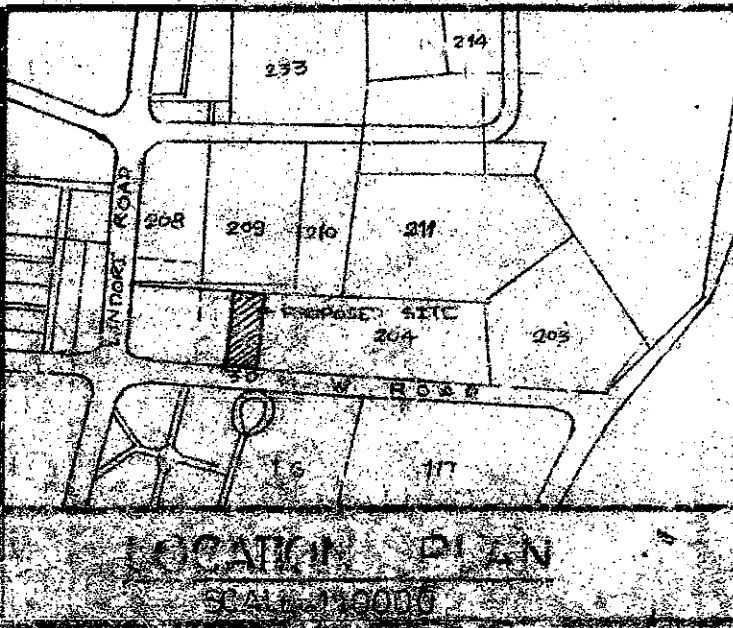

APPROVING AUTHORITY

(DEMARKTED- FINAL) LAYOUT AS PER CONDITIONS MENTIONED IN THE LETTER NO LND/WS/448-5157 DT. 8/2/1996 IN VIEW OF SECTION 152 (13) & 69 OF THE MAHARASHTRA REGIONAL AND TOWN PLANNING ACT 1966

ASSISTANT DIRECTOR OF TOWN PLANNING
NASHIK MUNICIPAL CORPORATION
NASHIK.

DEMARICATION CERTIFICATE

TO WHOM SO EVER IT MAY CONCERN

THIS IS TO CERTIFY THAT THE LAYOUT OF S NO 204/13 & 14 ON DINDORI ROAD AT MHASRUL NASHIK WHICH WAS APPROVED TENTATIVELY BY NASHIK MUNICIPAL CORPORATION NASHIK WIDE THEIR ORDER NO LND/WS/236/2868 DT 28-9-1995 HAVE VERIFIED THE DEMARICATION ON 25-10-1995 OF THE PLOTS 1 TO 13 FROM AND OUT OF AFORSAID LAY-OUT.

A. J. BHAYANI

AREA STATEMENT

AREA IN SQ. M

AREA BEARING S.NO. 204/13 & 14 AS PER 7/12 (2025+2025)	4050.00
S.NO. 204/15 & 16 UNDEVELOPABLE LAND AREA	
LND/WS/218/2723 DT- 20-09-1995	364.10
TOTAL AREA OF LAND	4414.10
AREA UNDER 30.00 MTS. ROAD WIDENING	510.90
REMAINING AREA UNDER LAY OUT	3903.20
AREA UNDER PLOTS	3623.25
AREA UNDER COLONY ROAD	254.95
AREA UNDER M. S. E. B. TRANSFORMER	25.00

NOTE

DEMARCATED LAY-OUT BOUNDARIES SHOWN IN RED.
PROPOSED D. P. ROAD SHOWN IN BROWN.

DEMARCATED LAY-OUT PLAN OF S.NO. 204/13 & 14 ON DINDORI ROAD AT MHASRUL - NASHIK. FOR MRS. B. PAGARE & OTHERS THREE. MRS. D. M. BACHAV.

OWNER SIGNATURE
(THROUGH G. R. A. HOLDER)

A. J. BHAYANI
ARCHITECTS &
ENGINEERS
NASHIK

THAKKERS'
7. THAKKERS,
NEAR NEHRU GARDEN,
NASHIK - 422 001
PH. 75458, 79125

DRG NO	SCALE 1:500	CHECKED BY
JOB NO	DATE	DRAWN