


As per order NO. B/15 Dt- 27/7/2018
for Road widening are handover

Assistant Director of Town Planning
Nashik Municipal Corporation
Nashik

PLOT NO = 18
PLOT AREA (m²) = 303.95
R/W AREA (m²) = 11.91
Net PLOT AREA = 292.04

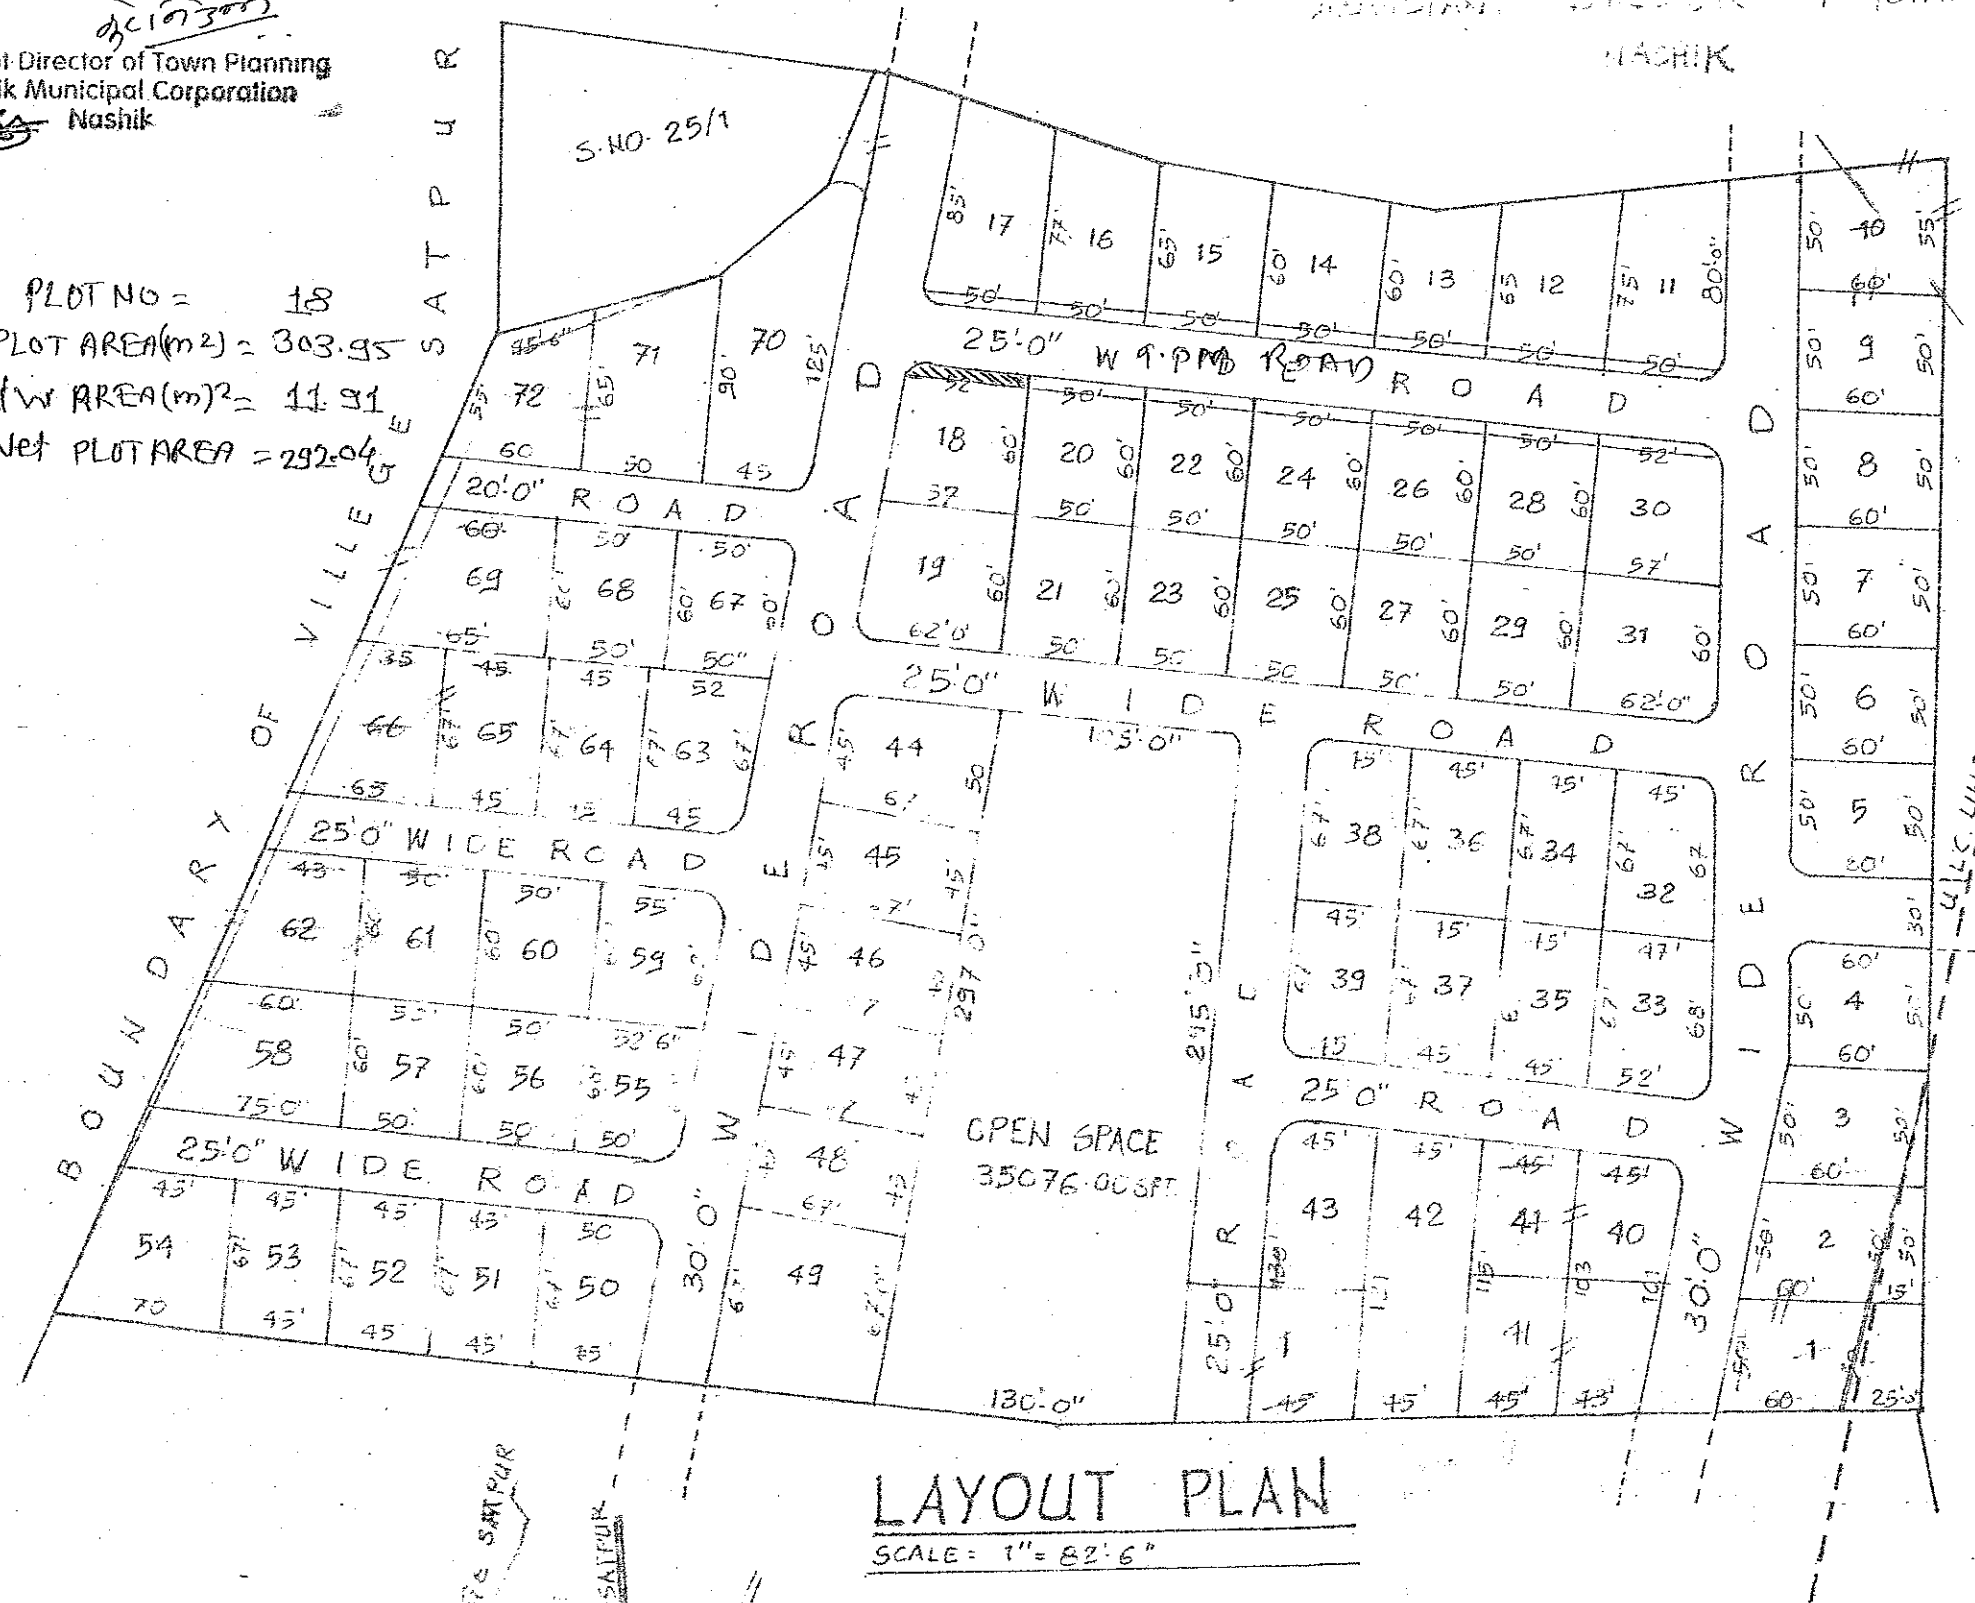

LAYOUT PLAN
SCALE: 1" = 62.5'

AREA STATEMENT :

AREA OF LAND	S. NO. 25/2 = 5600.00 SQM.
	S. NO. 25/3 = 2200.00 SQM.
	S. NO. 25/4 = 2100.00 SQM.
	S. NO. 25/1 = 4500.00 SQM.
	S. NO. 25/6 = 18000.00 SQM.
TOTAL AREA OF LAND	= 32400.00 SQM.
	= 3,48,559.20 SQ FT.
AREA OF OPEN SPACE	35076.00 SFT.
AREA UNDER PLOT	2,37,963.00 SFT.
AREA UNDER ROAD	75,520.20 SFT.

NOTES

BOUNDARY SHOW IN RED
OPEN SPACE SHOWN IN GREEN
AREA UNDER U.L.C SHOWN IN PINK

PROPOSED LAYOUT IN S.NO. 25/1, 25/2
25/3, 25/4, 25/6 AT KAMATHWADE
TAL. NASHIK

SP/-
OWNER
SP/-
ARCHITECT.

DRN BY
CHD BY
DATE
DRG. NO.
JOB NO. 148

DEORE DHAMNE
ARCHITECTS
ARCHITECTURAL
CONSULTANTS AND VALUERS
NIRMAN NIKETAN
NIRMAN NAGAR, VISE MALA
SHARANPUR, EXTENSION
NASHIK 422 005. TEL: 276081, 276082

STAMP OF APPROVAL

TRUE COPY
For DEORE DHAMNE ARCHITECTS

TRUE COPY

ATUL T. WAGH
CONSULTING ENG.
NMC, Reg. No. 77
Mobile - 9325577666

AREA SCHEDULE OF PLOTS					
PLOT NO.	AREA IN SQFT.	AREA IN SQM.	PLOT NO.	AREA IN SQFT.	AREA IN SQM.
1	3000.00	278.86	38	3015.00	280.25
2	3000.00	278.86	39	3015.00	280.25
3	3000.00	278.86	40	4876.00	425.35
4	3000.00	278.86	41	4205.00	455.23
5	3000.00	278.86	42	5332.50	435.67
6	3000.00	278.86	43	5670.00	527.04
7	3000.00	278.86	44	3182.50	295.82
8	3000.00	278.86	45	3015.00	280.25
9	3000.00	278.86	46	3015.00	280.25
10	3150.00	292.80	47	3015.00	280.25
11	3775.00	312.80	48	3015.00	280.25
12	3375.00	313.95	49	4489.00	417.27
13	3125.00	290.48	50	3125.00	295.82
14	3000.00	278.86	51	3015.00	280.25
15	3125.00	290.48	52	3015.00	280.25
16	3550.00	329.98	53	3015.00	280.25
17	4050.00	376.46	54	3852.50	358.10
18	3270.00	303.95	55	3075.00	385.83
19	3570.00	331.84	56	3000.00	278.86
20	3000.00	278.86	57	3000.00	278.86
21	3000.00	278.86	58	4050.00	376.46
22	3000.00	278.86	59	3225.00	299.77
23	3000.00	278.86	60	3000.00	278.86
24	3000.00	278.86	61	3000.00	278.86
25	3000.00	278.86	62	3000.00	287.22
26	3000.00	278.86	63	3249.50	302.05
27	3000.00	278.86	64	3015.00	280.25
28	3000.00	278.86	65	3015.00	280.25
29	3000.00	278.86	66	3015.00	280.25
30	3270.00	303.95	67	3000.00	278.86
31	3570.00	331.84	68	3000.00	278.86
32	3082.00	286.48	69	3750.00	348.53
33	3316.30	308.28	70	4837.50	449.66
34	3015.00	280.25	71	3875.00	360.13
35	3015.00	280.25	72	3500.00	290.80
36	3015.00	280.25	TOTAL = 237963.00 SFT. 22119.63 SQM.		
37	3015.00	280.25			