

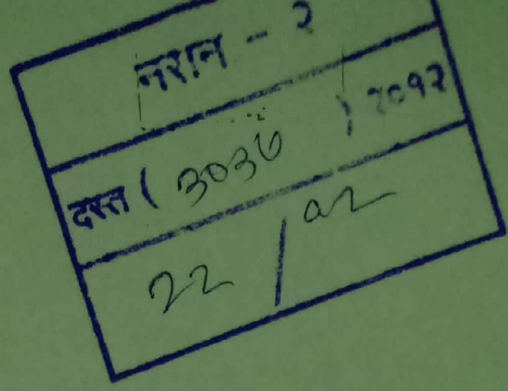


LOCATION MAP

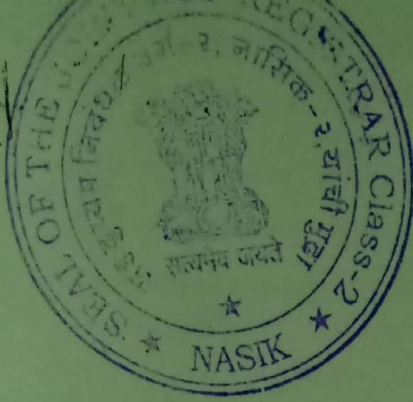

LAYOUT PLAN

SCALE 1:500

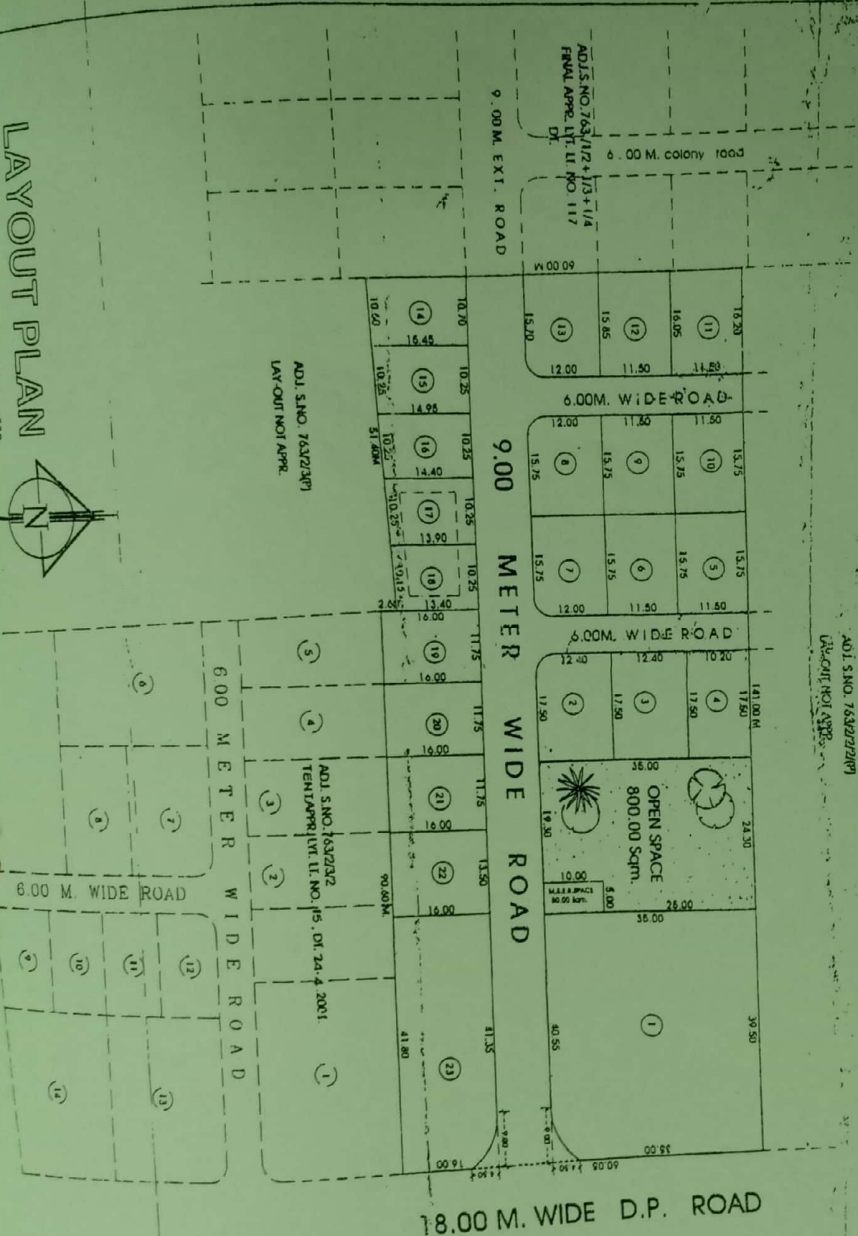

Plot No.	Area in Sqm.	Area in Sqm.
1	160.00	160.00
2	217.00	217.00
3	170.00	170.00
4	181.13	181.13
5	188.00	188.00
6	181.13	181.13
7	188.44	188.44
8	183.43	183.43
9	188.20	188.20
10	187.32	187.32
11	187.32	187.32
TOTAL	5877.76	5877.76

ADJ. SMO. 7632/2011
LAYOUT NOT APPROVED

18.00 M. WIDE D.P. ROAD

DEMARCATION CERTIFICATE

THIS IS TO CERTIFY THAT I HAVE PERSONALLY DEMARCATED THE LAYOUT WHICH IS TENTATIVELY APPROVED BY NASHIK MUNICIPAL CORPORATION NASHIK WIDE LT. NO. 14, DT. 24/04/2001 AND FURTHER CERTIFY THAT THE MEASUREMENTS OF PLOTS, ROADS AND OPEN SPACE ETC. SHOWN IN DEMARCATION PLAN ARE ACTUALLY ON SITE.

ARCHITECT SIGN: _____

AREA STATEMENT

AREA UNDER LAND (AS PER 1:12)	8100.00
AREA UNDER OPEN SPACE	800.00
AREA UNDER MSEB	50.00
AREA UNDER COLONY ROAD	1272.24
AREA UNDER PLOTS	5877.76

NOTES

- ALL DIMENSIONS ARE IN METERS
- LAND BOUNDARY SHOWN IN BLACK
- OPEN SPACE SHOWN IN GREEN

DEMARCATED FINAL LAYOUT PLAN

IN S. NO. 7632/2012, AT NASHIK FOR SHRI SHIVAJI R. JACHAK & OTHERS G.P.A. HOLDER SHRI V. F. SAGHAORA

DATE: 05/11/2011

SCALE: 1:500

DATE: 05/11/2011

SCALE: 1:500

DATE: 05/11/2011

SCALE: 1:500