


N.M.R.D.A.
L.S. No. 876
L.S. Valid
Up to 31-12-2025

REVISED PLAN FOR EXISTING & PROPOSED
RESIDENTIAL BUILDING OF MULTI FAMILY
DWELLING UNIT ON PLOT NO. 1 D.KH.NO-20/4(NEW),
P.H.NO.38, MOUZA -BELTARODI,TAH. DIST.-NAGPUR.
BELONGING TO-
GALAXY ASSOCIATES,
THROUGH PARTNER
1) SHRI PRAVIN KANUBHAI BAJARIYA
2) SHRI RAMESH PREMJBHAI PATEL

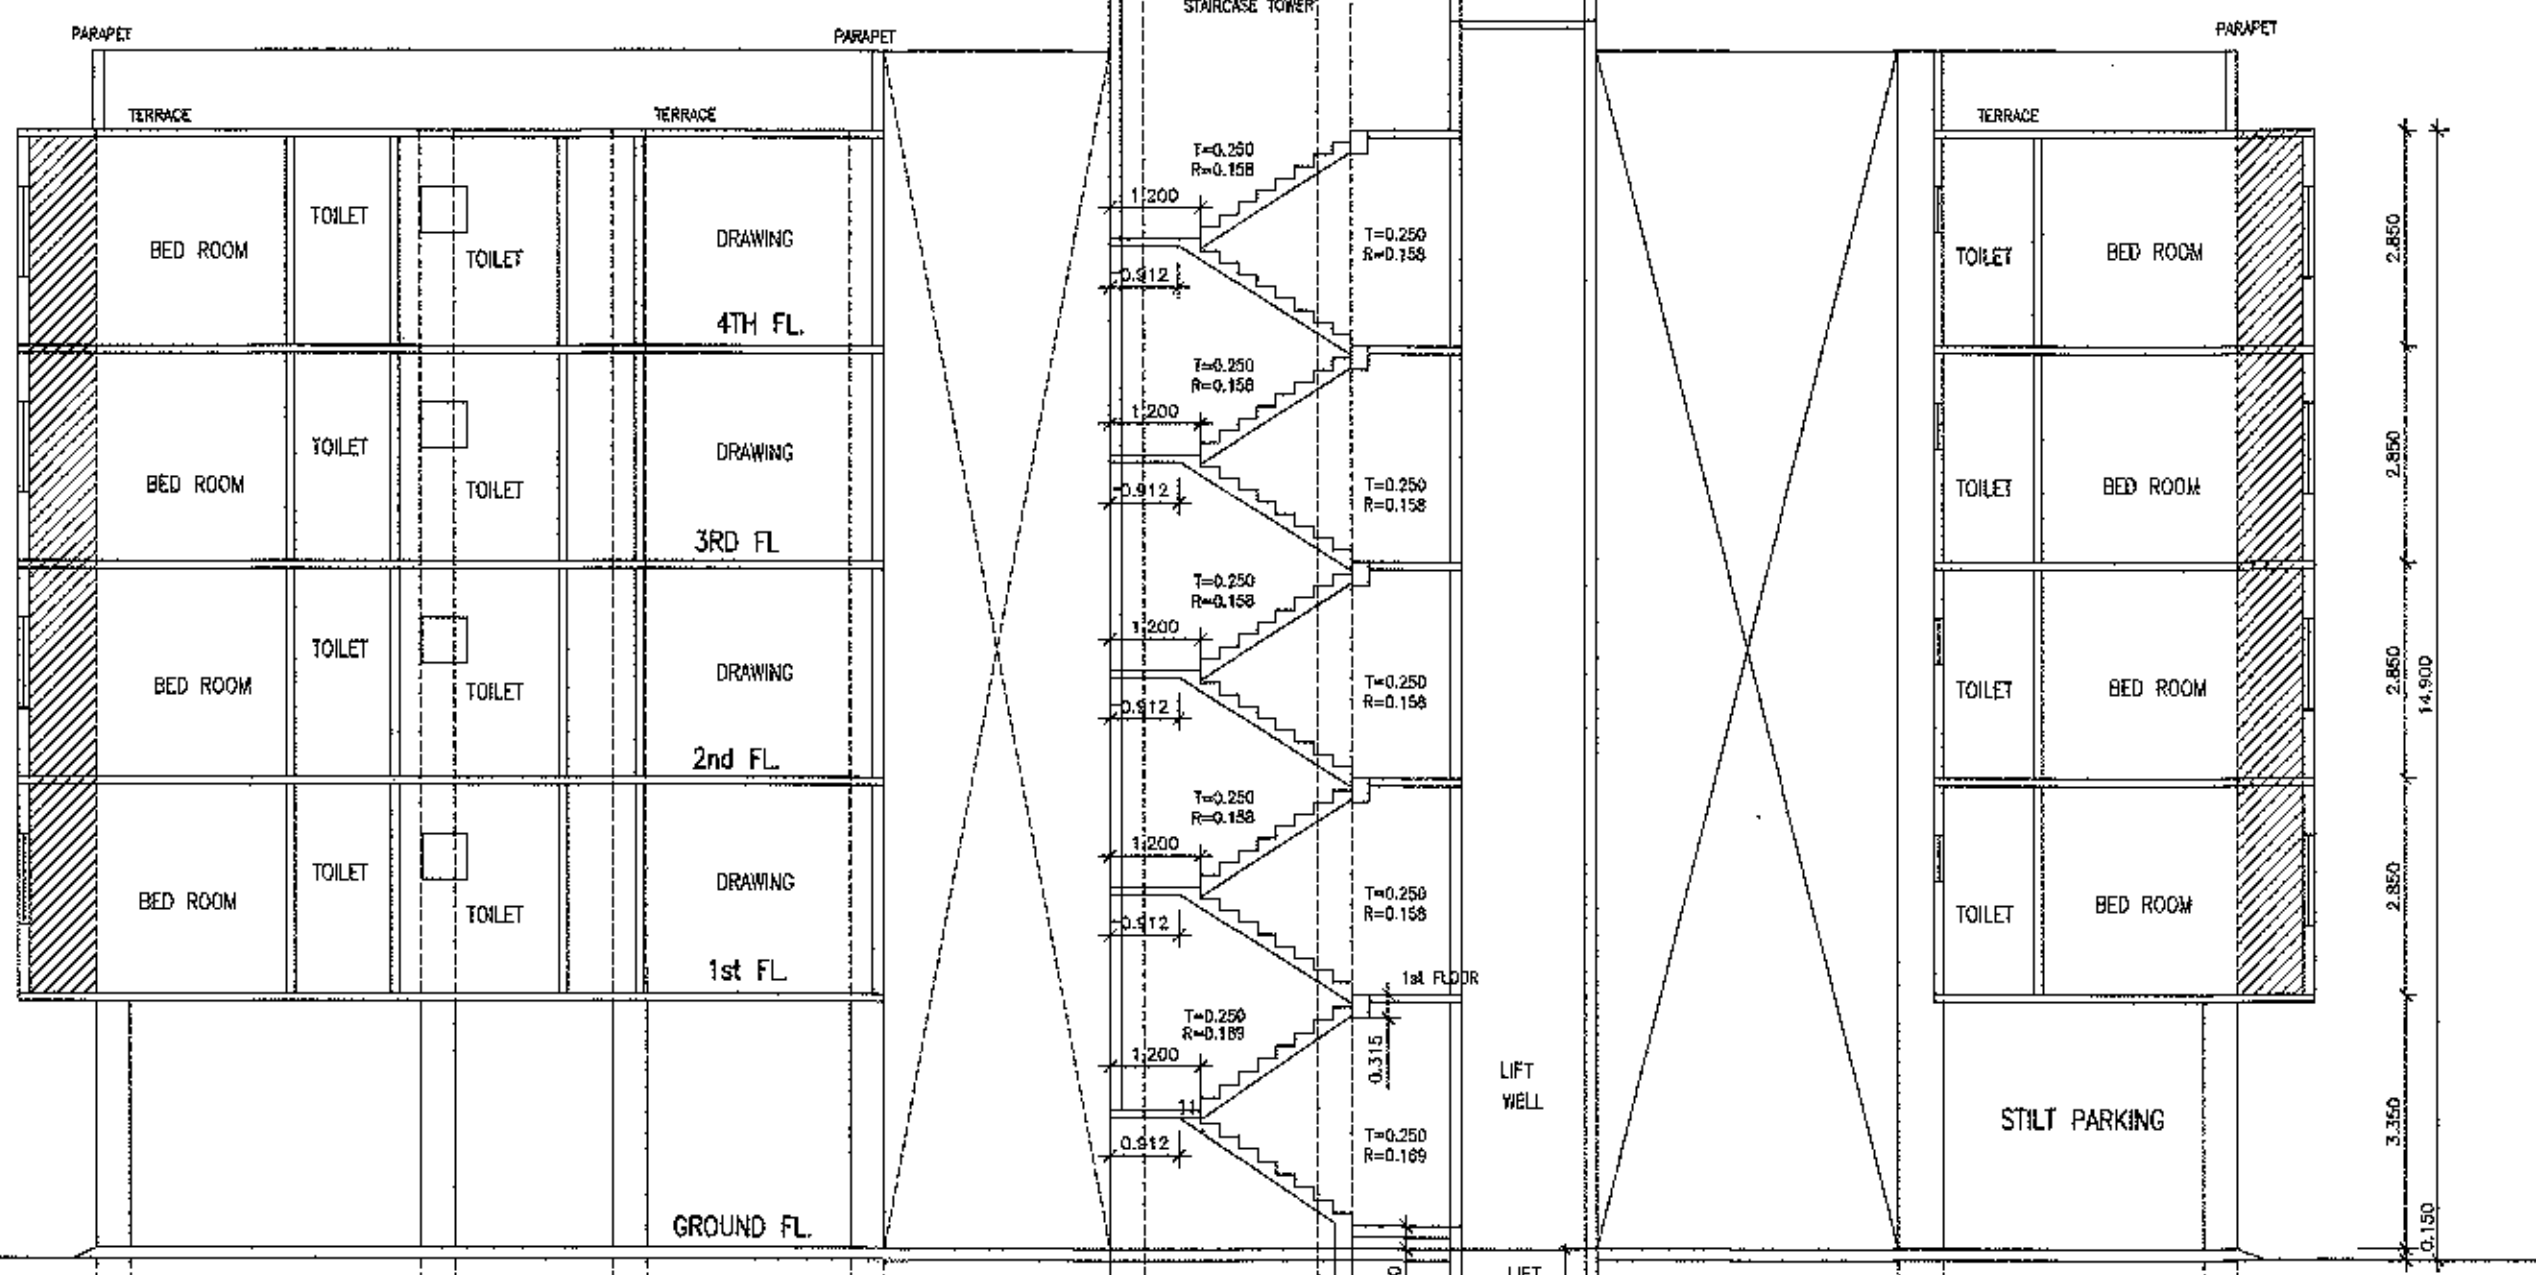

This sanction is subject to conditions of
N.A.order DL 4-9-2019
N.A.T.P.order DL 4-12-2012

Necessary arrangement for rain
water harvesting shall be done.
Subject to the provisions of
structural drawings submitted by
applicant.

FRONT ELEVATION
SCALE:1:100

This Sanction Is Subject To
Conditions Mentioned In Release
Letter Of N.I.T. Dt. 7.11.2013

OFFICE OF THE
NAGPUR METROPOLITAN REGION DEVELOPMENT AUTHORITY
Building Permit No. BE (NMRDA)/South/NGP(R)/AB-3772/201611196/1028
15/07/2017
SANCTIONED
Assistant Engineer
Nagpur Metropolitan Region Development Authority
NO DEVIATION HEREBY SHALL BE
COMPOUNDED HEREAFTER


SECTION A-A
SCALE:1:100

This Sanction Is Subject To Conditions
Mentioned In Development agreement
Dt. 4.12.2012


SUBJECT TO THE PROVISIONS OF STRUCTURAL DESIGN
SUFFICIENCY CERTIFICATE DATED 29.11.2018 OF
STRUCTURAL DESIGNER AND APPLICANT

This Sanction Is Subject To
Conditions Mentioned In Release
Letter Of N.I.T. Dt. 7.11.2012

Previous building permit No - BE (NMRDA)/South/NGP(R)/AB-3772/201611196/1028
dated - 15/07/2017

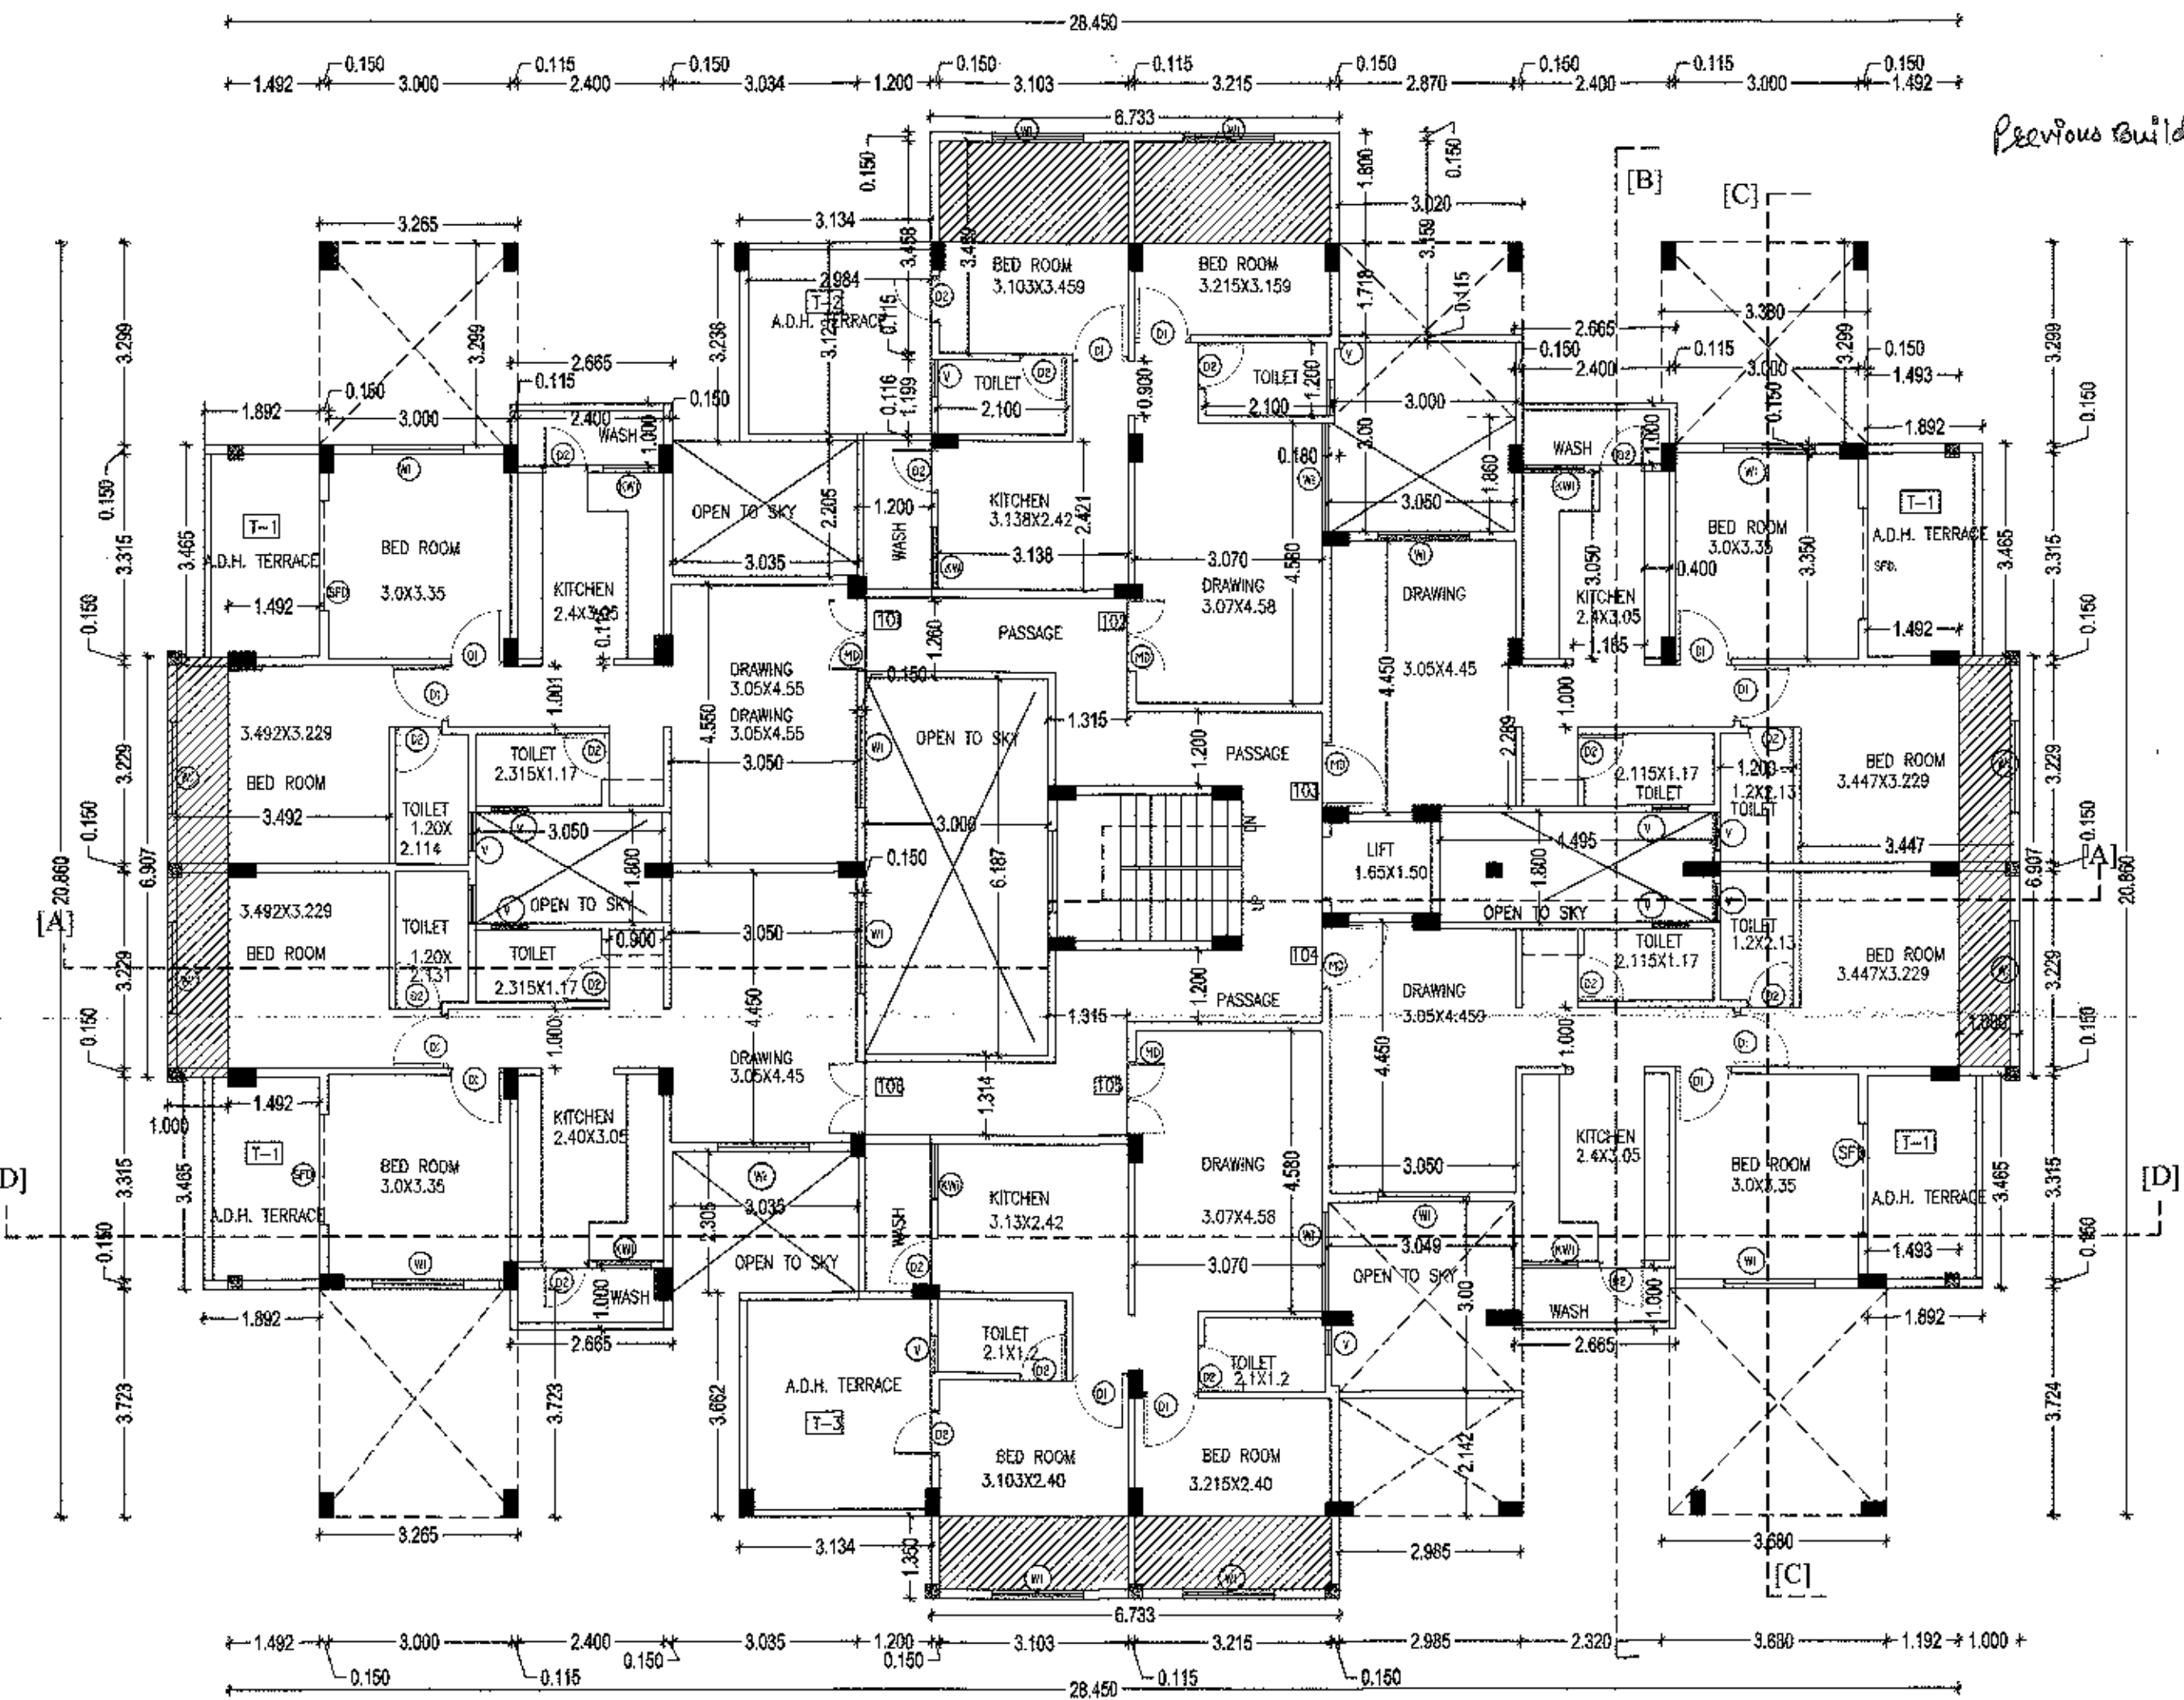

EXISTING SECOND FLOOR PLAN
SCALE:1:100

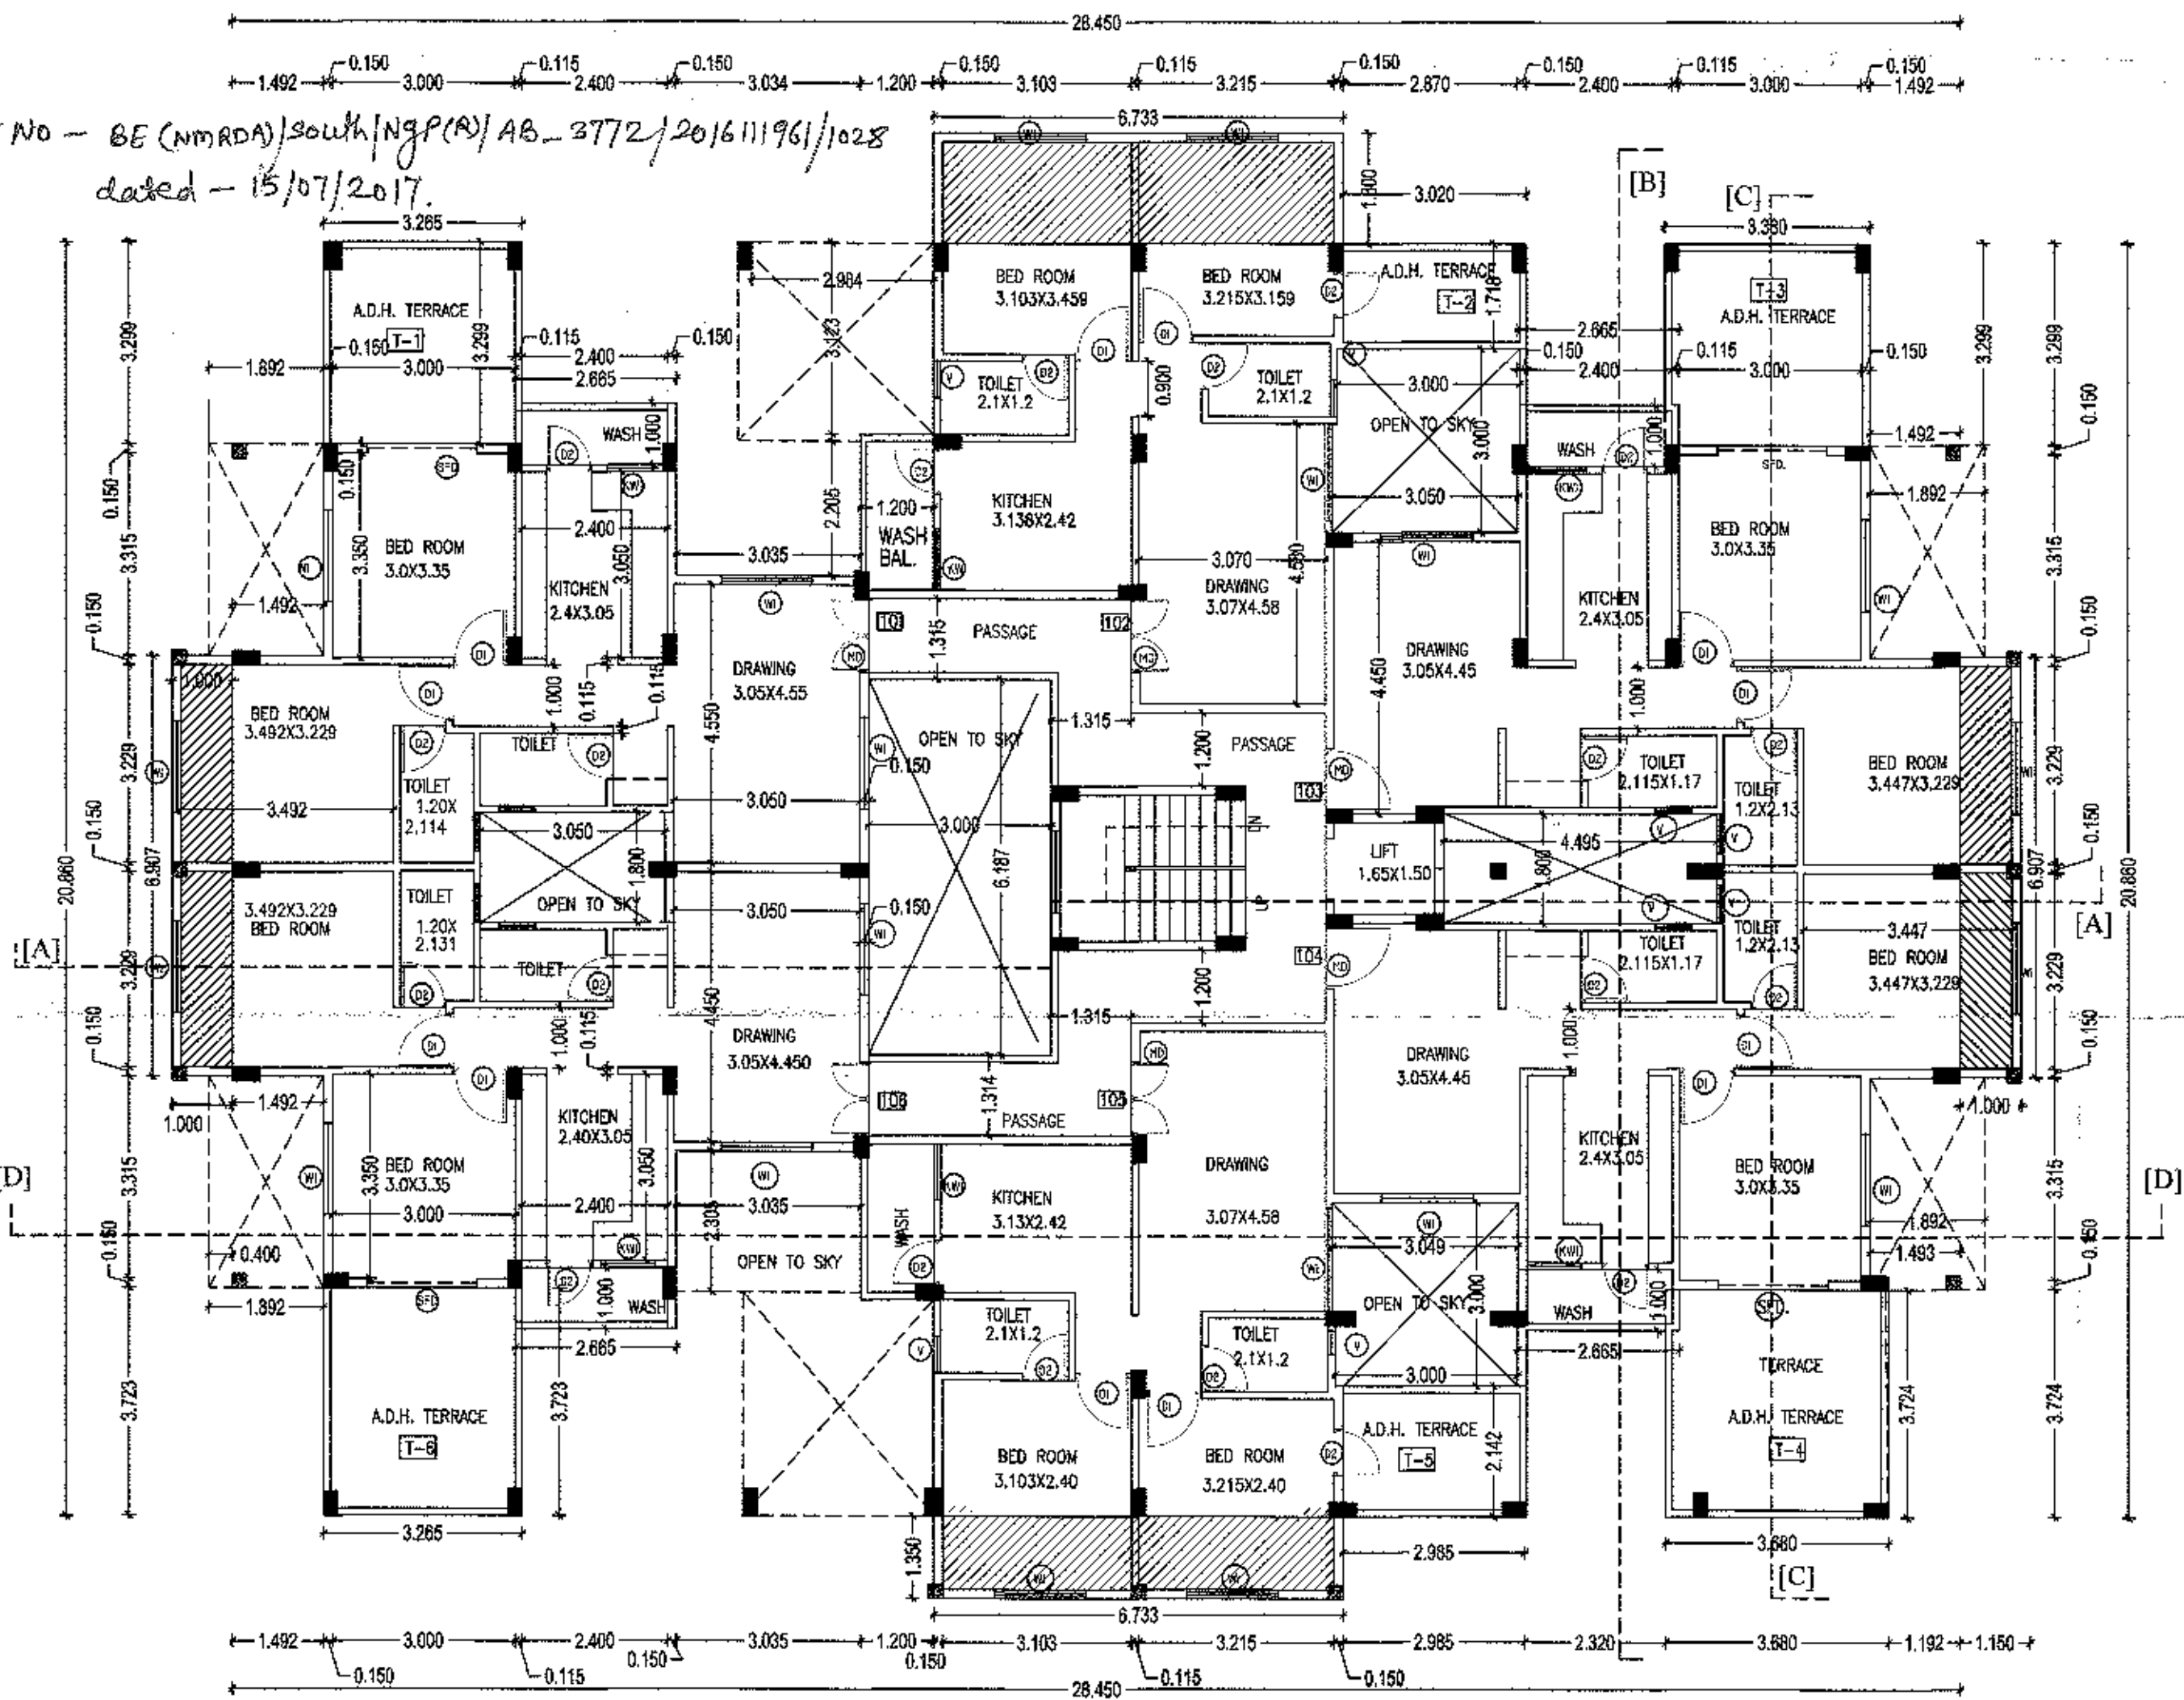

EXISTING THIRD FLOOR PLAN
SCALE:1:100


SCHEDULE OF OPENING		
NO	SIZE	REMARK
D	1.050X2.100	T.W. PANNELED DOOR
D1	1.000X2.100	R.C.C DOOR FRAME WITH FLUSH PANNEL
D2	0.750X2.100	R.C.C DOOR FRAME WITH FLUSH PANNEL
SFD	2.10X2.100	SLIDING FOLDING DOOR
W1	1.500X1.500	ALLUMINIUM GLAZED WINDOW
W5	1.500X1.200	ALLUMINIUM GLAZED WINDOW
KW	1.200X0.900	ALLUMINIUM GLAZED WINDOW
KW1	0.900X0.900	ALLUMINIUM GLAZED WINDOW
V1	0.600X0.800	M.S. VENTILATOR

INDEX
PLOT BOUNDARY SHOWN IN BLACK
PROPOSED CONST. SHOWN IN RED
EXISTING CONST. SHOWN IN BLUE

OWNER'S SIGN
1) SHRI PRAVIN KANUBHAI BAJARIYA
2) SHRI RAMESH PREMJBHAI PATEL

L. ENGINEER
KISHOR N. MEHATA
LICENSED ENGINEER
RMC - L-64
MTC - 876
ARCHITECTURAL CONSULTANT:-
ER. KISHOR MEHATA
PH. NO. - 937431000


REVISED PLAN FOR EXISTING & PROPOSED
RESIDENTIAL BUILDING OF MULTI FAMILY
DWELLING UNIT ON PLOT NO. 1 D.KH.NO-20/4(NEW),
P.H.NO.38, MOUZA -BELTARODI,TAH. DIST.-NAGPUR,
BELONGING TO-
GALAXY ASSOCIATES ,
THROUGH PARTNER
1) SHRI PRAVIN KANUBHAI BAJARIYA
2) SHRI RAMESH PREMJBHAI PATEL

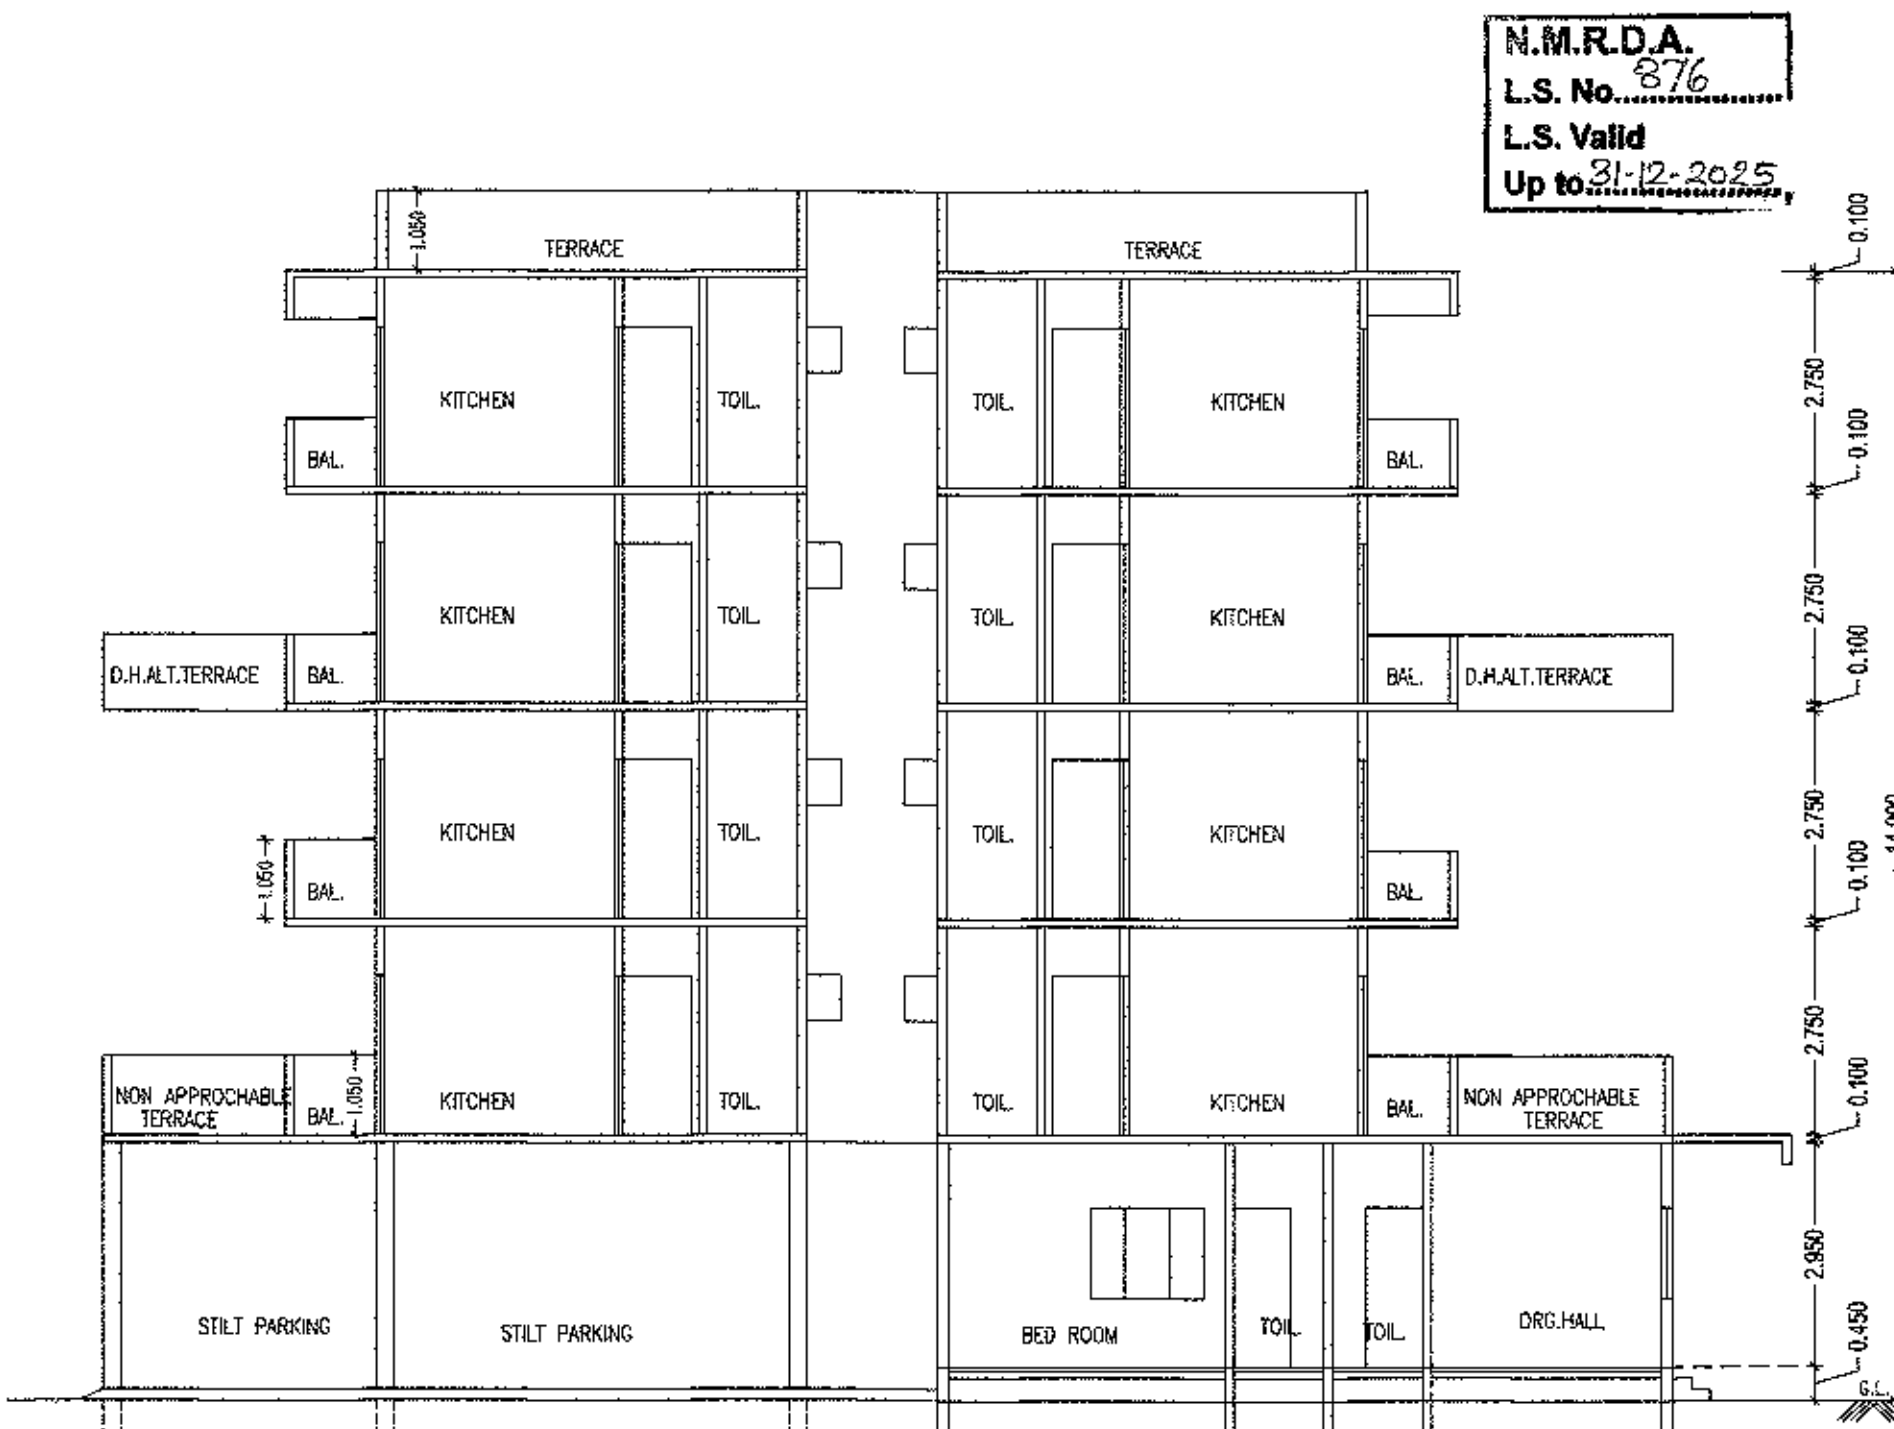

SECTION B-B
SCALE-1:100


This Sanction is Subject To
Conditions Mentioned In Release
Letter Of N.I.T. Dt.17.11.2012

This Sanction is Subject To
Conditions Mentioned In Release-Subdivision.
Letter Of N.I.T. Dt.8.11.2013

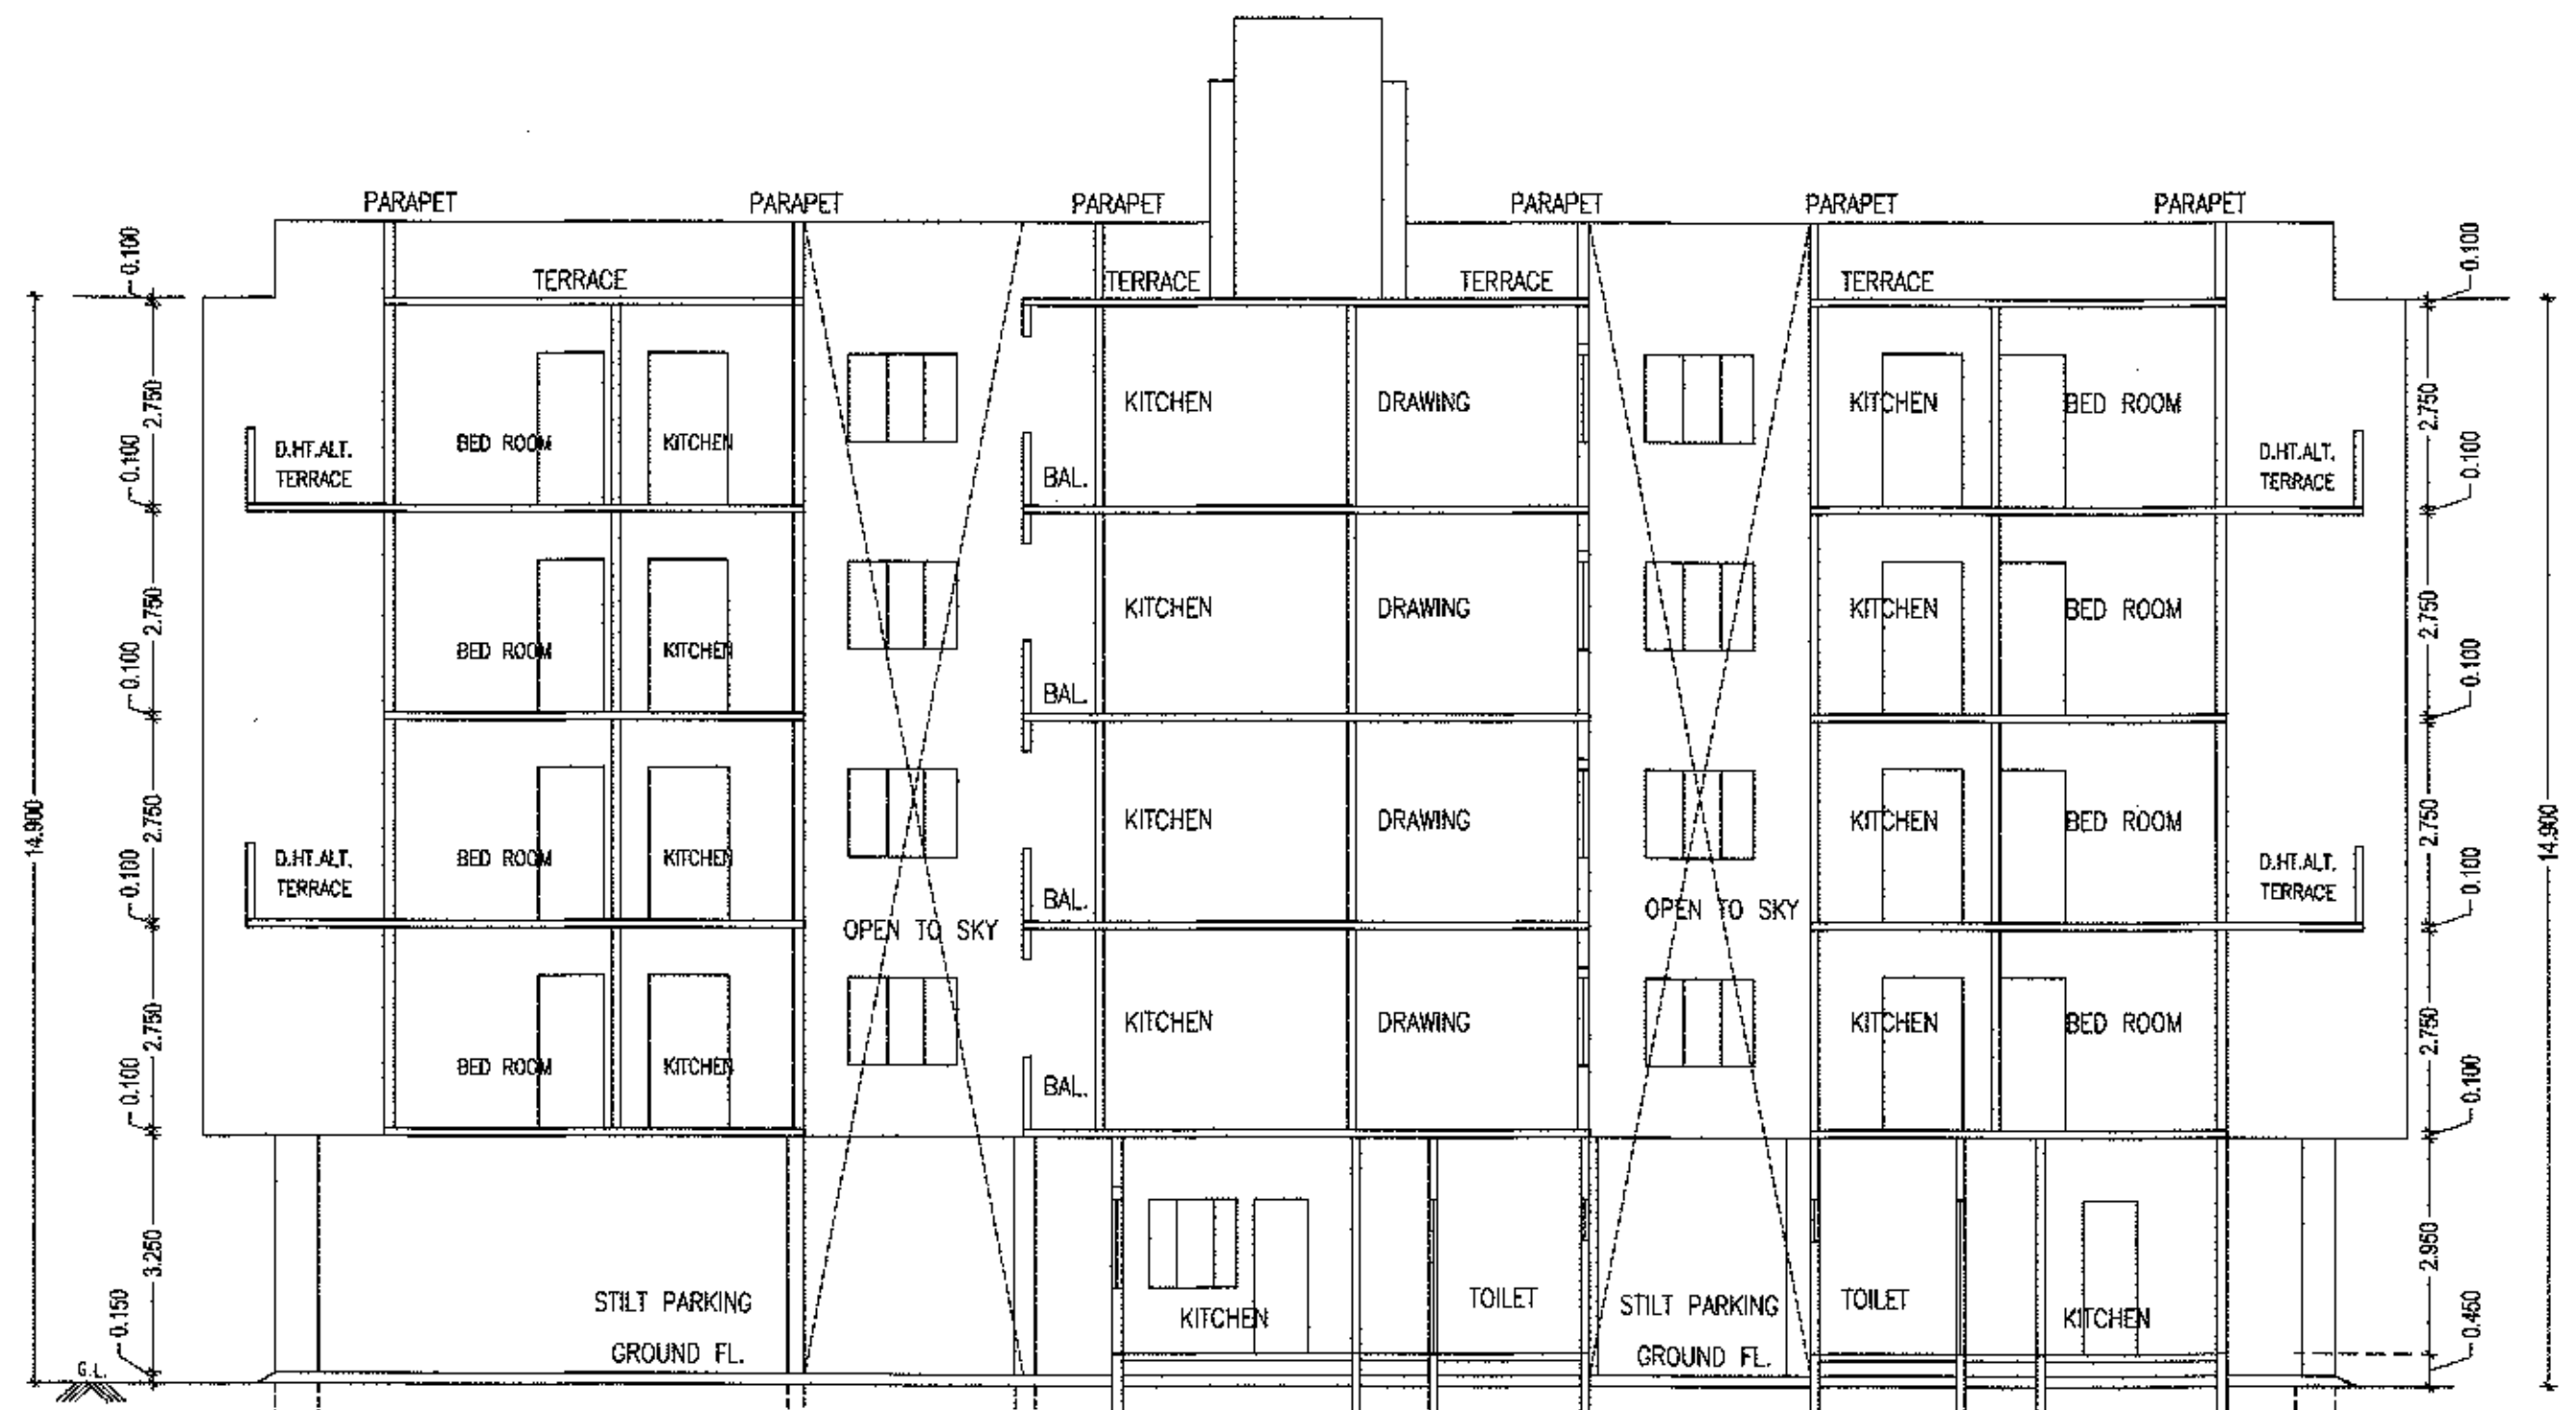

SECTION D-D
SCALE-1:100

Previous building permit no - BE (NMRDA)/south/NagP(A)/AB - 3772/2016/11961/1028
dated - 15/07/2014

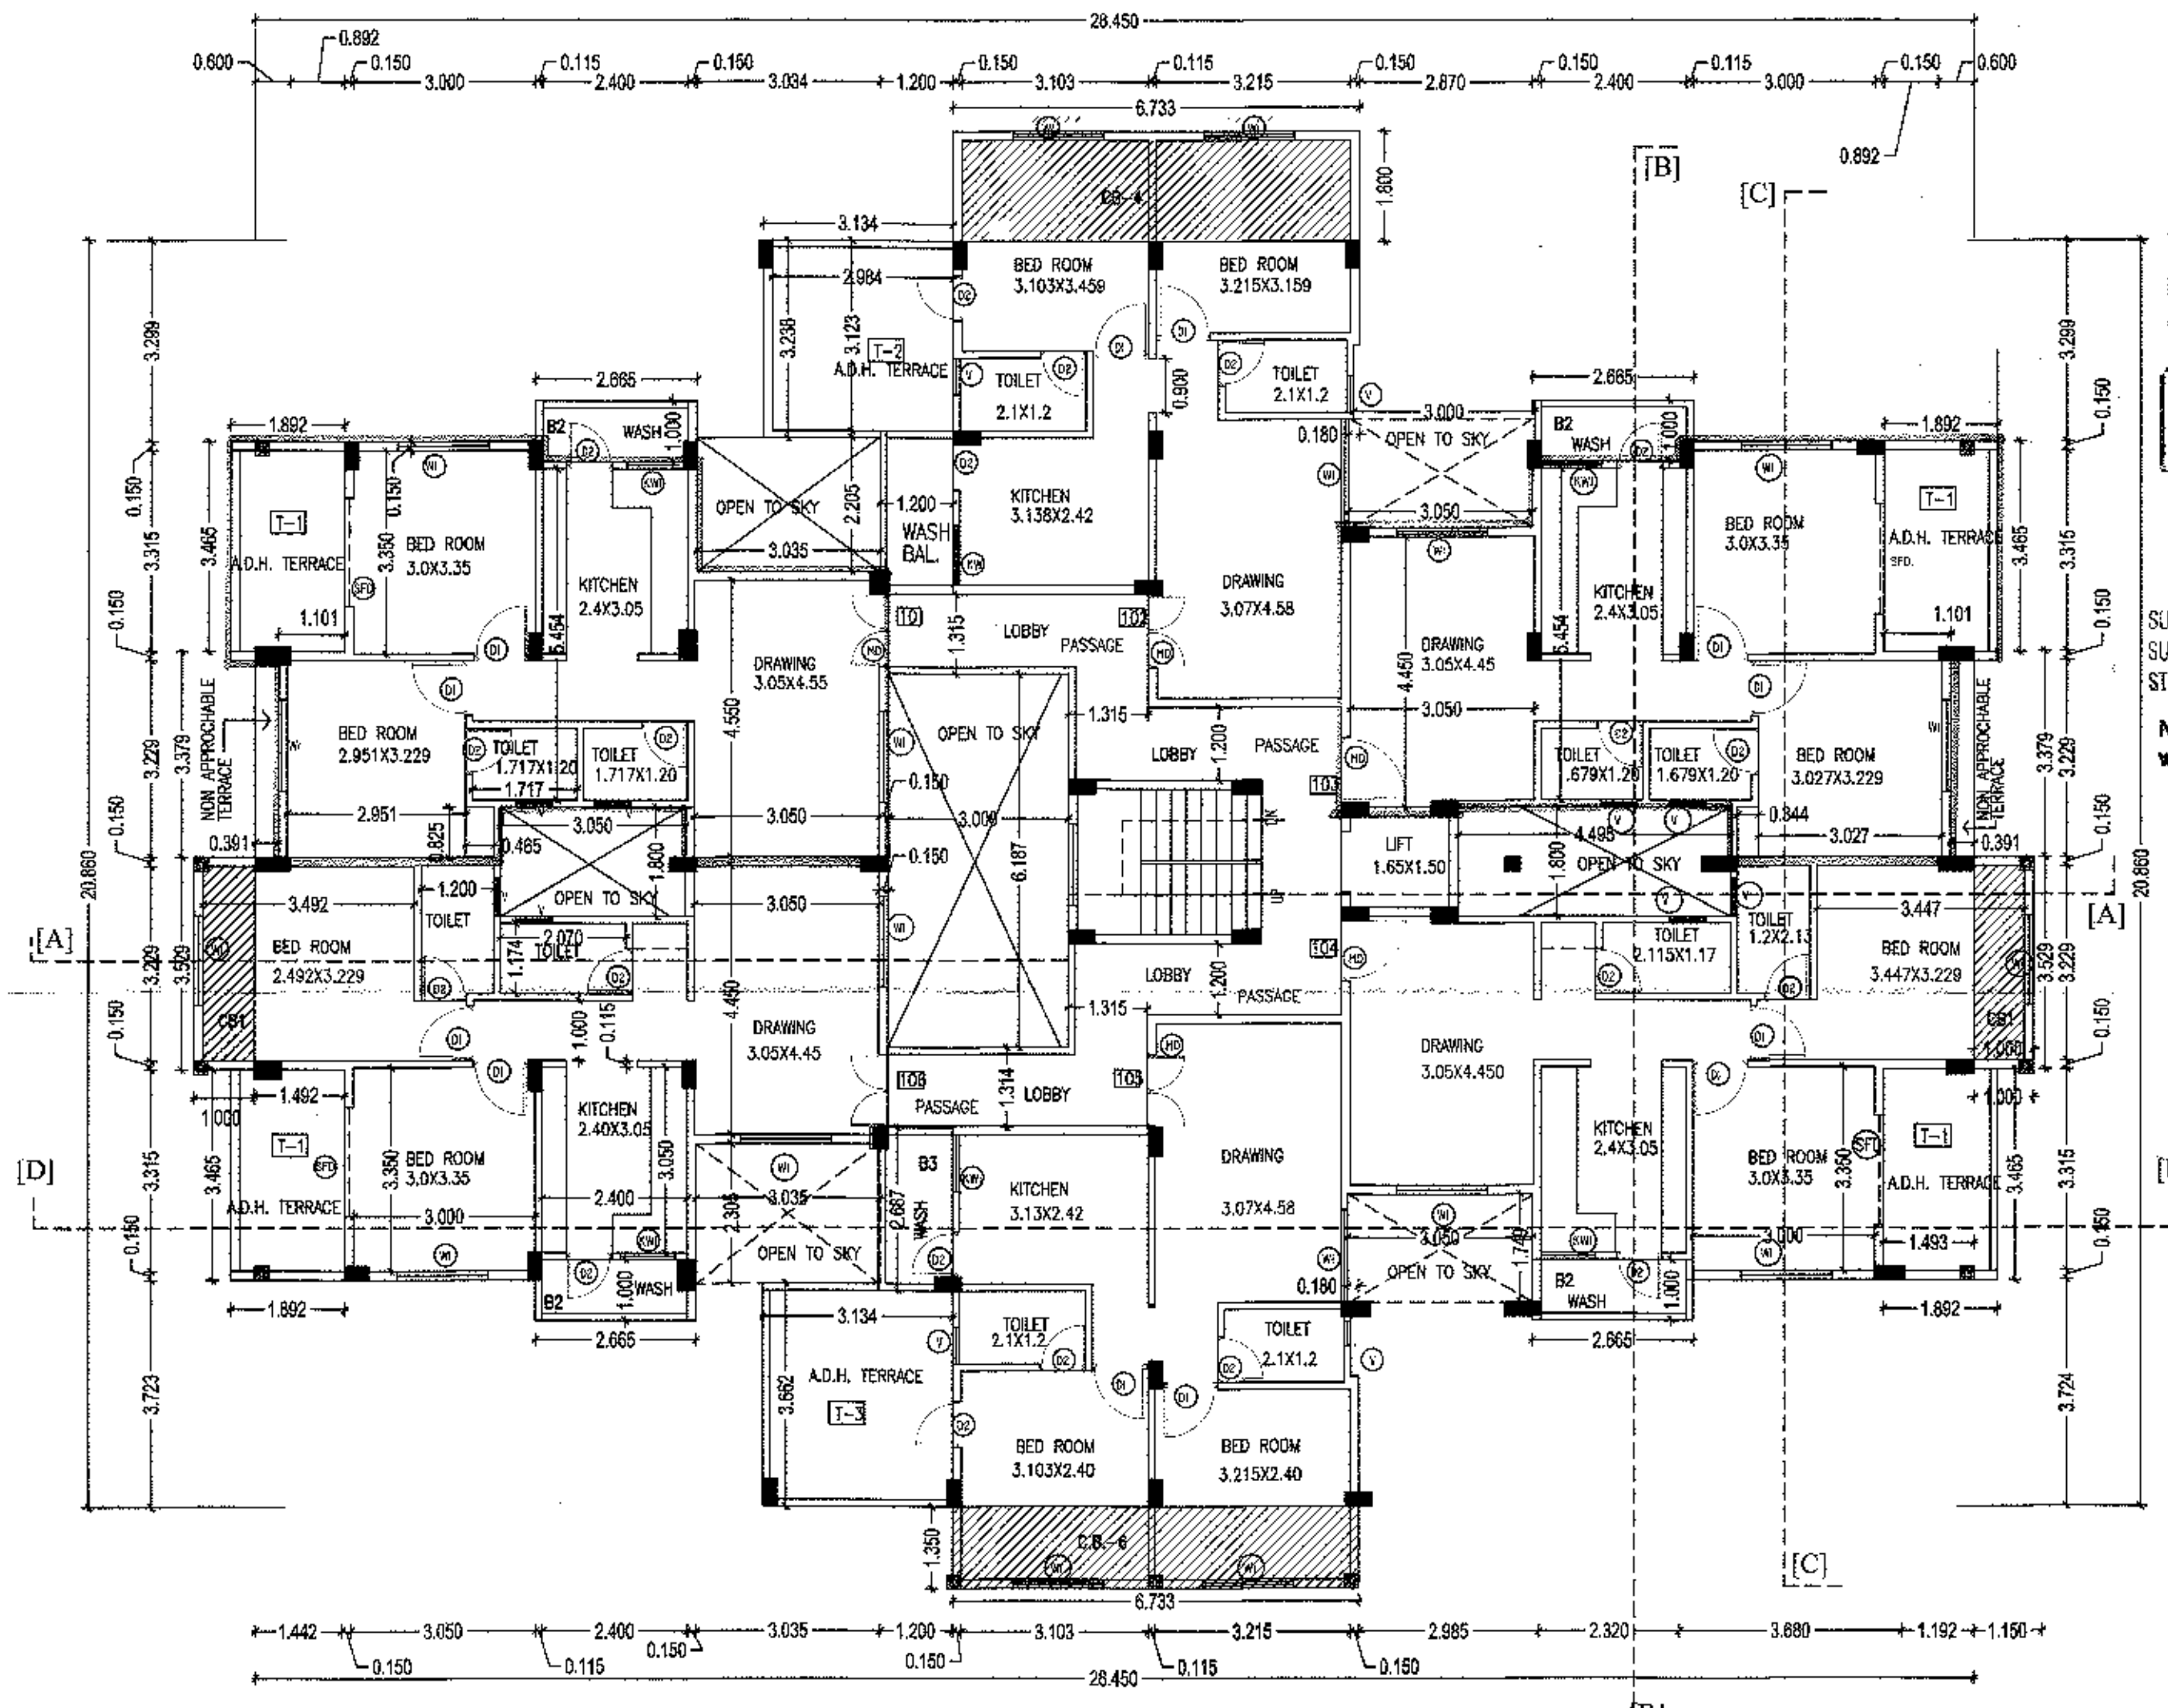

EXISTING & PROPOSED FOURTH FLOOR PLAN
SCALE-1:100

OFFICE OF THE
NAGPUR METROPOLITAN REGION DEVELOPMENT AUTHORITY
Building Permit No. BE (NMRDA)/south/NagP(A)/AB - 3772/2016/11961/1028
SANCTIONED
Assistant Engineer
Nagpur Metropolitan Region Development Authority

NO DEVIATION HEREBY SHALL BE
COMPOUNDED HEREAFTER


This sanction is subject to conditions of
N.A. order Dt. 4-7-2010
N.A.T.P. order Dt. 1-12-2012

This Sanction is Subject to Conditions
Mentioned in Development agreement
Dt. 4/12/2012

SUBJECT TO THE PROVISIONS OF STRUCTURAL DESIGN
SUFFICIENCY CERTIFICATE DATED 29/12/2018 OF
STRUCTURAL DESIGNER AND APPLICANT

Necessary arrangement for rain
water harvesting shall be done.

Subject to the provisions of
structural drawings submitted
by applicant.

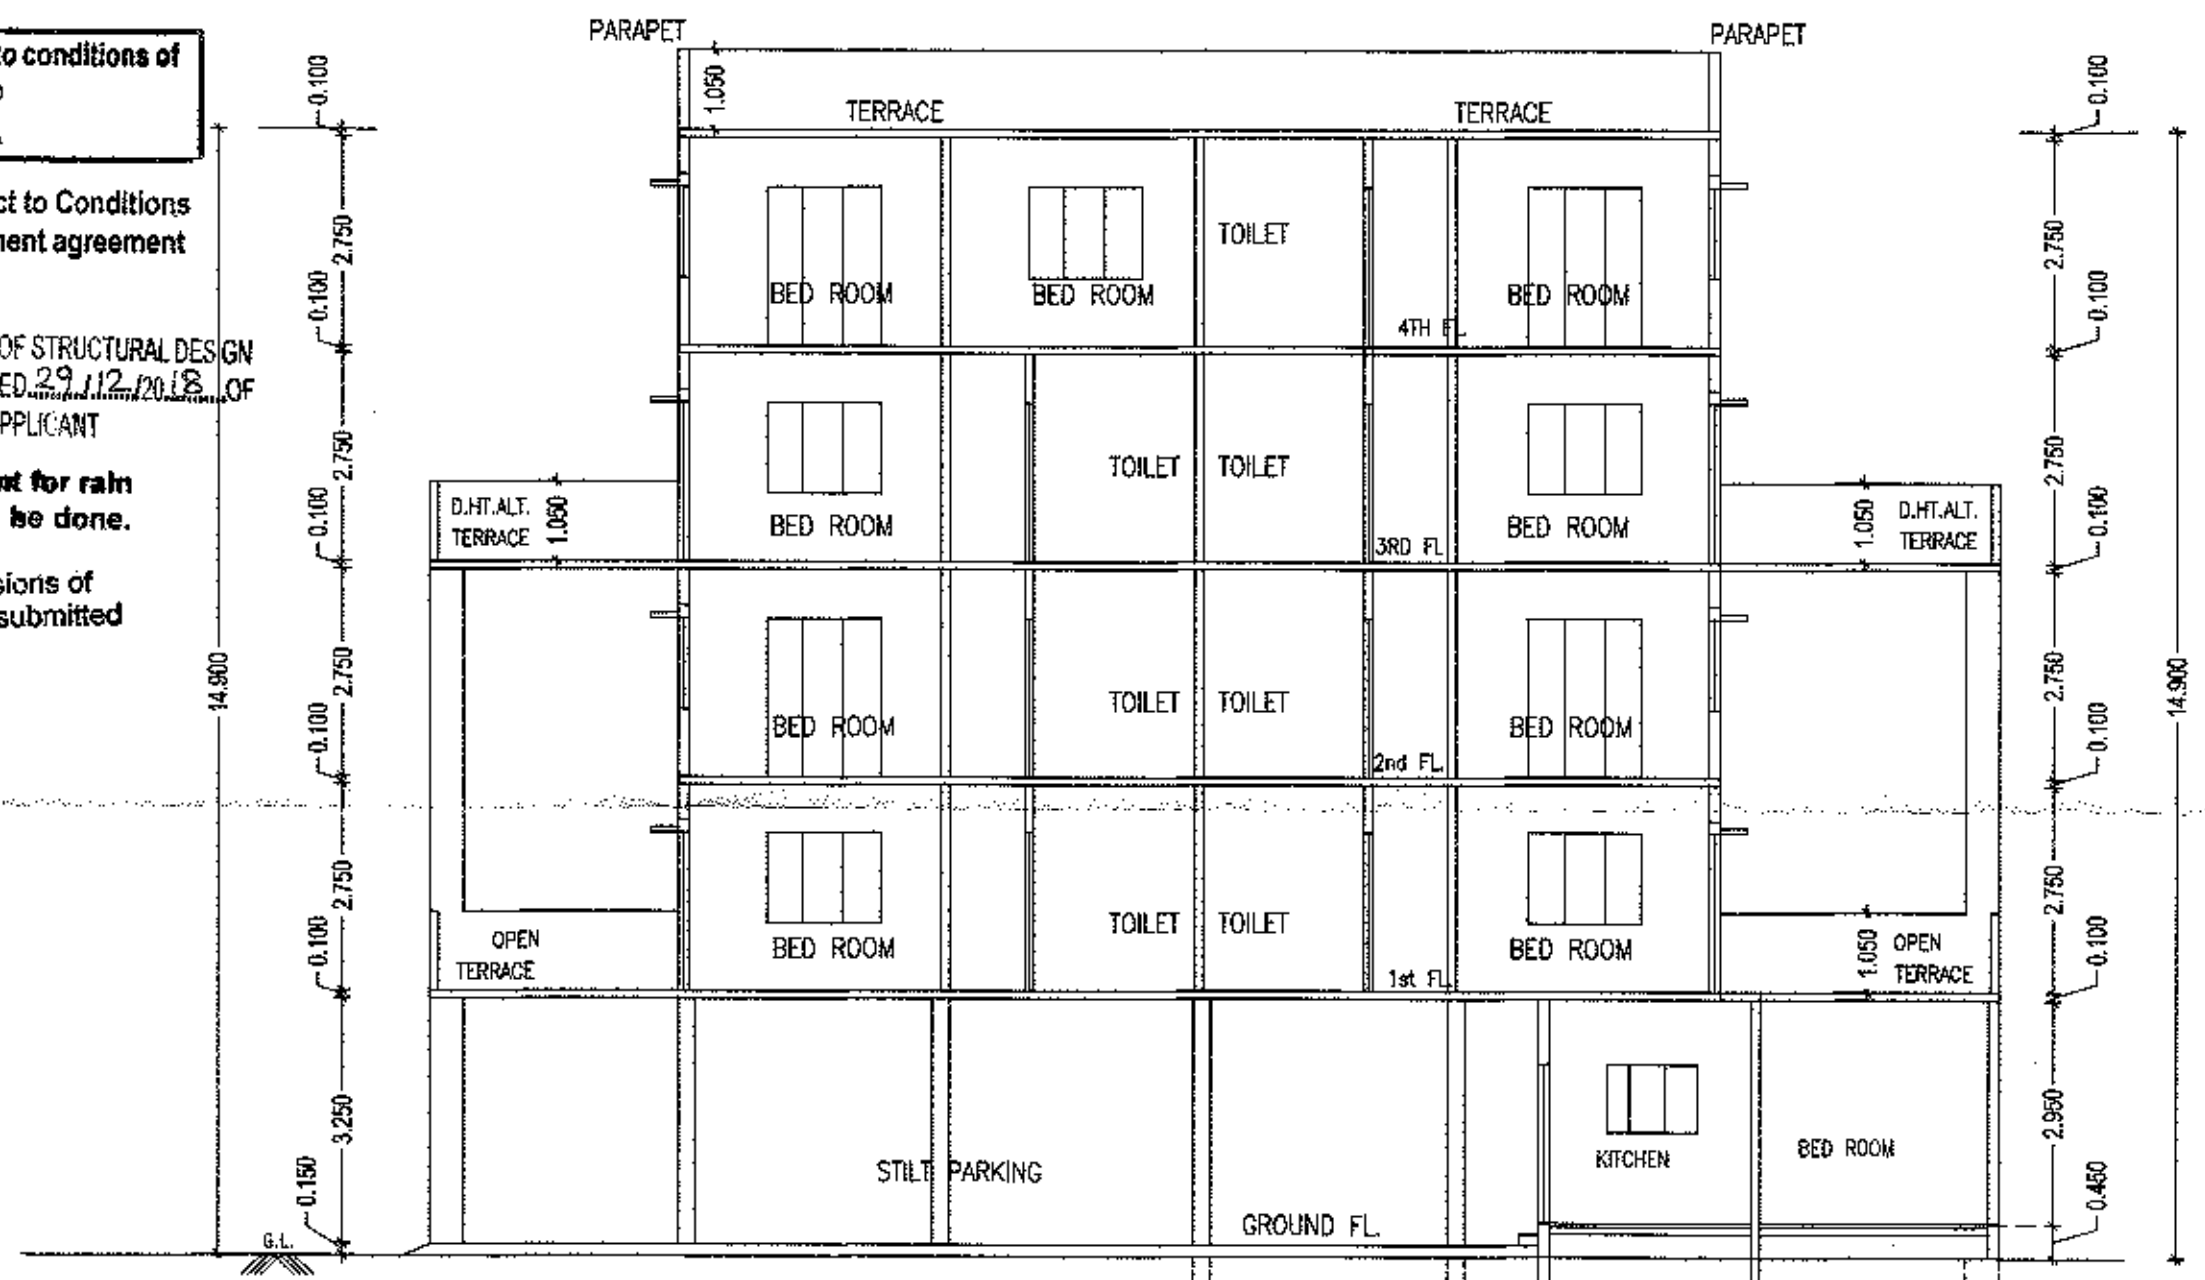

SECTION C-C
SCALE-1:100

SCHEDULE OF OPENING

NO	SIZE	REMARK
D	1.050X2.100	T.W. PANNELED DOOR
D1	1.000X2.100	R.C.C DOOR FRAME WITH FLUSH PANNEL
D2	0.750X2.100	R.C.C DOOR FRAME WITH FLUSH PANNEL
SFD	2.10X2.100	SLIDING FOLDING DOOR
W1	1.500X1.500	ALLUMINIUM GLAZED WINDOW
W5	1.500X1.200	ALLUMINIUM GLAZED WINDOW
KW	1.200X0.900	ALLUMINIUM GLAZED WINDOW
KW1	0.900X0.900	ALLUMINIUM GLAZED WINDOW
V1	0.600X0.600	M.S. VENTILATOR

INDEX
PLOT BOUNDARY SHOWN IN BLACK
PROPOSED CONST. SHOWN IN RED
EXISTING CONST. SHOWN IN BLUE

OWNER'S SIGN

1) SHRI PRAVIN KANUBHAI BAJARIYA
2) SHRI RAMESH PREMJBHAI PATEL

L. ENGINEER

KISHOR N. MEHATA
LICENCED ENGINEER
NMC - L-44
NIT - 876
ARCHITECTURAL CONSULTANT:-
ER. KISHOR MEHATA
PH. NO. - 9371431000