LAYOUT OF GAT NO. 63 OF PIMPRALE, TAT JALGAON

AREA OF G. NO = A - 65 / 4 - 27

AREA UNDER PLOT = 1,42,810 140 /AC

AREA UNDER OPENSPACE = 20376

AREA UNDER ROAD = 40451

43 27

SCALE 1"=50'

DEMARCATION PLAN



PLOT NO	AREA IN SQ.FT.	PLOT NO	AREA IN SQ.FT.
1	~~3534~~ 3400	23	3055
2	3180	24	3055
3	3180	25	3000
4	3180	26	3000
5	3180	27	3000
6	3180	28	3000
7	3180	29	~~3213~~ 3300
8	3180	30	3230
9	3180	31	3055
10	3180	32	3055
11	~~3420~~ ~~3360~~	33	3055
12	~~3185~~ ~~3165~~	34	3055
13	3120	35	3055
14	3640	36	~~4050~~ 3410
15	~~3620~~ 3420	37	~~4127.5~~ 3607
16	~~4425~~ 4350	38	3055
17	~~4680~~ 3360	39	3055
18	3920	40	3055
19	3600 ~~3350~~	41	3055
20	3600	42	3055
21	~~4316~~ 3610	43	~~3535~~ 3580
22	~~3250~~ 3250		
			~~TOTAL 142,810~~

APPROVED NO. DV/JLG/4261

SD/-


ASSISTANT DIRECTOR
TOWN PLANNING, JALGAON

APPROVED
SUBJECT TO CONDITIONS
MENTIONED IN ORDER
NO LNSR 1874 AT 7-3-74

SD/-

COLLECTOR, JLGAON

SEAL

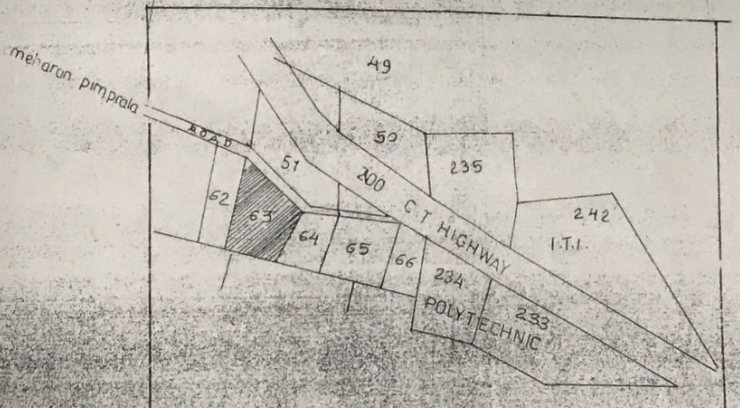

PADMAVATI ESTATE BROKER
S.T.D.(0257)
(O) 2229184
(R) 2264078
(M) 9422283475
JALGAON

Scanned by CamScanner