AREA DIA. & CAL OF BASEMENT FLOOR

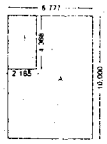

AREA OF A =
= 6.777 X 10.00 = 67.77 SQM.
DEDUCTION
1) 2.185 X 4.368 = 9.544 SQM.
TOTAL B/UP AREA = 9.544 SQM.
NET B/UP AREA =
AREA OF A - DEDUCTION AREA
NET B/UP AREA = 67.77 - 9.544 SQM.
BASEMENT FLOOR B/UP AREA = 58.226 SQM.

AREA DIA. & CAL. OF GROUND FLOOR

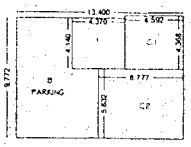

AREA OF B =
= 13.400 X 9.772 = 130.944 SQM.
COMM.B/UP AREA =
C1) 4.592 X 4.368 = 20.057 SQM.
C2) 8.777 X 5.632 = 38.168 SQM.
TOTAL B/UP AREA = 58.225 SQM.
DEDUCTION
1) 4.370 X 4.140 = 18.091 SQM.
PARKING AREA =
AREA OF B -B/UP AREA -DEDUCTION
130.944 - 58.225 - 18.091 = 54.628 SQM.
PARKING AREA = 54.628 SQM.

PARKING REQUIRED AREA =
392.278 X 0.75 / 200 X 24.40 = 35.893 SQM.
PARKING PROPOSED AREA = 54.628 SQM.

AREA DIA. & CAL. OF FIRST FLOOR

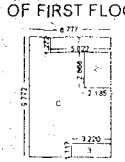

AREA OF C =
= 6.777 X 9.772 = 66.224 SQM.
DEDUCTION :-
1) = 5.072 X 1.272 = 6.387 SQM.
2) = 2.185 X 2.868 = 6.266 SQM.
3) = 3.220 X 1.117 = 3.596 SQM.
TOTAL = 16.249 SQM.
NET B/UP AREA =
AREA OF C - DEDUCTION AREA
NET B/UP AREA = 86.224 -16.249 SQM.
FIRST FLOOR B/UP AREA =49.975 SQM.

AREA DIA. & CAL.OF TIYPICAL SECOND & THIRD FLOOR

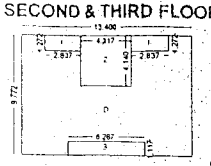

AREA OF D =
= 13.400 X 9.772 = 130.944 SQM.
DEDUCTION :-
1) = 2.837 X 1.272 X 2 = 7.217 SQM.
2) = 4.217 X 4.140 = 17.458 SQM.
3) = 6.287 X 1.117 = 7.022 SQM.
TOTAL = 31.697 SQM.
NET B/UP AREA =
AREA OF D - DEDUCTION AREA
NET B/UP AREA = 130.944 - 31.697 SQM.
SECOND FLOOR B/UP AREA = 99.247 SQM.
THIRD FLOOR B/UP AREA = 99.247 SQM.

AREA DIA. & CAL. OF FORTH FLOOR

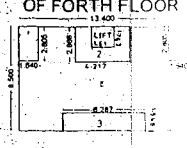

AREA OF E =
= 13.400 X 8.500 = 113.90 SQM.
LIFT = 4.217 X 1.272 = 5.238
114.778 SQM.
DEDUCTION
1) = 1.640 X 2.805 X 2 = 9.200 SQM.
2) = 4.217 X 2.868 = 12.094 SQM.
3) = 6.287 X 1.568 = 9.858 SQM.
TOTAL = 31.152 SQM.
NET B/UP AREA =
AREA OF E - DEDUCTION AREA
NET B/UP AREA = 115.738-31.152 SQM.
FORTH FLOOR B/UP AREA = 85.58 SQM.

COMPLETED B/UP AREA =
SAME AS FIRST FLOOR B/UP AREA
49.975 SQM.

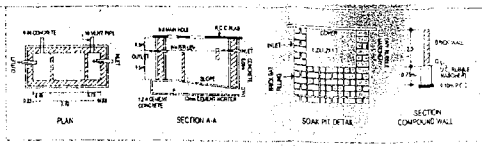

APPROVAL

APPROVED
For Occupancy, under this office letter
No. 0609 dated 01/11
For Gram + Panchayat Title
Assistant Director of Town Planning
Municipal Corporation of the city of Jalgaon

SCHEDULE OF BALCONY

FLOOR	PERIMETER	PERMISSIBLE BALC	PROPOSED BALC
FIRST	33.096/3	11.032	7.318
SECOND	46.344/3	15.448	13.866
THIRD	46.344/3	15.448	13.866
FORTH	46.344/3	15.448	6.024

TOTAL ENCLOSE BALCONY = 41.074 < 20

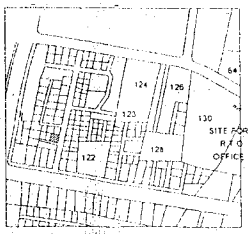

LOCATION PLAN

PART COMPLETED COMMERCIAL AND RESIDENTIAL BUILDING IN PLOT NO. 8 S.NO.121 A AT JALGAON, TAL AND DIST JALGAON.

AREA STATEMENT.

AREA OF PLOT NO. 8	= 281.80 SQ.M.
AREA OF TDR. C.O.V. DRC NO.33 DATE 20/2/12	= 111.52 SQ.M.
TOTAL AREA	393.32 SQ.M.
COMPLETED COMM. B/UP ON GROUND FLOOR	= 58.225 SQ.M.
COMPLETED RESI.B/UP ON FIRST FLOOR.	= 49.975 SQ.M.
COMPLETED RESI. B/UP ON SECOND FLOOR.	= 99.247 SQ.M.
PART COMP. RESI B/UP ON THIRD FLOOR.	= 49.975 SQ.M.
TOTAL COMPLETED B/UP AREA	= 257.425 SQ.M.
PART UNDER CONC. B/UP ON THIRD FLOOR.	49.225 SQ.M.
UNDER CONC. B/UP ON FORTH FLOOR.	85.586 SQ.M.
TOTAL UNDER CONC. B/UP AREA	134.811 SQ.M.
TOTAL COMPLETED + UNDER CONC B/UP AREA	392.236 SQ.M.

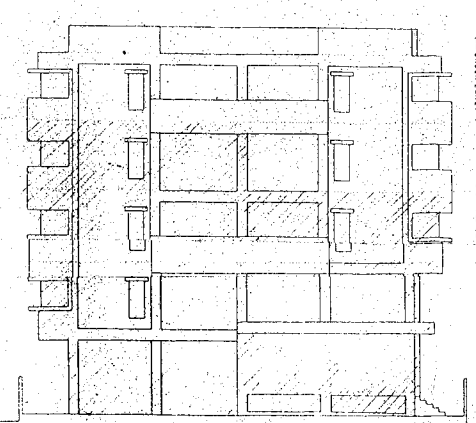

ELEVATION

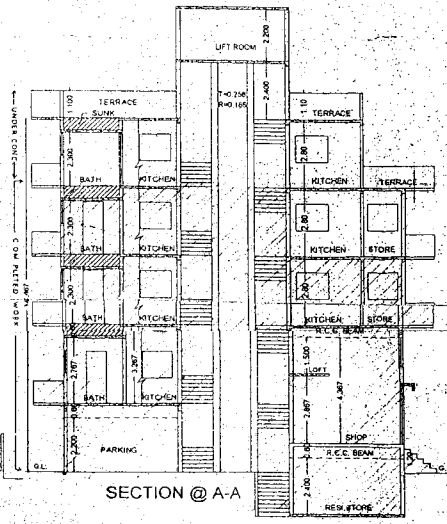

SECTION @ A-A

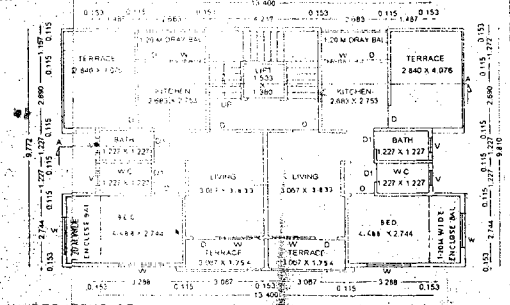

UNDER CONC OF FORTH FLOOR PLAN
SCALE : 1:100

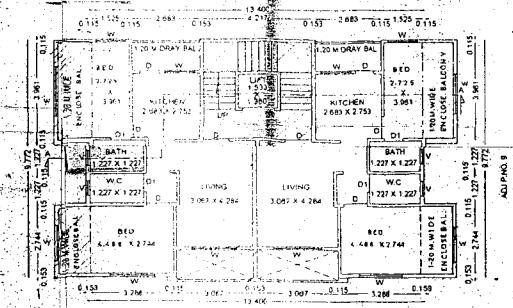

PART COMPLETED THIRD FLOOR PLAN AND PART UNDER CONC THIRD FLOOR PLAN.
SCALE : 1:100

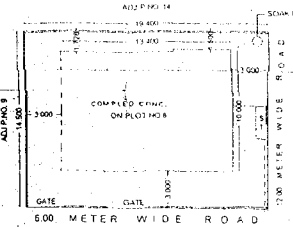

SITE PLAN
SCALE : 1:100

SCHEDULE OF OPENINGS

DOOR	SIZE	WINDOW	SIZE
RS	2.10 X 0.69	W	1.50 X 1.20
D	1.00 X 2.10	W1	1.20 X 1.20
D1	0.90 X 2.10	V	0.60 X 0.90
D2	0.75 X 2.10	V1	2.10 X 0.45

NOTE :
a) PLOT BOUNDRY SHOWN IN BLACK.
b) PROPOSED WORK SHOWN IN RED.
c) DAINAGE LINE SHOWN IN RED DOT.

OWNERS

REALTY SHAPERS

REALTY SHAPERS

STRUCTURAL DESIGNER

Mukund M. Khadke
Approved Structural Engineer L. No. 80
Structural Engineer L. No. 80
C. Engg., A. M. I. E.
Mob. Mukund Nagar, Pune 411037

DRAWN BY : VISHAL SONAWANE | SCALE : 1:100 | DATE :

ARCHITECT

ARCHITECTS
GIRISH TALELE & ASSOCIATES

GIRISH V. TALELE
11, Ramdas Colony, Behind Pravin Shoppy,
N.J. College to Collector Bungalow Road,
JALGAON 425 002 ☎ : 0257-2238745

GIRISH V. TALELE, Regd. No. CA/93/16196
11, RAMDAS COLANY, JALGAON.
REG. NO. CA / 93 / 16196

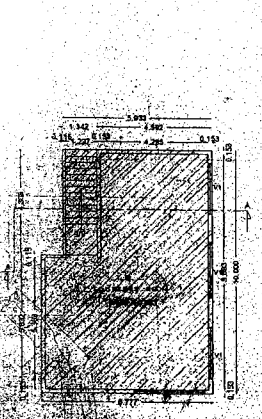

COMPLETED BASEMENT FLOOR PLAN
SCALE : 1:100

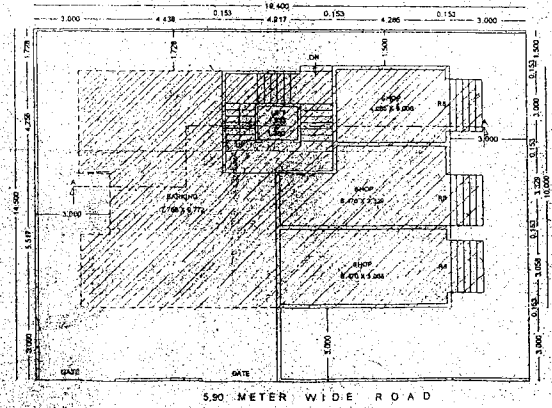

COMPLETED GROUND FLOOR PLAN
SCALE : 1:100

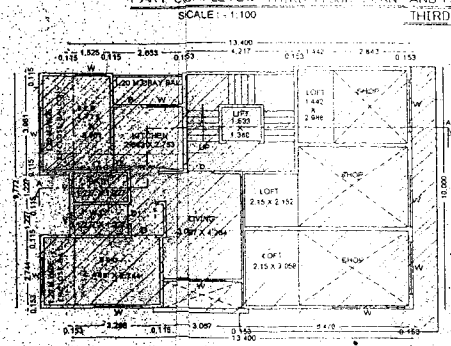

COMPLETED FIRST FLOOR PLAN
SCALE 1:100

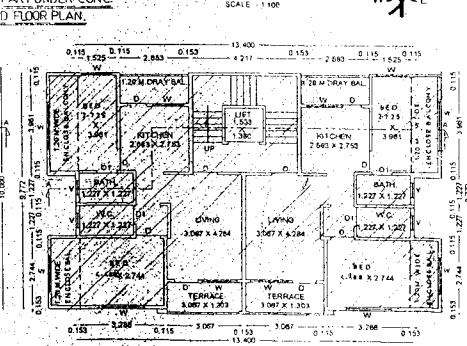

COMPLETED SECOND FLOOR PLAN
SCALE 1:100

NOTE: COMPLETED WORK SHOWN IN HATCH