
PROPOSED RESIDENTIAL CONSTRUCTION ON PLOT NO. 55 TO 63 OF G.NO. 604 AT BHADGAON, TAL - BADHGAON, DIST - JALGAON.

APPROVAL.


Approved for Residential Purpose only, Amendment Shown in Red, Subject to condition maintained in this office letter No. BBB/68 Date : 21/5/2018

CITI ENGINEER
Bhadgaon Municipal Council
Tal.Bhadgaon,Dist.Jalgaon

Chief Officer
Bhadgaon Municipal Council

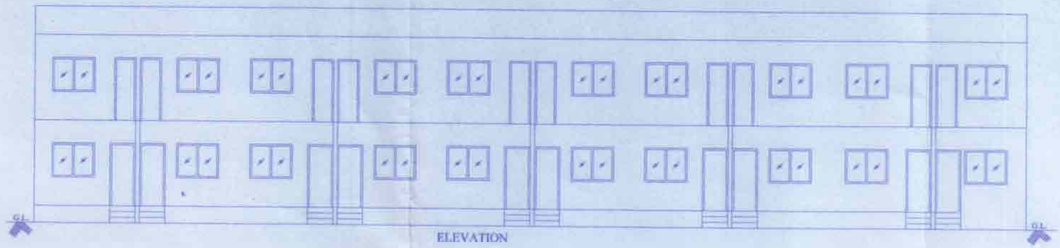

ELEVATION

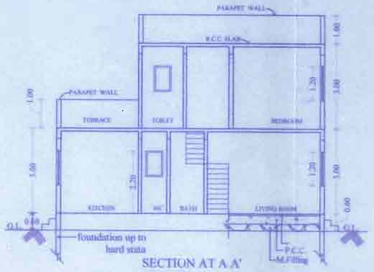


SECTION AT A A'
SCALE 1:100




LOCATION PLAN

Scale 1 : 10000

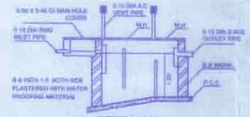


SECTION AT AA

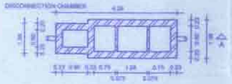


PLAN OF SEPTIC TANK



SECTION AA

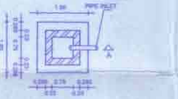

SOAK PIT DETAILS

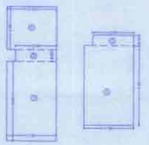

P.NO. 63
AREA DIAG. OF GROUND FLOOR
1 = 3.50 X 3.06 = 10.71
2 = 2.90 X 0.83 = 2.41
3 = 3.50 X 5.62 = 19.67

FIRST FLOOR
1 = 2.90 X 0.75 = 2.18
2 = 3.50 X 5.62 = 19.67


B/UP AREA ON GR. F. = 32.79
B/UP AREA ON F. F. = 21.85



P.NO. 56 TO 62
AREA DIAG. OF GROUND FLOOR
1 = 3.50 X 3.06 = 10.71
2 = 2.98 X 0.87 = 2.59
3 = 3.50 X 5.58 = 19.53

FIRST FLOOR
1 = 2.97 X 0.75 = 2.23
2 = 3.50 X 5.62 = 19.67


B/UP AREA ON GR. F. = 32.83
B/UP AREA ON F. F. = 21.90

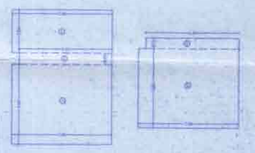


P.NO. 55
AREA DIAG. OF GROUND FLOOR
1 = 7.08 X 3.06 = 21.66
2 = 6.55 X 0.83 = 5.44
3 = 7.08 X 5.62 = 39.79

FIRST FLOOR
1 = 6.55 X 0.75 = 4.91
2 = 7.08 X 5.62 = 39.79

B/UP AREA ON GR. F. = 66.89
B/UP AREA ON F. F. = 44.70

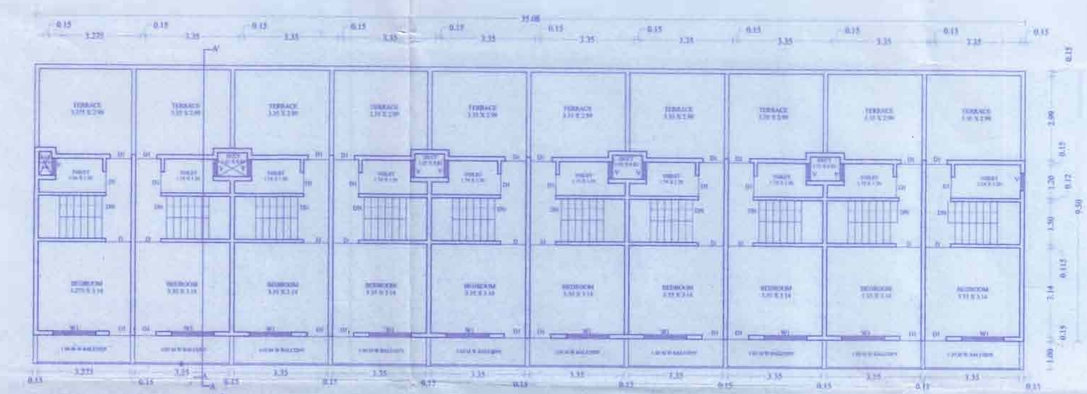


FIRST FLOOR PLAN
SCALE 1:100

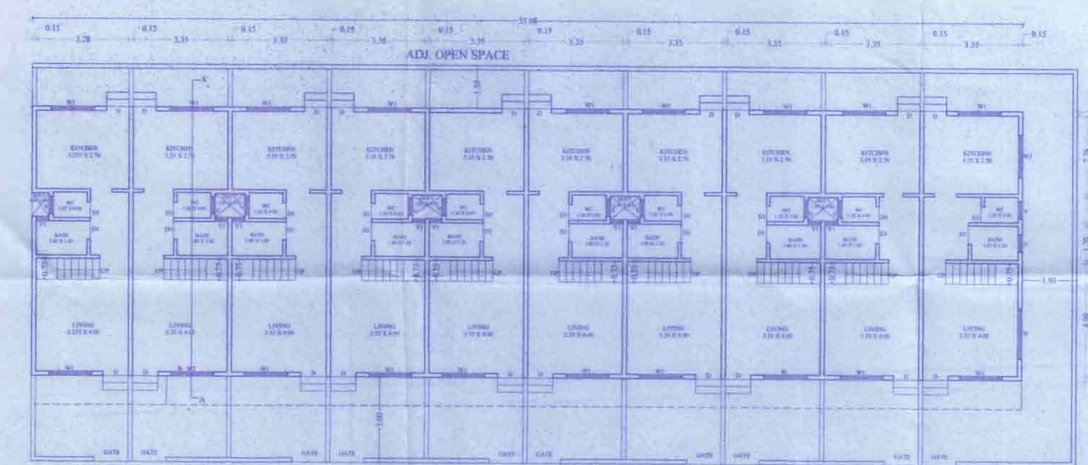

ADJ. OPEN SPACE

GROUND FLOOR PLAN
SCALE 1:100

9.00 M W ROAD

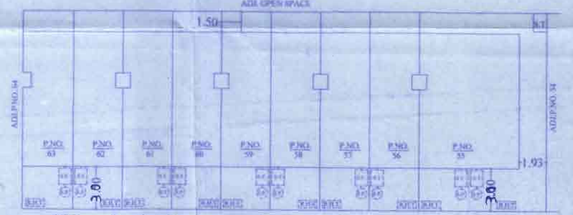

ADJ. OPEN SPACE

ADJ.P.NO.54

P.NO. 63 | P.NO. 62 | P.NO. 61 | P.NO. 60 | P.NO. 59 | P.NO. 58 | P.NO. 57 | P.NO. 56 | P.NO. 55

ADJ.P.NO.54

9.00 M W I D E R O A D

SITE PLAN
SCALE 1 : 200

SCHEDULE OF OPENING

TYPE	SIZE	SPECIFICATION
D D1	0.90 M X 2.20 M 0.75 M X 2.20 M	TEAK WOOD FRAME PANELED FLUSH DOOR AS PER DETAILS DRAWINGS.
W W1	1.80 M X 1.20 M 1.50 M X 0.75 M	TEAK WOOD OR MILD STEEL OR ALUMINIUM SLAIING
V V	0.60 M X 0.75 M 0.45 M X 0.75 M	TEAK WOOD OR M.S. GLAZED VENTILATORS

IMPORTANT NOTE:
OUR RESPONSIBILITY IS TO PROVIDE DRAWING ONLY .

WE SHALL NOT BE RESPONSIBLE FOR SITE SUPERVISION , ANY FAULTY EXECUTION, FAULTY MATERIAL , FAULTY CONSTRUCTION & TIME BOUND OF EXECUTION PRACTICES.

WE PREPARED MUNICIPAL DWG AS PROVIDED DOCUMENT BY OWNER

OWNER

ARCH / ENGI

STRUCTURAL DESIGNER	ARCHITECTS SIGN.
	(AR.BHAGYASHREE D. PATEL) REG.NO. CA/2014/84941

AREA STATEMENT

PLOT NO	PLOT AREA AS PER APPLICANT/ LAY OUT/ NET GR/ISS/ TS12	B/U AREA G.F.	B/U AREA F.F.	F.S.I. CONSUMED
55	126.00	66.89	44.70	0.89
56	49.00	32.83	21.90	1.12
57	49.00	32.83	21.90	1.12
58	49.00	32.83	21.90	1.12
59	49.00	32.83	21.90	1.12
60	49.00	32.83	21.90	1.12
61	49.00	32.83	21.90	1.12
62	49.00	32.83	21.90	1.12
63	49.00	32.79	21.85	1.12
TOTAL	518.00	329.49	219.85	-

PROPOSED RESIDENTIAL CONSTRUCTION ON PLOT NO. 115 TO 123 OF G.NO. 604 AT BHADGAON, TAL - BADHGAON, DIST - JALGAON.

APPROVAL.

Approved for Residential Purpose only.
Amendment Shown in Red. Sub [illegible] condation maintained in this office. [illegible]
No. BW/59 Date : 21/5/2018

CITY ENGINEER
Bhadgaon Municipal Council
Tal.Bhadgaon,Dist.Jalgaon

Chief Officer
Bhadgaon Municipal Council

ELEVATION

FIRST FLOOR PLAN
SCALE 1:100

ADJ. G.NO. 314

12.00 M W ROAD

GROUND FLOOR PLAN
SCALE 1:100

9.00 M W ROAD

PARAPET WALL
P.C.C. SLAB
TERRACE
TOILET
BEDROOM
KITCHEN
W.C.
BATH
LIVING ROOM
foundation up to hard stata
P.C.C.
M.Filling

SECTION AT A A'
SCALE 1:100

SECTION AT AA

PLAN OF SEPTIC TANK

SECTION A A

SOAK PIT DETAILS

LOCATION PLAN
Scale 1 : 10000

P.NO.115
AREA DIAG. OF GROUND FLOOR
1 = 2.98 X 9.50 = 28.31
2 = 1.05 X 3.06 = 3.21
3 = 1.05 X 5.62 = 5.90
4 = 3.05 X 9.50 = 28.98

FIRST FLOOR
1 = 3.05 X 6.26 = 19.05
2 = 1.05 X 5.62 = 5.90
3 = 3.05 X 6.37 = 19.43

B/UP AREA ON GR. F. = 66.40
B/UP AREA ON F. F. = 44.73

P.NO.117 TO 122
AREA DIAG. OF GROUND FLOOR
1 = 3.50 X 5.27 = 18.45
2 = 2.98 X 1.13 = 3.37
3 = 3.50 X 3.80 = 13.51

B/UP AREA ON GR. F. = 35.33

P.NO.116
AREA DIAG. OF GROUND FLOOR
1 = 3.50 X 5.27 = 18.45
2 = 2.98 X 1.13 = 3.37
3 = 3.50 X 3.85 = 13.48

B/UP AREA ON GR. F. = 35.30

P.NO.123
AREA DIAG. OF GROUND FLOOR
1 = 3.05 X 9.50 = 28.98
2 = 1.05 X 3.06 = 3.21
3 = 1.05 X 5.62 = 5.90
4 = 2.98 X 9.50 = 28.31

FIRST FLOOR
1 = 2.85 X 7.06 = 13.17
4 = 3.05 X 6.45 = 19.67
3 = 1.05 X 3.62 = 3.96
2 = 2.98 X 6.36 = 18.95

B/UP AREA ON GR. F. = 66.80
B/UP AREA ON F. F. = 55.09

AREA STATEMENT

PLOT NO.	PLOT AREA AS PER APPLICANT/ LAY OUT/ NET GROSS/ 7/12	B/U AREA G.F.	B/U AREA F.F.	F.S.I. CONSUMED
115	126.00	66.40	44.73	0.88
116	49.00	35.30	-	0.72
117	49.00	35.33	-	0.72
118	49.00	35.33	-	0.72
119	49.00	35.33	-	0.72
120	49.00	35.33	-	0.72
121	49.00	35.33	-	0.72
122	49.00	35.33	-	0.72
123	158.45	66.40	55.69	0.76
TOTAL	627.45	380.08	100.42	0.77

ADJ. G.NO. 314

12.00 M W ROAD

P.NO. 123 | P.NO. 122 | P.NO. 121 | P.NO. 120 | P.NO. 119 | P.NO. 118 | P.NO. 117 | P.NO. 116 | P.NO. 115

9.00 M W ROAD

SITE PLAN
SCALE 1 : 200

SCHEDULE OF OPENING

TYPE	SIZE	SPECIFICATION
D	0.90 M X 2.20 M	TEAK WOOD FRAME PANELED
D1	0.75 M X 2.20 M	FLUSH DOOR AS PER DETAILS DRAWINGS.
W	1.80 M X 1.20 M	TEAK WOOD OR MILD STEEL
W1	1.50 M X 0.75 M	OR ALUMINIUM SLEADING
V	0.60 M X 0.75 M	TEAK WOOD OR M.S. GLAZED
V	0.45 M X 0.75 M	VENTILATORS

IMPORTANT NOTE:

: OUR RESPONSIBILITY IS TO PROVIDE DRAWING ONLY .

: WE SHALL NOT BE RESPONSIBLE FOR SITE SUPERVISION , ANY FAULTY EXECUTION, FAULTY MATERIAL , FAULTY CONSTRUCTION & TIME BOUND OF EXECUTION PRACTICES.

: WE PREPARED MUNICIPAL DWG AS PROVIDED DOCUMENT BY OWNER

OWNER

ARCH / ENGI

STRUCTURAL DESIGNER	ARCHITECTS SIGN.
	I AR.BHAGYASHREE D. PATEL REG.NO. CA/2014/58841