

PROPOSED AMALGAMATION OF PLOT NO. 47 + 48 + 53 + 54 IN G.NO.117/2

AT.- PUNGAON, TAL.- PACHORA, DIST.- JALGAON.

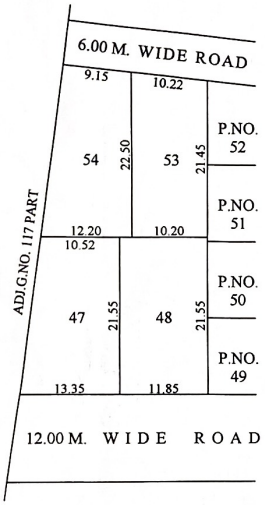

LAY OUT PLAN BEFORE AMALGAMATION

SCALE 1 : 500

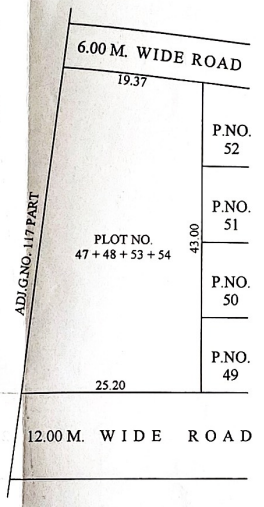

LAY OUT PLAN AFTER AMALGAMATION

SCALE 1 : 500

APPROVAL

Recommended for Approval for Amalgamation ~~and sub-division~~ for ....R.C.Residential..... purpose only as amended in Red Subject to conditions mentioned in this office L.No.3154.....Date 26/12/2019

TOWN PLANNING AND VALUATION DEPARTMENT GOVERNMENT OF MAHARASHTRA JALGAON BRANCH


Assistant Director of Town Planning, Jalgaon

या कार्यालयाचे आदेश ब्रा.जमिन/~~कामे~~/७४ २०१९ दि. २७/०१/२०२० नुसार ... परवानगी त्या ... देण्यात येत आहे.

SUB DIVISIONAL OFFICER उपविभागीय अधिकारी पाचोरा उप.विभाग PACHORA DIV. DIST. JA

पाचोरा भाग, पाचोरा

LOCATION PLAN

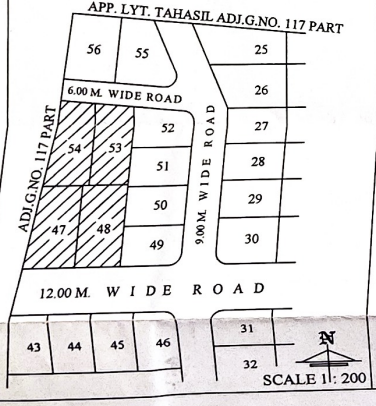

SCALE 1: 200

AREA STATEMENT

AREAOF PLOT BEFORE AMALGAMATION

PLOT NO ---- 47	257.20 SQ.M.
PLOT NO ---- 48	255.37 SQ.M.
PLOT NO ---- 53	224.15 SQ.M.
PLOT NO ---- 54	245.44 SQ.M.
TOTAL AREA OF P.NO. 47+48+53+54	982.16 SQ.M.

AREA OF PLOT AFTER AMALGAMATION

P.NO. 47+48+53+54	982.16 SQ.M.

SITE PLAN



SCALE 1:10000

OWNER

रमेश शंकरलाल सोर.

ARCH / ENGI

SUDHIRKUMAR G.WAGHULDE
A.D.T.P.OFFICE,Jalgaon
Licence Engineer L.No.03
'Rucha Shilp'
Teli Samaj Shopping Complex
Opp:Maheshwari Boarding,
JALGAON.Mob.9422292081

DRAWN BY - JAVED S. TADAVI
MOB. NO. 9422292081