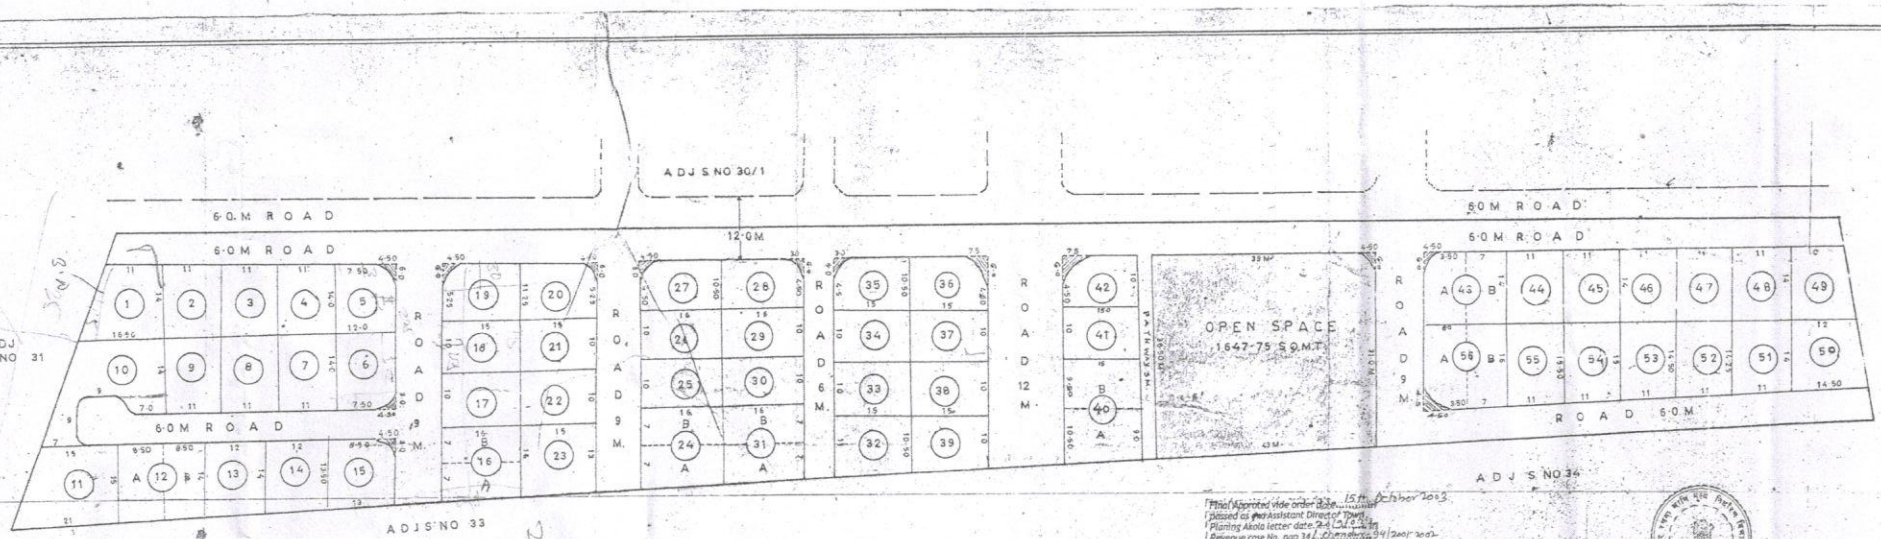


Final Approved vide order date 15th October 2013
passed as Assistant Director of Town
Planing Akola letter date 24/10/13
Revenue case No. nap 34/ Chandur 34/2007
subject to condition mentioned herein.

OFFICE OF THE SUB DIVISIONAL OFFICER AKOLA

Sub Divisional Officer
Akola

Recommanded for Final Approval
as amended in Akola Colour and
subject to Condition mentioned in
this Office Letter No. ...

Assistant Director of
Town Planning Akola

DEMARCAIED RESIDENTIAL LAY OUT IN S.NO.30/2
MOUJA CHANDUR TALUKA & DISST AKOLA

SCALE 1:500

STATEMENT OF AREA

	AREA IN S.Q.M.T.
TOTAL AREA OF RESIDENTIAL PLOTS	9636·716
TOTAL AREA OPEN SPACE	1647·075
TOTAL AREA OF ROADS/CURVATURE	~~5116·205~~
TOTAL AREA OF S.NO 30/2 P.T. CHANDUR	16400·00 (4 A)

SITE PLAN



SCALE 1:16000

SCHEDULE OF PLOTS

PLOT NO.	AREA IN S.Q.M.T.	AREA IN S.Q.F.T.	NO. OF PLOT	TOTAL AREA OF PLOTS	PLOT NO.	AREA IN S.Q.M.T.	AREA IN S.Q.F.T.	NO. OF PLOT	TOTAL AREA OF PLOTS
1	192·50	2073	1	192·50	31A	113·75	1224	1	113·75
2 TO 4	154·00	1657	3	462·00	31B	109·687	1180	1	109·687
5	154·95	1667	1	154·95	32	163·125	1755	1	163·125
6	157·86	1698	1	157·86	33,34	150·00	1614	2	300·00
7 TO 9	154·00	1657	3	462·00	35	156·41	1683	1	156·41
10	276·50	2975	1	276·50	36	150·53	1619	1	150·53
11	273·00	2937	1	273·00	37 TO 39	150·00	1614	3	450·00
11A	120·57	1297	1	120·57	40A	138·75	1493	1	138·75
12B	119·51	1286	1	119·51	40B	142·50	1533	1	142·50
13	165·00	1775	1	165·00	41	150·00	1614	1	150·00
14	159·00	1710	1	159·00	42	150·53	1619	1	150·53
15	162·61	1749	1	162·61	43A	112·95	1215	1	112·95
16A	101·25	1089	1	101·25	43B	112·00	1205	1	112·00
16B	105·00	1130	1	105·00	44 TO 47	154·00	1657	4	616·00
17, 18	150·00	1614	2	~~300·00~~	48,49	161·[illegible]	[illegible]	[illegible]	~~[illegible]~~
19	163·91	1763	1	163·91	50	185·625	1997	1	185·625
20	162·70	1750	1	162·70	51	158·125	1701	1	158·125
21, 22	150·00	1614	2	300·00	52	156·75	1686	1	156·75
23	196·875	2118	1	196·875	53	162·25	1745	1	162·25
24A,24B	117·612	1267	2	235·624	54	167·75	1805	1	167·75
25, 26	150·312	1617	2	300·624	55	173·25	1864	1	173·25
27	156·45	1683	1	156·45	56A	129·00	1388	1	129·00
28	157·66	1696	1	157·66	56B	134·837	1450	1	134·837
29, 30	150·312	1617	2	300·624	TOTAL		103691	63	9636·716

Makarand Pande
Civil Engr.
"Shanti Niketan",
Raut wadi, AKOLA
Phone : 455120
Mobile : 9823174133
ENGINEER

OWNERS SIGN

1) Leena
2) D. P. Non
3)