

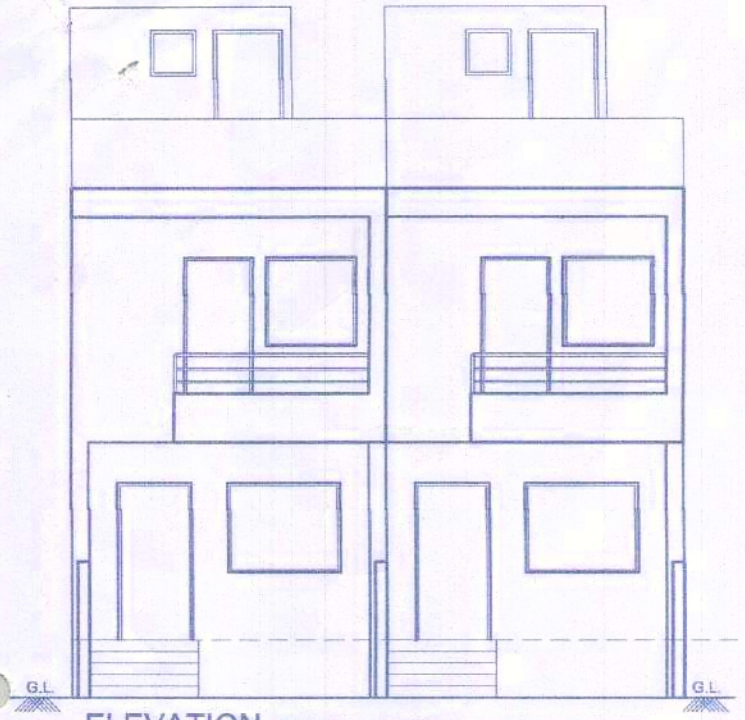



ELEVATION SCALE - 1:100

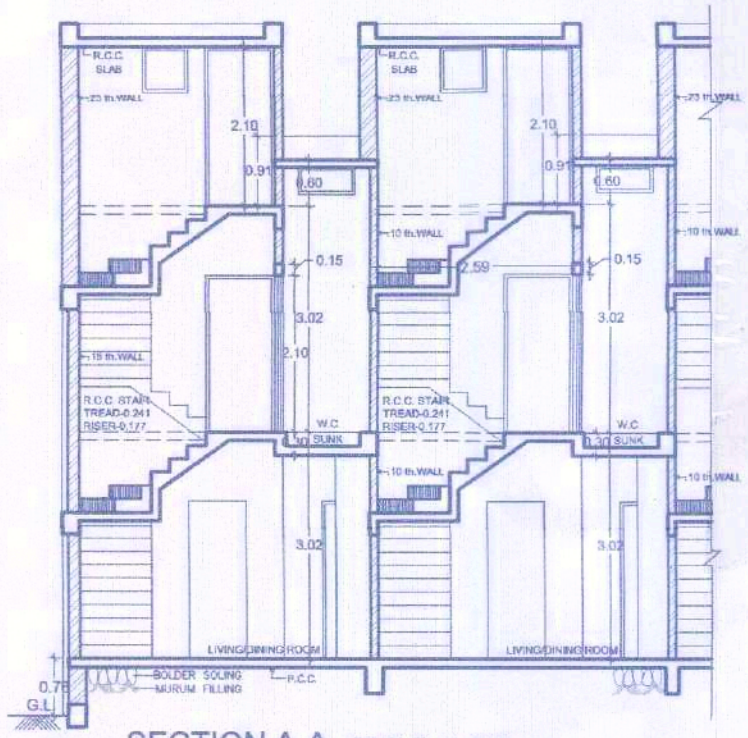

SECTION A-A SCALE - 1:100

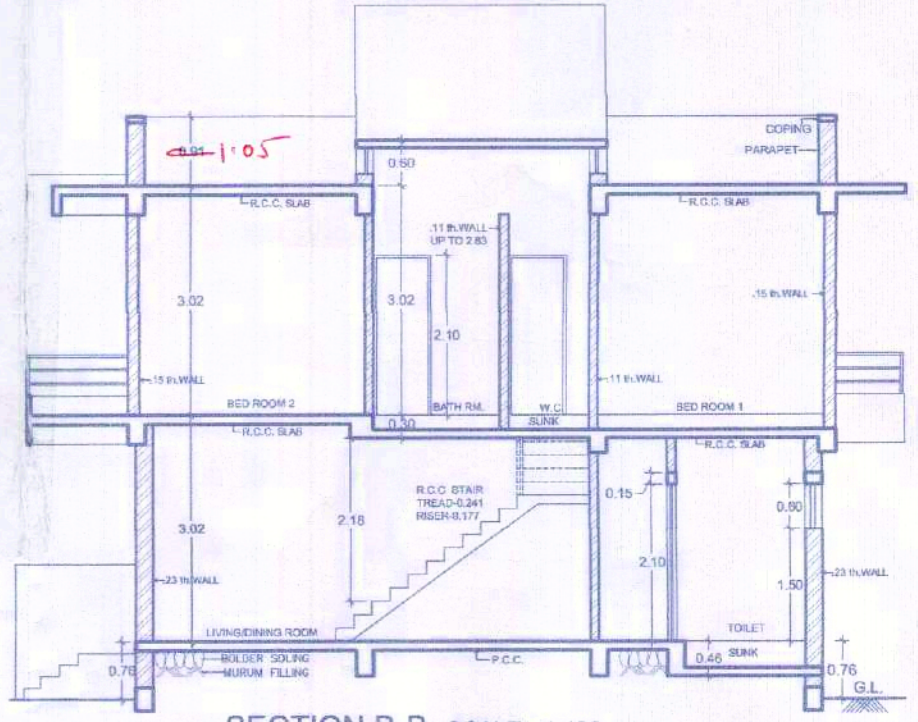


SECTION B-B SCALE - 1:100

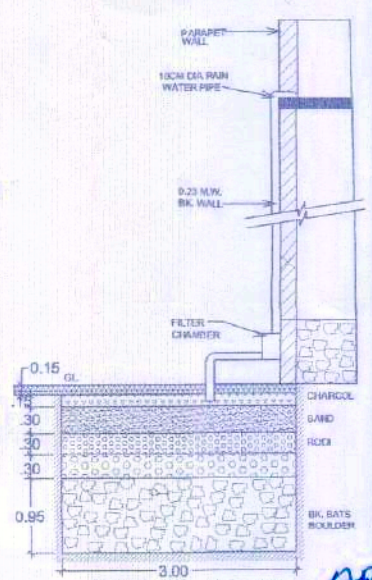


SECTION OF PROPOSED RAIN WATER HARVESTING SOAK PIT


Approved

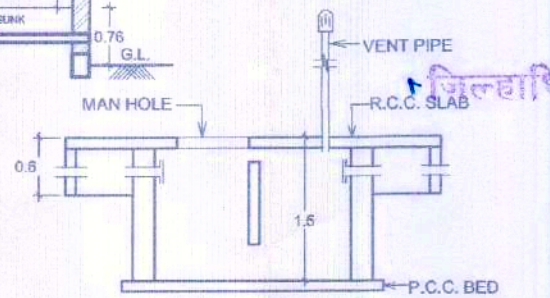


SECTION

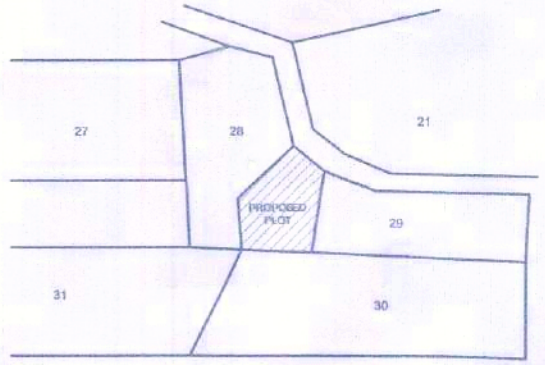

LOCATION PLAN

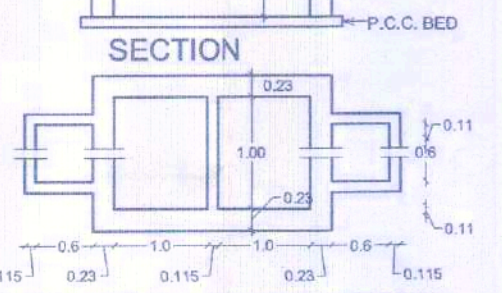


PLAN DETAIL OF SEPTIC TANK

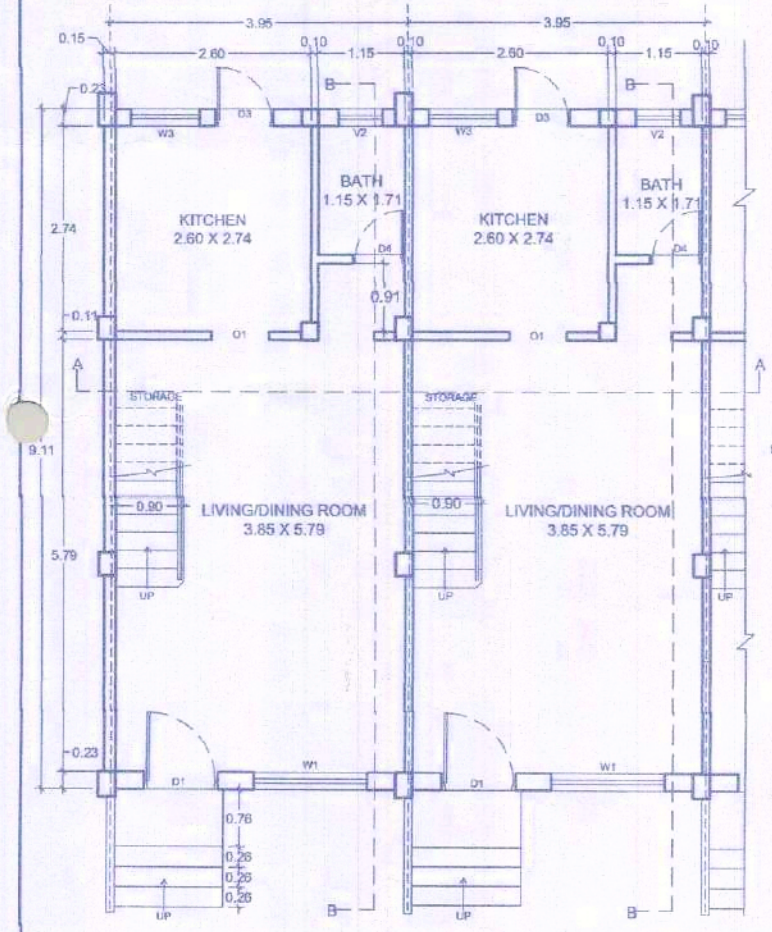


GROUND FLOOR PLAN SCALE - 1:100

TYPICAL ROW HOUSE

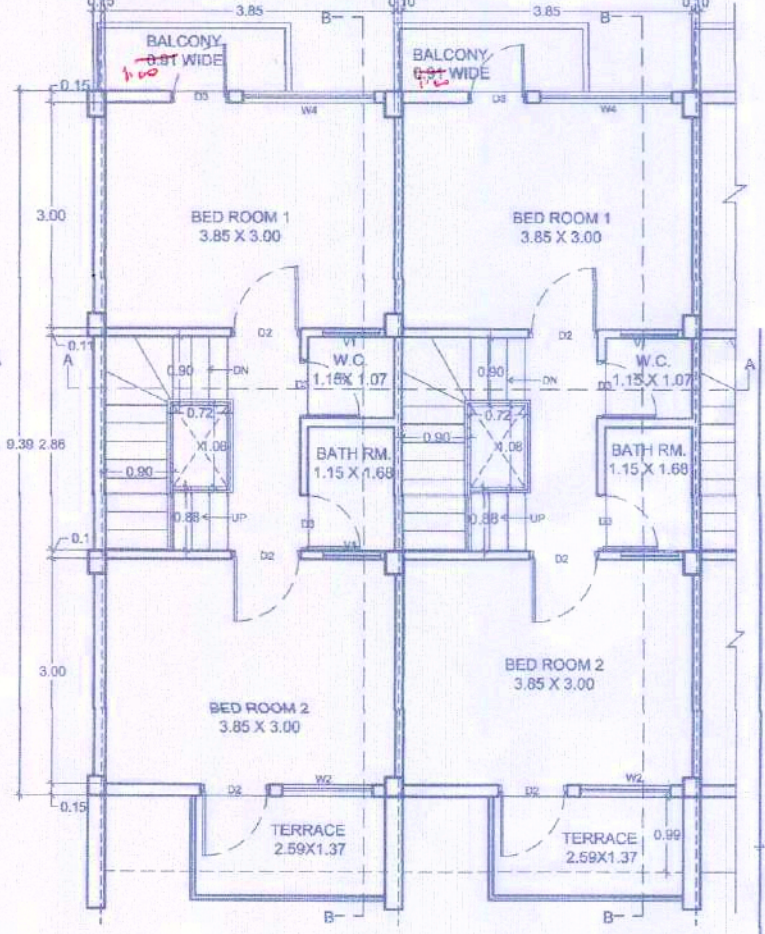

FIRST FLOOR PLAN SCALE - 1:100

TYPICAL ROW HOUSE

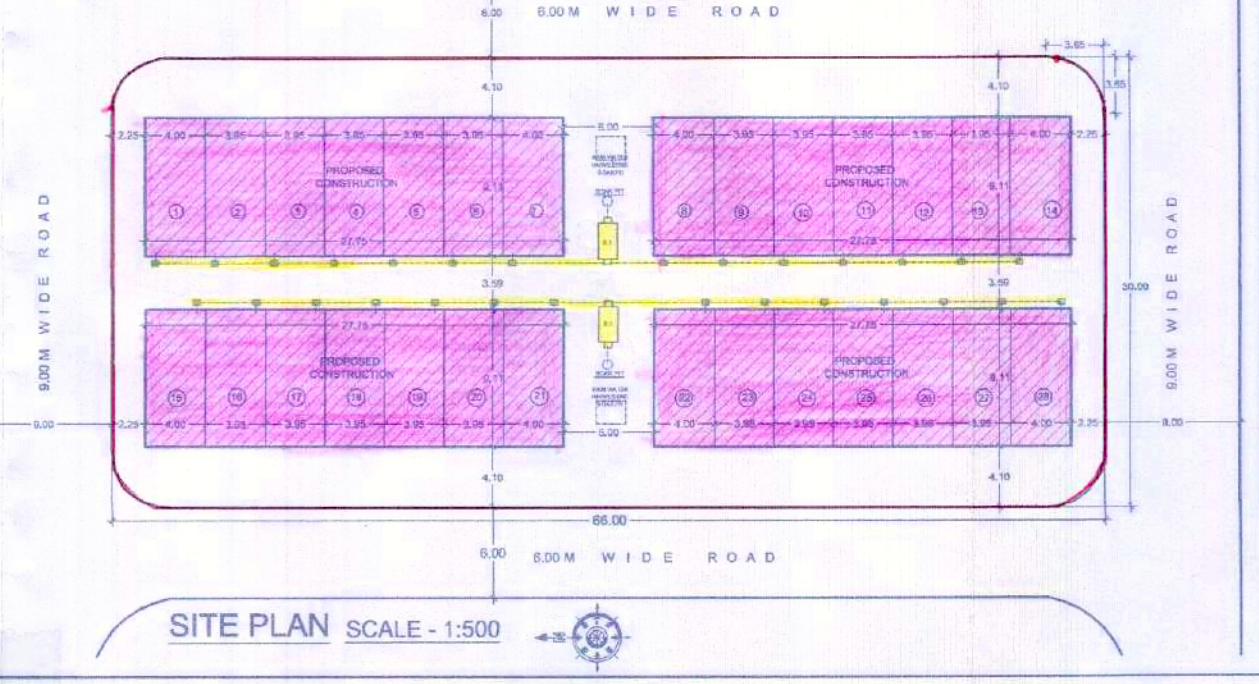

SITE PLAN SCALE - 1:500

PROPOSED ROW HOUSING SCHEME ON AMALGAMATED PLOT NOS. 16 TO 27, S.NO.29/1, MAUJA CHANDUR, TAL., DIST. AKOLA FOR MR. PURUSHOTTAM MALANI

upto plinth level

Recommended for Approval as ammended in....Red.... Colour & Subject to conditions mentioned in this office letter No...92..... 10/1/17

Assistant Director of Town Planning, Akola

SANCTIONING AUTHOURITY

जिल्हाधिकारी,अकोला.

AREA STATEMENT

AREA OF PLOT	1967.40 SQ.MTRS.
BUILT UP AREA	
GROUND FLOOR	1007.16 SQ.MTRS.
FIRST FLOOR	1016.84 SQ.MTRS.
TOTAL (G.F.+F.F.)	2024.00 SQ.MTRS.

NOTES-

PLOT BOUNDRY SHOWN IN RED
PROP. CONSTRUCTION SHOWN IN PINK
DRAINAGE LINE SHOWN IN YELLOW

SCHEDULE OF OPENINGS

ITEM	SIZE	DESCRIPTION
D1	0.99X2.10	T.W. DOOR
D2	0.90X2.10	T.W. DOOR
D3	0.75X2.10	T.W. DOOR
D4	0.69X2.10	T.W. DOOR
O1	0.75X2.10	OPENING
W1	1.50X1.20	ALU. WINDOW
W2	1.20X1.20	ALU. WINDOW
W3	0.90X1.20	ALU. WINDOW
W4	1.60X1.20	ALU. WINDOW
V1	0.75X0.35	ALU. VENTILATOR
V2	0.60X0.60	ALU. VENTILATOR

ARCHITECT | OWNER

ASHOK ZAMWAR AND ASSO.
ARCHITECTS AND REGD. VALUERS,
RATANLAL PLOTS, AKOLA
REGD. No. CA/81/6599