
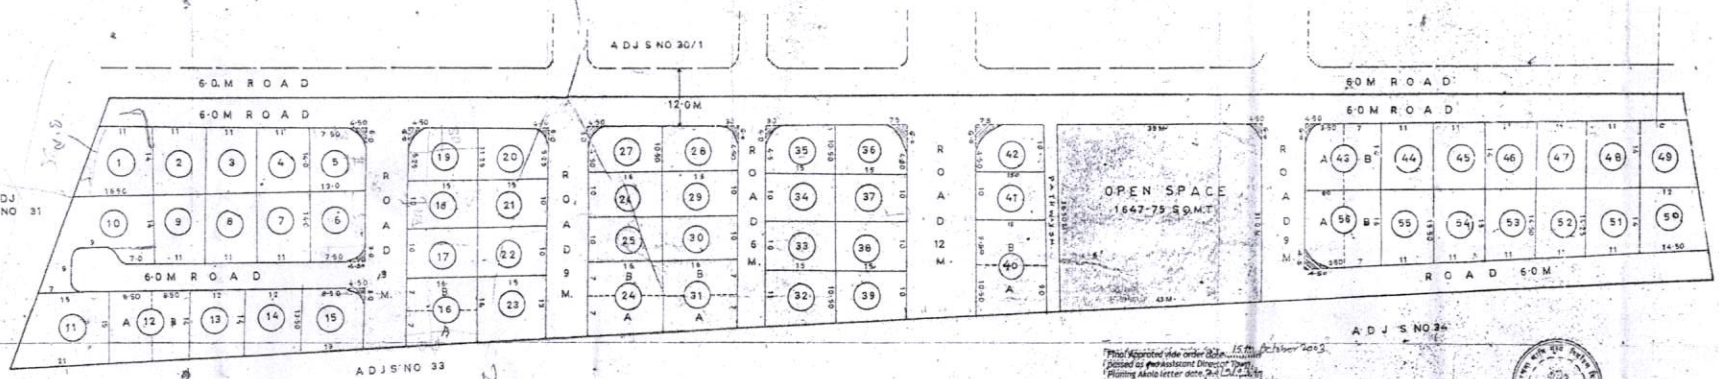


DEMARCATED RESIDENTIAL LAY OUT IN S.NO.30/2
MOUJA CHANDUR TALUKA & DISST AKOLA

SCALE 1:500

STATEMENT OF AREA — AREA IN S.Q.M.T.

TOTAL AREA OF RESIDENTIAL PLOTS	9636·716
TOTAL AREA OPEN SPACE	1647·075
TOTAL AREA OF ROADS/CURVATURE	~~5116·209~~ 5116·209
TOTAL AREA OF S.NO 30/2 P.T. CHANDUR	16400·00 (4 A)

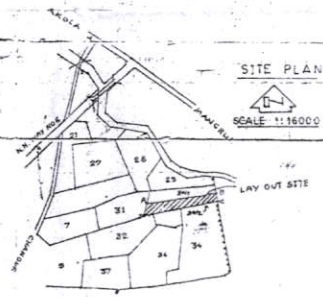

SITE PLAN
SCALE 1:16000

SCHEDULE OF PLOTS

PLOT NO.	AREA IN S.Q.M.T.	AREA IN S.Q.F.T.	NO. OF PLOT	TOTAL AREA OF PLOTS	PLOT NO.	AREA IN S.Q.M.T.	AREA IN S.Q.F.T.	NO. OF PLOT	TOTAL AREA OF PLOTS
1	192·50	2073	1	192·50	31A	113·75	1224	1	113·75
2 TO 4	154·00	1657	3	462·00	31B	109·687	1180	1	109·687
5	154·95	1667	1	154·95	32	163·125	1755	1	163·125
6	157·86	1698	1	157·86	33,34	150·00	1614	2	300·00
7 TO 9	154·00	1657	3	462·00	35	156·41	1683	1	156·41
10	276·50	2975	1	276·50	36	150·53	1619	1	150·53
11	273·00	2937	1	273·00	37 TO 39	150·00	1614	3	450·00
11A	120·57	1297	1	120·57	40A	138·75	1493	1	138·75
12B	119·51	1286	1	119·51	40B	142·50	1533	1	142·50
13	165·00	1775	1	165·00	41	150·00	1614	1	150·00
14	159·00	1710	1	159·00	42	150·53	1619	1	150·53
15	162·61	1749	1	162·51	43A	112·95	1215	1	112·95
16A	101·25	1089	1	101·25	43B	112·00	1205	1	112·00
~~16B~~	~~105·00~~	~~1130~~	~~1~~	~~105·00~~	44 TO 47	154·00	1657	4	616·00
17,18	153·00	1614	2	300·00	48,49	151·[illegible]	[illegible]	-	[illegible]
19	163·91	1763	1	163·91	50	185·625	1997	1	185·625
20	162·70	1750	1	152·70	51	158·125	1701	1	158·125
21,22	150·00	1614	2	300·00	52	156·75	1686	1	156·75
23	196·875	2118	1	196·875	53	162·25	1746	1	162·25
24A,24B	117·912	1267	2	235·824	54	167·75	1805	1	167·75
25,26	150·312	1617	2	300·62	55	173·25	1864	1	173·25
27	156·45	1683	1	156·45	56A	129·00	1388	1	129·00
28	157·66	1696	1	157·66	56B	134·937	1450	1	134·937
29,30	150·312	1617	2	300·624	TOTAL		103691	63	9638·716

Final Approval vide order date ..... 15th October 2015
passed as recommend Director Town Planning Akola letter date 2-5-2015
Revenue case No. nap 34/Chandur/34/Sanction/2015
subject to condition mentioned herein.

Sub Divisional Officer
Akola

Recommended for Final Approval as amended in Sheet ... Colour and subject to condition mentioned in this Office Letter No. ...
Dated the 30/4/2015

Assistant Director of Town Planning Akola

Makarand Pande
Civil Engg.
"Shanti Niketan",
Raut wadi, AKOLA
Phone : 455120
Mobile : 09371742133

ENGINEER

OWNERS SIGN

1) Leena S Gujar
2) D. P. Nand
3) Gujarathi