FLOOR WISE FSI STATEMENT: A (R-BUILDING)

FLOORS	FSI AREA				EXISTING FSI AREA				BALCONY					PASSAGE	STAIR	LIFT	TENEMENTS	TOTAL
	COMM.	RESI.	IND.	SPEC.	COMM.	RESI.	IND.	SPEC.	OPEN	ENC.	TOTAL	FREE15%EXCESS						FSI AREA
TERRACE FLOOR	0.00	0.00	0.00	0.00	0.00	0.00	0.00	0.00	0.00	0.00	0.00	0.00	0.00	0.00	0.00	0.00	0	0.00
THIRD FLOOR	0.00	226.90	0.00	0.00	0.00	0.00	0.00	0.00	30.15	0.00	30.15	34.04	0.00	0.00	0.00	0.00	5	226.90
SECOND FLOOR	0.00	330.12	0.00	0.00	0.00	0.00	0.00	0.00	47.68	0.00	47.68	49.52	0.00	0.00	0.00	0.00	8	330.12
FIRST FLOOR	0.00	330.12	0.00	0.00	0.00	0.00	0.00	0.00	47.68	0.00	47.68	49.52	0.00	0.00	0.00	0.00	8	330.12
GROUND FLOOR	0.00	28.39	0.00	0.00	0.00	0.00	0.00	0.00	0.00	0.00	0.00	0.00	0.00	0.00	0.00	0.00	0	28.39
Total	0.00	915.54	0.00	0.00	0.00	0.00	0.00	0.00	125.51	0.00	125.51	133.07	0.00	0.00	0.00	0.00	21	915.54

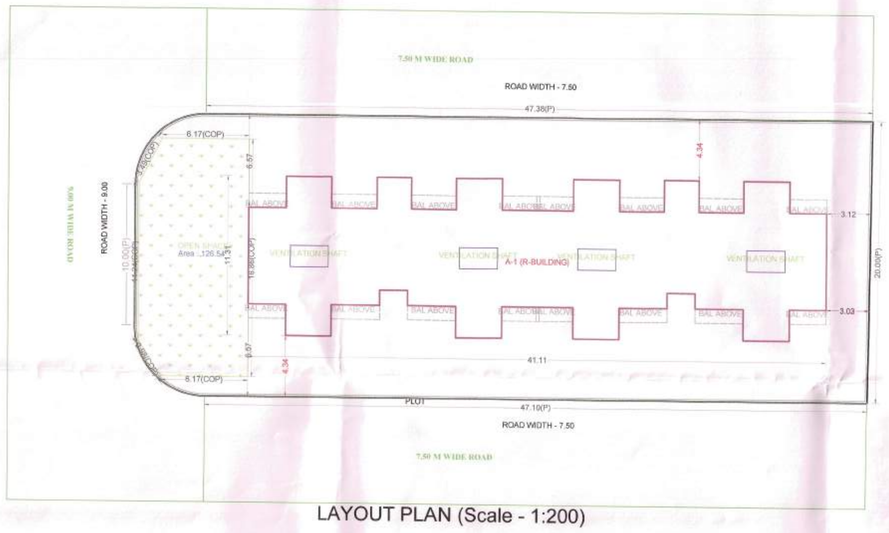

LAYOUT PLAN (Scale - 1:200)

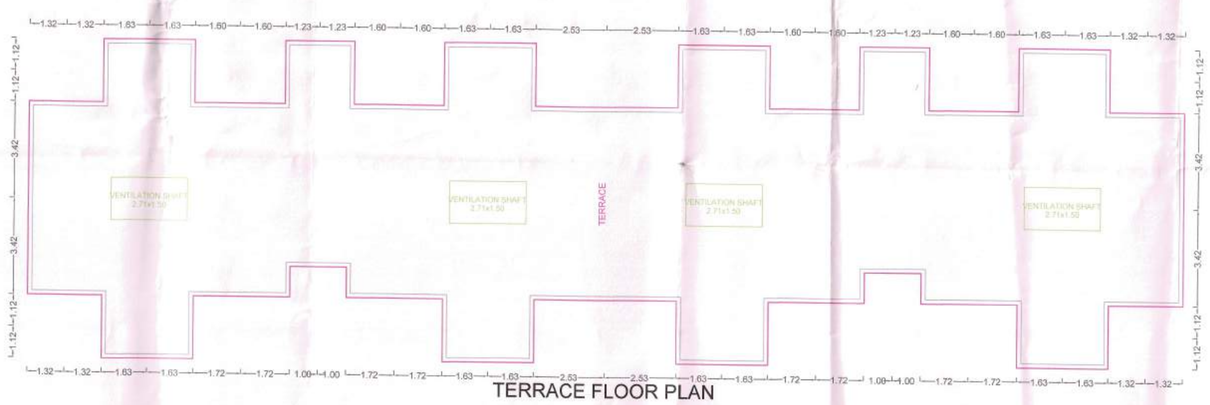

TERRACE FLOOR PLAN

BALCONY CALCULATIONS: A (R-BUILDING)

FLOOR	SIZE	AREA	TOT. AREA
THIRD FLOOR	1.00 X 2.65 X 5	13.25	30.17
	1.00 X 3.20 X 1	3.20	
	1.00 X 3.43 X 4	13.72	
SECOND FLOOR	1.00 X 2.65 X 8	21.20	47.72
	1.00 X 3.20 X 4	12.80	
	1.00 X 3.43 X 4	13.72	
FIRST FLOOR	1.00 X 2.65 X 8	21.20	47.72
	1.00 X 3.20 X 4	12.80	
	1.00 X 3.43 X 4	13.72	
Total	-	-	125.51

SCHEDULE OF OPENING: A (R-BUILDING)

NAME	LENGTH	HEIGHT	NOS.
D1	0.75	2.10	42
D	0.90	2.10	105
O	0.90	2.10	21

SCHEDULE OF OPENING: A (R-BUILDING)

NAME	LENGTH	HEIGHT	NOS.
V	0.60	0.60	42
W2	1.00	1.20	21
W1	1.20	1.20	42
W	1.50	1.20	35

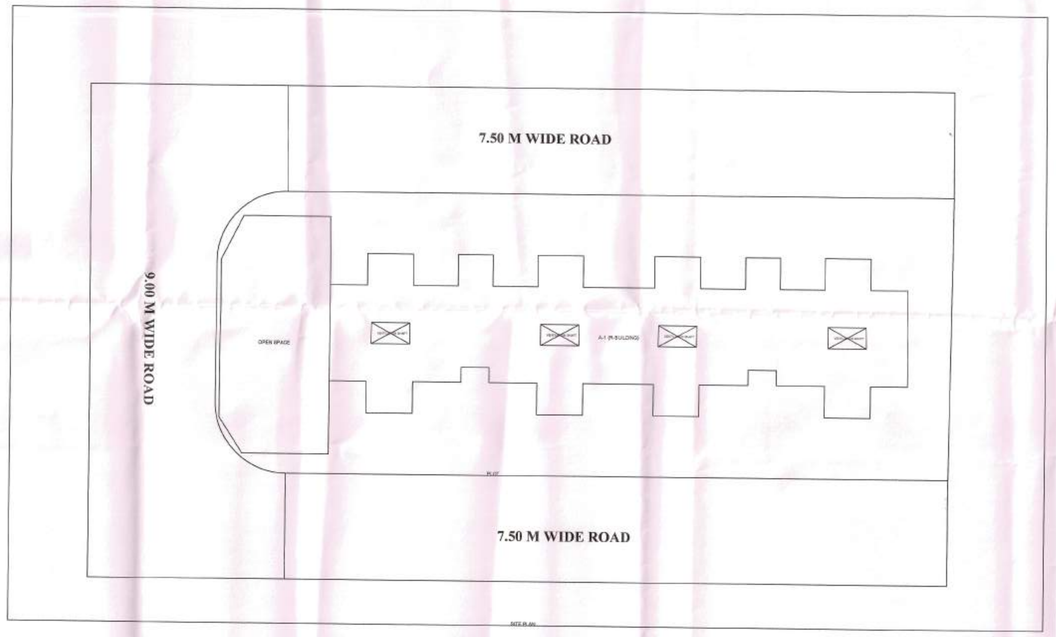

SEAL OF APPROVAL

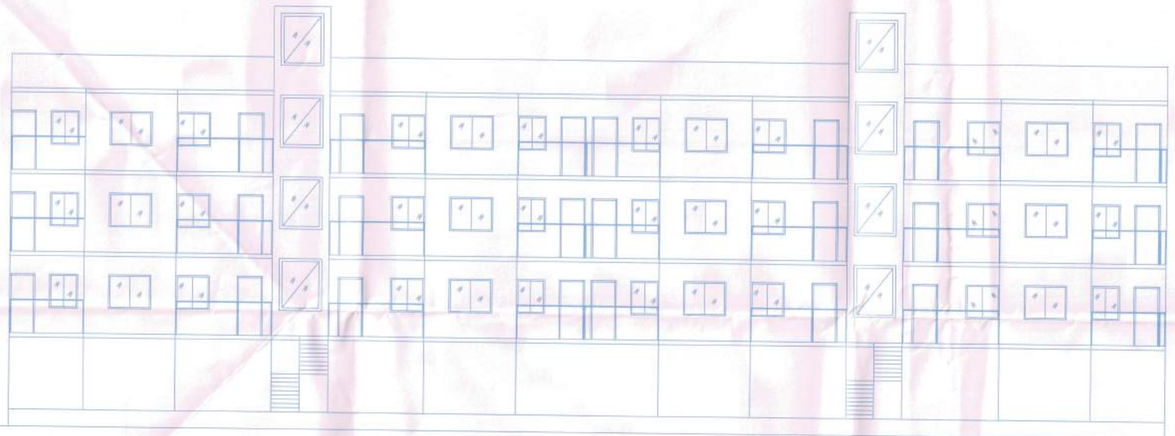

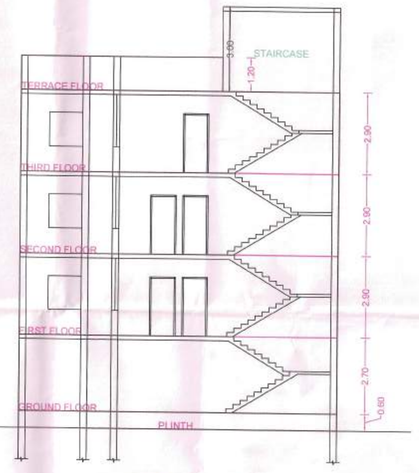

SECTION

A-301	0.50
A-302	0.50
A-303	0.50
A-304	0.50
A-305	0.50
A-306	0.50
A-307	1.04
A-308	0.50
A-309	0.50
A-310	473.80
A-311	471.00
Total (PLOT)	1034.07

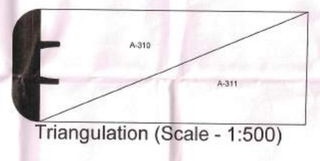

Triangulation (Scale - 1:500)

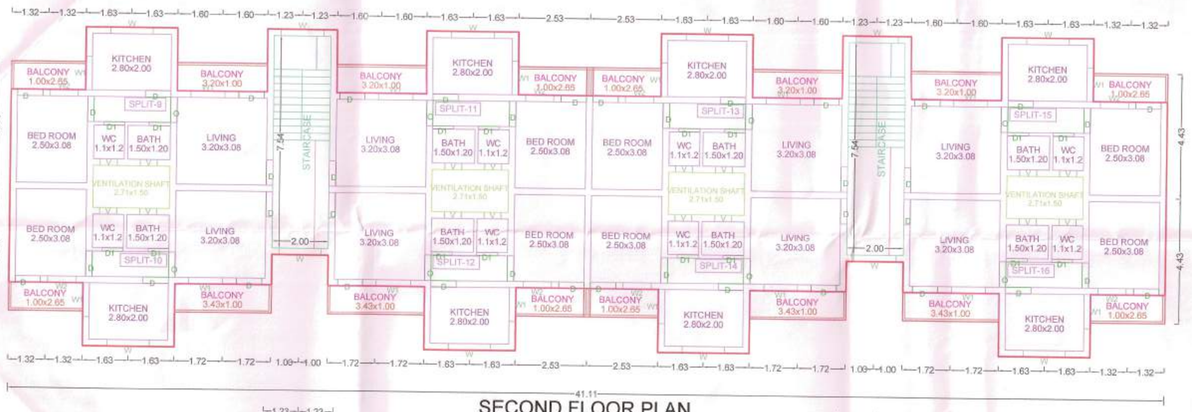

SECOND FLOOR PLAN

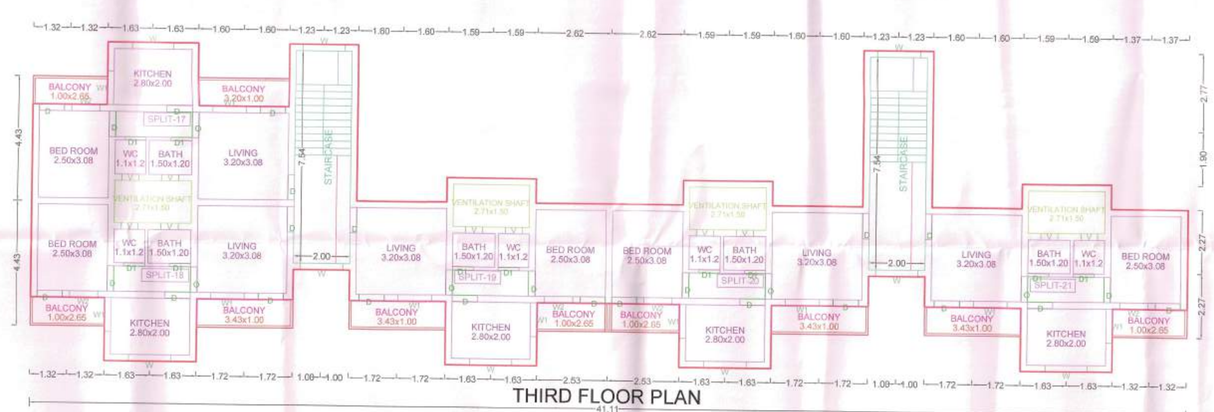

THIRD FLOOR PLAN

GROUND FLOOR PLAN

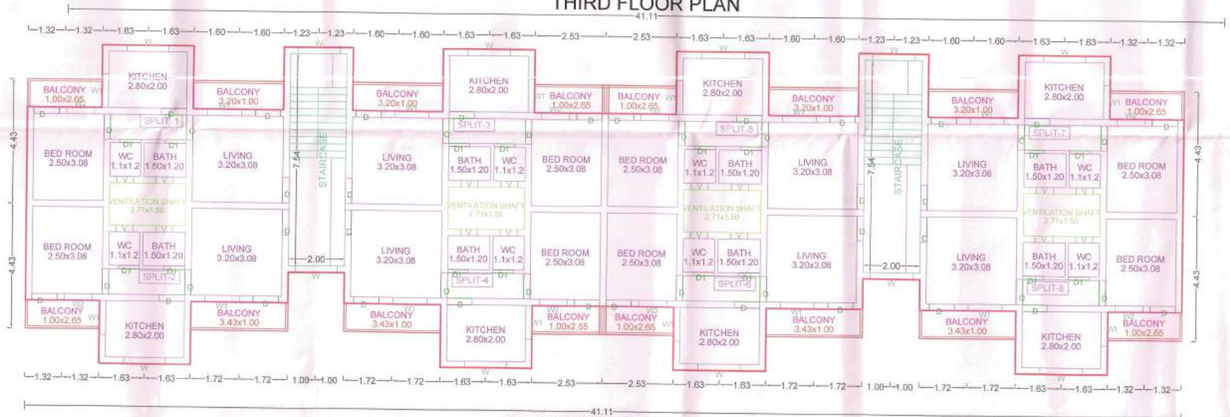

FIRST FLOOR PLAN

BUILDING WISE FSI STATEMENT

BUILDING	FSI AREA				EXISTING FSI AREA				BALCONY					PASSAGE	STAIR	LIFT	TENEMENTS	TOTAL
	COMM.	RESI.	IND.	SPEC.	COMM.	RESI.	IND.	SPEC.	OPEN	ENC.	TOTAL	FREE15%EXCESS						FSI AREA
A-1 (R-BUILDING)	0.00	915.54	0.00	0.00	0.00	0.00	0.00	0.00	125.51	0.00	125.51	133.07	0.00	0.00	0.00	0.00	21	915.54
Total	0.00	915.54	0.00	0.00	0.00	0.00	0.00	0.00	125.51	0.00	125.51	133.07	0.00	0.00	0.00	0.00	21	915.54

Valid for Proposed Construction Only!

दिनांक: 20.6.2017
ते आरेखनाचे इमारत परवानगी व सीसी पत्रासाठी
अ.प्रा.प्रा/सह्यर/40/ए.0510 दि. 3.7.2017
वर्गीय अकौन अनुसरण

Assistant Architect and Planner
Amravati Housing & Area Development Board,
AMRAVATI.

Chief Officer
Amravati Housing & Area Development Board
AMRAVATI.

AREA STATEMENT			SQ.M.
1. AREA OF PLOT			1034.07
2. DEDUTIONS (From Gross Plot Area)			
(a) ROAD SETBACK AREA (RW)			0.00
(b) OTHERS			000.00
Total (a+b)			0.00
3. BALANCE PLOT AREA			1034.07
4. PERMISSIBLE FSI FACTOR			1·10 ~~1.0000~~
PERMISSIBLE BUILT UP AREA			1137.47 ~~1034.07~~
5. TDR AREA			0.00
6. SPECIAL CASES FSI			0.00
7. TOTAL PERMISSIBLE BUILT UP AREA			1034.07
8. PROPOSED AREAS			
(a) PROPOSED RESIDENTIAL AREA			915.54
(b) PROPOSED COMMERCIAL AREA			0.00
(c) PROPOSED INDUSTRIAL AREA			0.00
(d) PROPOSED SPECIAL USE AREA			0.00
TOTAL PROPOSED AREA (a+b+c+d)			915.54
9. BALCONY AREA TAKEN IN FSI			0.00
10. EXISTING BUILT UP AREA			0.00
11. OTHERS (SUBSTRUCTURE/PROJECTIONS)			0.00
12. TOTAL BUILT UP AREA PROPOSED (8+9+10+11)			915.54
13. CONSUMED FSI			0.89
14. PARKING STATEMENT	CAR	SCOOTER	CYCLE
(a)PARKING REQUIRED NOs.	0	42	42
(b)PARKING REQUIRED AREA	0.00	126.00	58.80
(c)PARKING PROPOSED NOs.	0	43	80
(d)PARKING PROPOSED AREA	0.00	129.00	112.00

SPECIFICATIONS

Incharge: Amravati AutoDCR Cell | Signature:

CERTIFICATE OF AREA

CERTIFIED THAT I HAVE SURVEYED THE PLOT UNDER REFERENCE ON _____ AND THAT THE DIMENTIONS OF THE SIDES, ETC. OF THE PLOT STATED ON THE PLAN ARE AS MEASURED ON THE SITE AND THE AREA SO WORKED OUT IS _____ SQUARE METRES AND TALLIES WITH THE AREA STATED IN THE DOCUMENT OF OWNERSHIP / TOWN PLANNING SCHEME RECORDS.

SIGN OF ARCHITECT/ENGINEER/SUPERVISOR

LEGEND

PLOT BOUNDARY SHOWN THICK BLACK	
PROPOSED WORK SHOWN RED FILLED IN	
DRAINAGE LINE SHOWN RED DOTTED	
WATERLINE SHOWN BLUE DOTTED	
EXISTING TO BE RETAINED HATCHED	
DEMOLISHION SHOWN HATCHED YELLOW	

OWNER'S NAME

CEO MHADA

PROJECT INFORMATION

PLOT NO : R | SURVEY NO.: 56/A,57/1,58
VILLAGE : Akoli | LOCATION : Non-Congested

PROJECT TYPE: Proposed Development [Residential]

CONSULTANT NAME

Rajendra Ramdeorao Gattani(Architect)
Regd. No. : CA/86/12346
Near Ekvira devi, Mangkaryalaya
Janardhan peth, Amravati,Janardhan peth,
Amravati.

JOB NO.	DRG.NO.	SCALE	DRAWN BY	CHECKED BY
		1:100		
INWARD NO.	AMC/TEMP/878716	DATE	05-08-2016	
KEY NO.	¥¤§_©¤'	SHEET NO.	1/1	

This is a system generated drawing as per the soft copy submitted by the Architect/ License Engineer

PRODUCED BY AN AUTODESK EDUCATIONAL PRODUCT
PRODUCED BY AN AUTODESK EDUCATIONAL PRODUCT
PRODUCED BY AN AUTODESK EDUCATIONAL PRODUCT