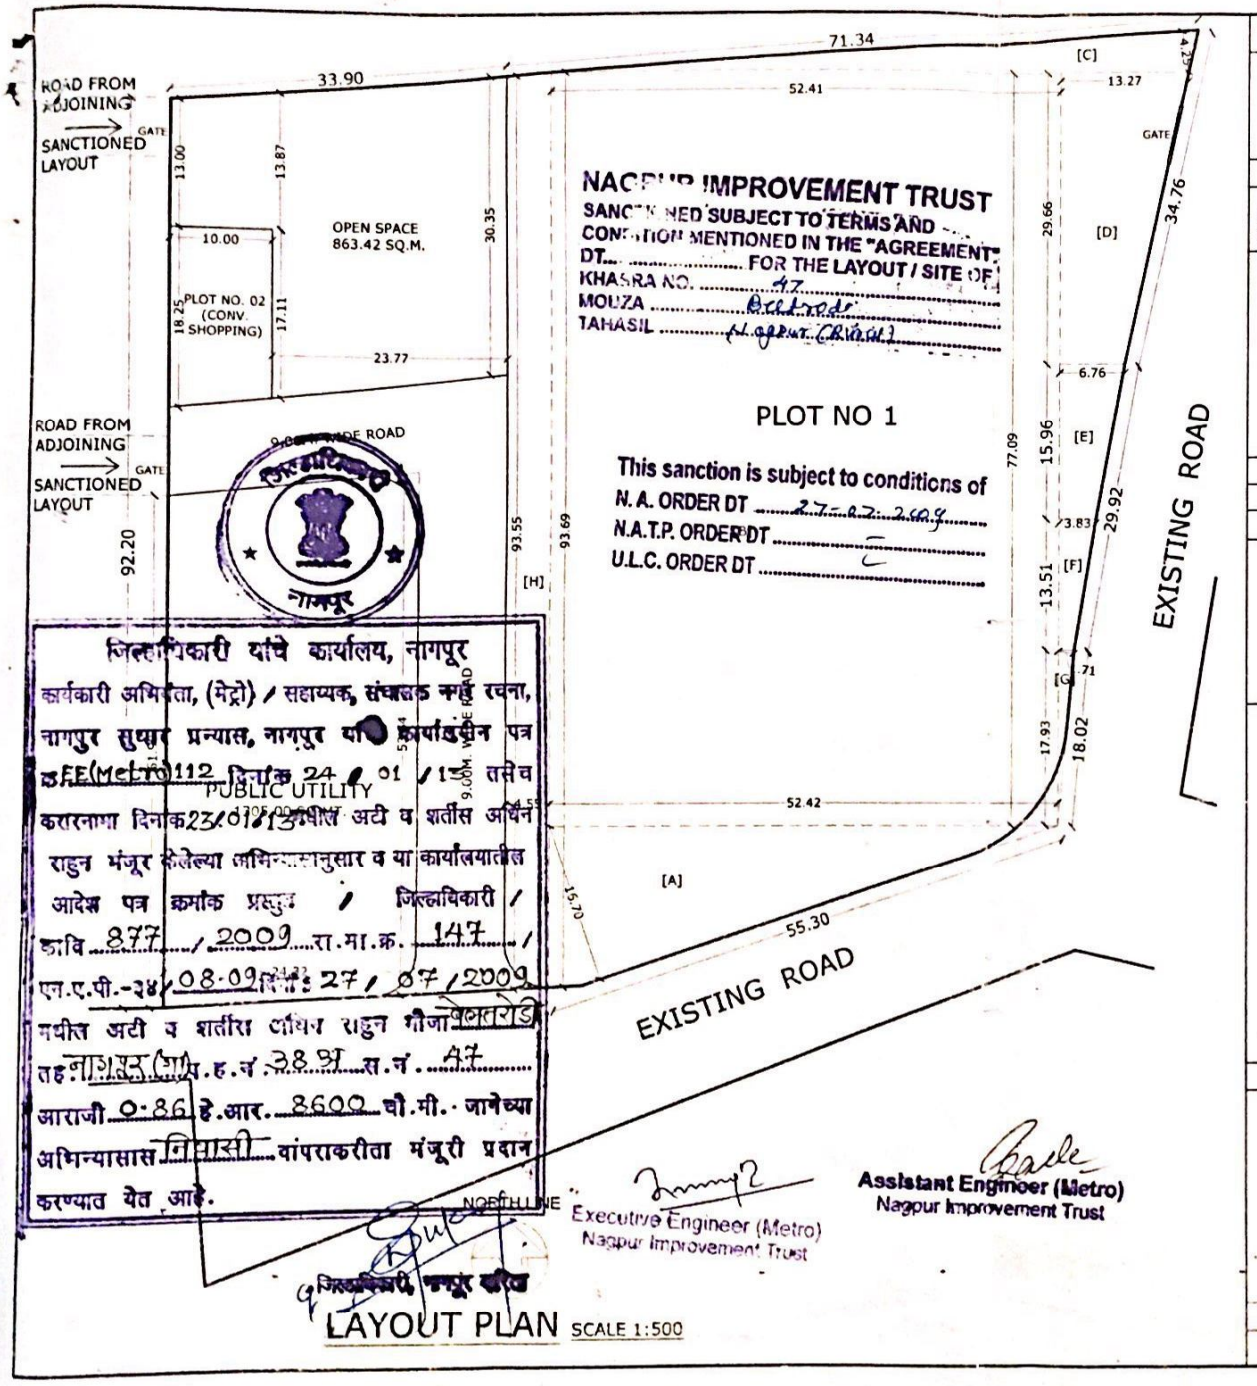

PLAN TITLE:-

REVISED RESIDENTIAL LAYOUT PLAN ON KH. NO. 47,PH.NO.38,MOUZA-BELTARODI, TAH.NAGPUR(GRAMIN), DIST. NAGPUR.

PLOT AREA STATEMENT

SR. NO.	PLOT NO.	SIZE	AREA	LESS TANGENT	AREA	NO.OF PLOT	TOTAL AREA (SQ.M.)
1	01 [A]	1/2 X 55.30 x 16.70	461.760	17.420	5475.351	1	5475.351
	[B]	52.41 X 77.06	4038.71	10.220			
	[C]	1/2 X 67.22 X 4.25	142.840				
	[D]	1/2 X(13.27+6.76)X29.66	297.040				
	[E]	1/2(6.760+3.830)X15.96	084.510				
	[F]	1/2(3.830+1.71)X13.51	037.420				
	[G]	1/2X18.020X1.710	015.410				
	[H]	1/2(93.55+93.69)X4.55	425.971				
2	02	1/2X10.00X(18.25 + 17.11)= 176.80 (CONV. SHOP.)				1	176.80
		TOTAL PLOT AREA				2	5652.151

AREA STATEMENT			%
*	TOTAL AREA OF KH.NO. 47	8600.000 SQ.M.	100.00 %
*	AREA UNDER PUBLIC UTILITY	1305.000 SQ.M.	15.17 %
*	AREA UNDER OPEN SPACE	863.42 SQ.M.	10.04 %
*	AREA UNDER PLOT	5475.351 SQ.M.	63.67 %
*	AREA UNDER CONV. SHOPPING	~~176.80~~ SQ.M. 132.45	~~2.05~~ % 2.02/0
*	AREA UNDER ROAD	~~778.759~~ SQ.M. 822.349	~~9.06~~ % 9.56/.

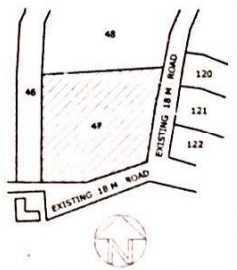

LOCATION PLAN
NOTE : NOT TO SCALE

SIGNATURE OF OWNER

P.O.A.OF PLOT NO. 1 TO 15

P.O.A OF REMAINING LAND

SIGNATURE OF ARCHITECT

ARCHITECT :- MILIND. NADIYANA,CA/2000/26814, N.I.T. L.S.NO. 1193,N.M.C. L.S. NO. R- 124.

MILIND NADIYANA & ASSOCIATES
CA/2000/26814
N.I.T. L.S. No. 1193
NMC L.S. No. R 124
ARCHITECT

MILIND NADIYANA & ASSOCIATES

SCALE	REVISED NO	DATE	DRAWN BY	CHECKED BY
- 1 500	05	11-01-2013	NANDA K	M.N