


FRONT ELEVATION (BLDG.-A)

SCALE :- 1:100



SECTION A-A (BLDG.-A)

SCALE :- 1:100

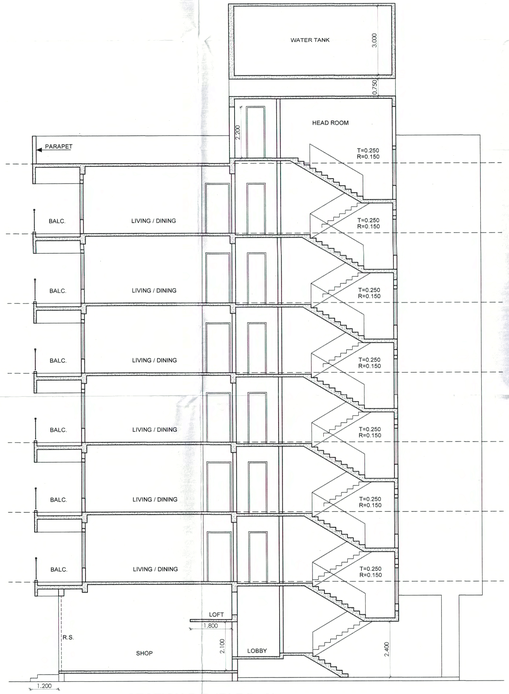

SECTION B-B (BLDG.-A)

SCALE :- 1:100

Permission Granted as Per Building DCPR Bye-Laws & M.R.T.P Act 1966 Vide Letter No. 1589/2022 Date 23/03/2022 And Necessary Corrections by Made by Red Lines.

Planning Assistant
Town Planning Dept

Chief Officer
Municipal Council Wanadongri

SHEET NO: 3/7 (BLDG-A)

ELEVATIONS, SECTIONS

PROPOSED COMMERCIAL CUM MULTIFAMILY GROUP HOUSING SCHEME ON KH.NO:-27, P.H. No:- 46, MOUZA :- WANADONGRI, TAH. HINGNA, DIST.:- NAGPUR

BELONGING TO:-

SHRI ANIL RADHESHYAM SHARMA

Owner's Declaration-

I/We undersigned hereby confirm that I/We would abide by plans approved by Authority/ Collector. I/We would execute the structure as per approved plans. Also I/We would execute the work under supervision of proper technical person so as to ensure the quality and safety at the work site.

SHRI ANIL RADHESHYAM SHARMA

OWNERS signature

Certificate of Area:

Certified that the plot under reference was surveyed by me on _____and the dimensions of sides etc. of plot stated on plan are as measured on site and the area so worked out tallies with the area stated in document of Ownership/T.P. Scheme Record/Land Records Department/City Survey records.

PRASHANT SATPUTE
B.ARCH (HONS) IFBAY, M.C.A
REG. No. CA/1991/13818
NIT LS. No. 491
N.M.C. L.S No. R-222
LS No. NMRDA/CA/1991/13818

Architect/Licensed Engineer/ Supervisor name and Signature

Design Cell
" The Edge ", 12, Shankar Nagar, WHC Road
Nagpur - 440010 (M.S.), INDIA.
Phone +91-712-2980159,+91-712-2980156
E-mail: design_cell@rediffmail.com.
Website: www.designcellindia.net

design cell
ARCHITECTS
PLANNERS &
INTERIOR
DESIGNERS