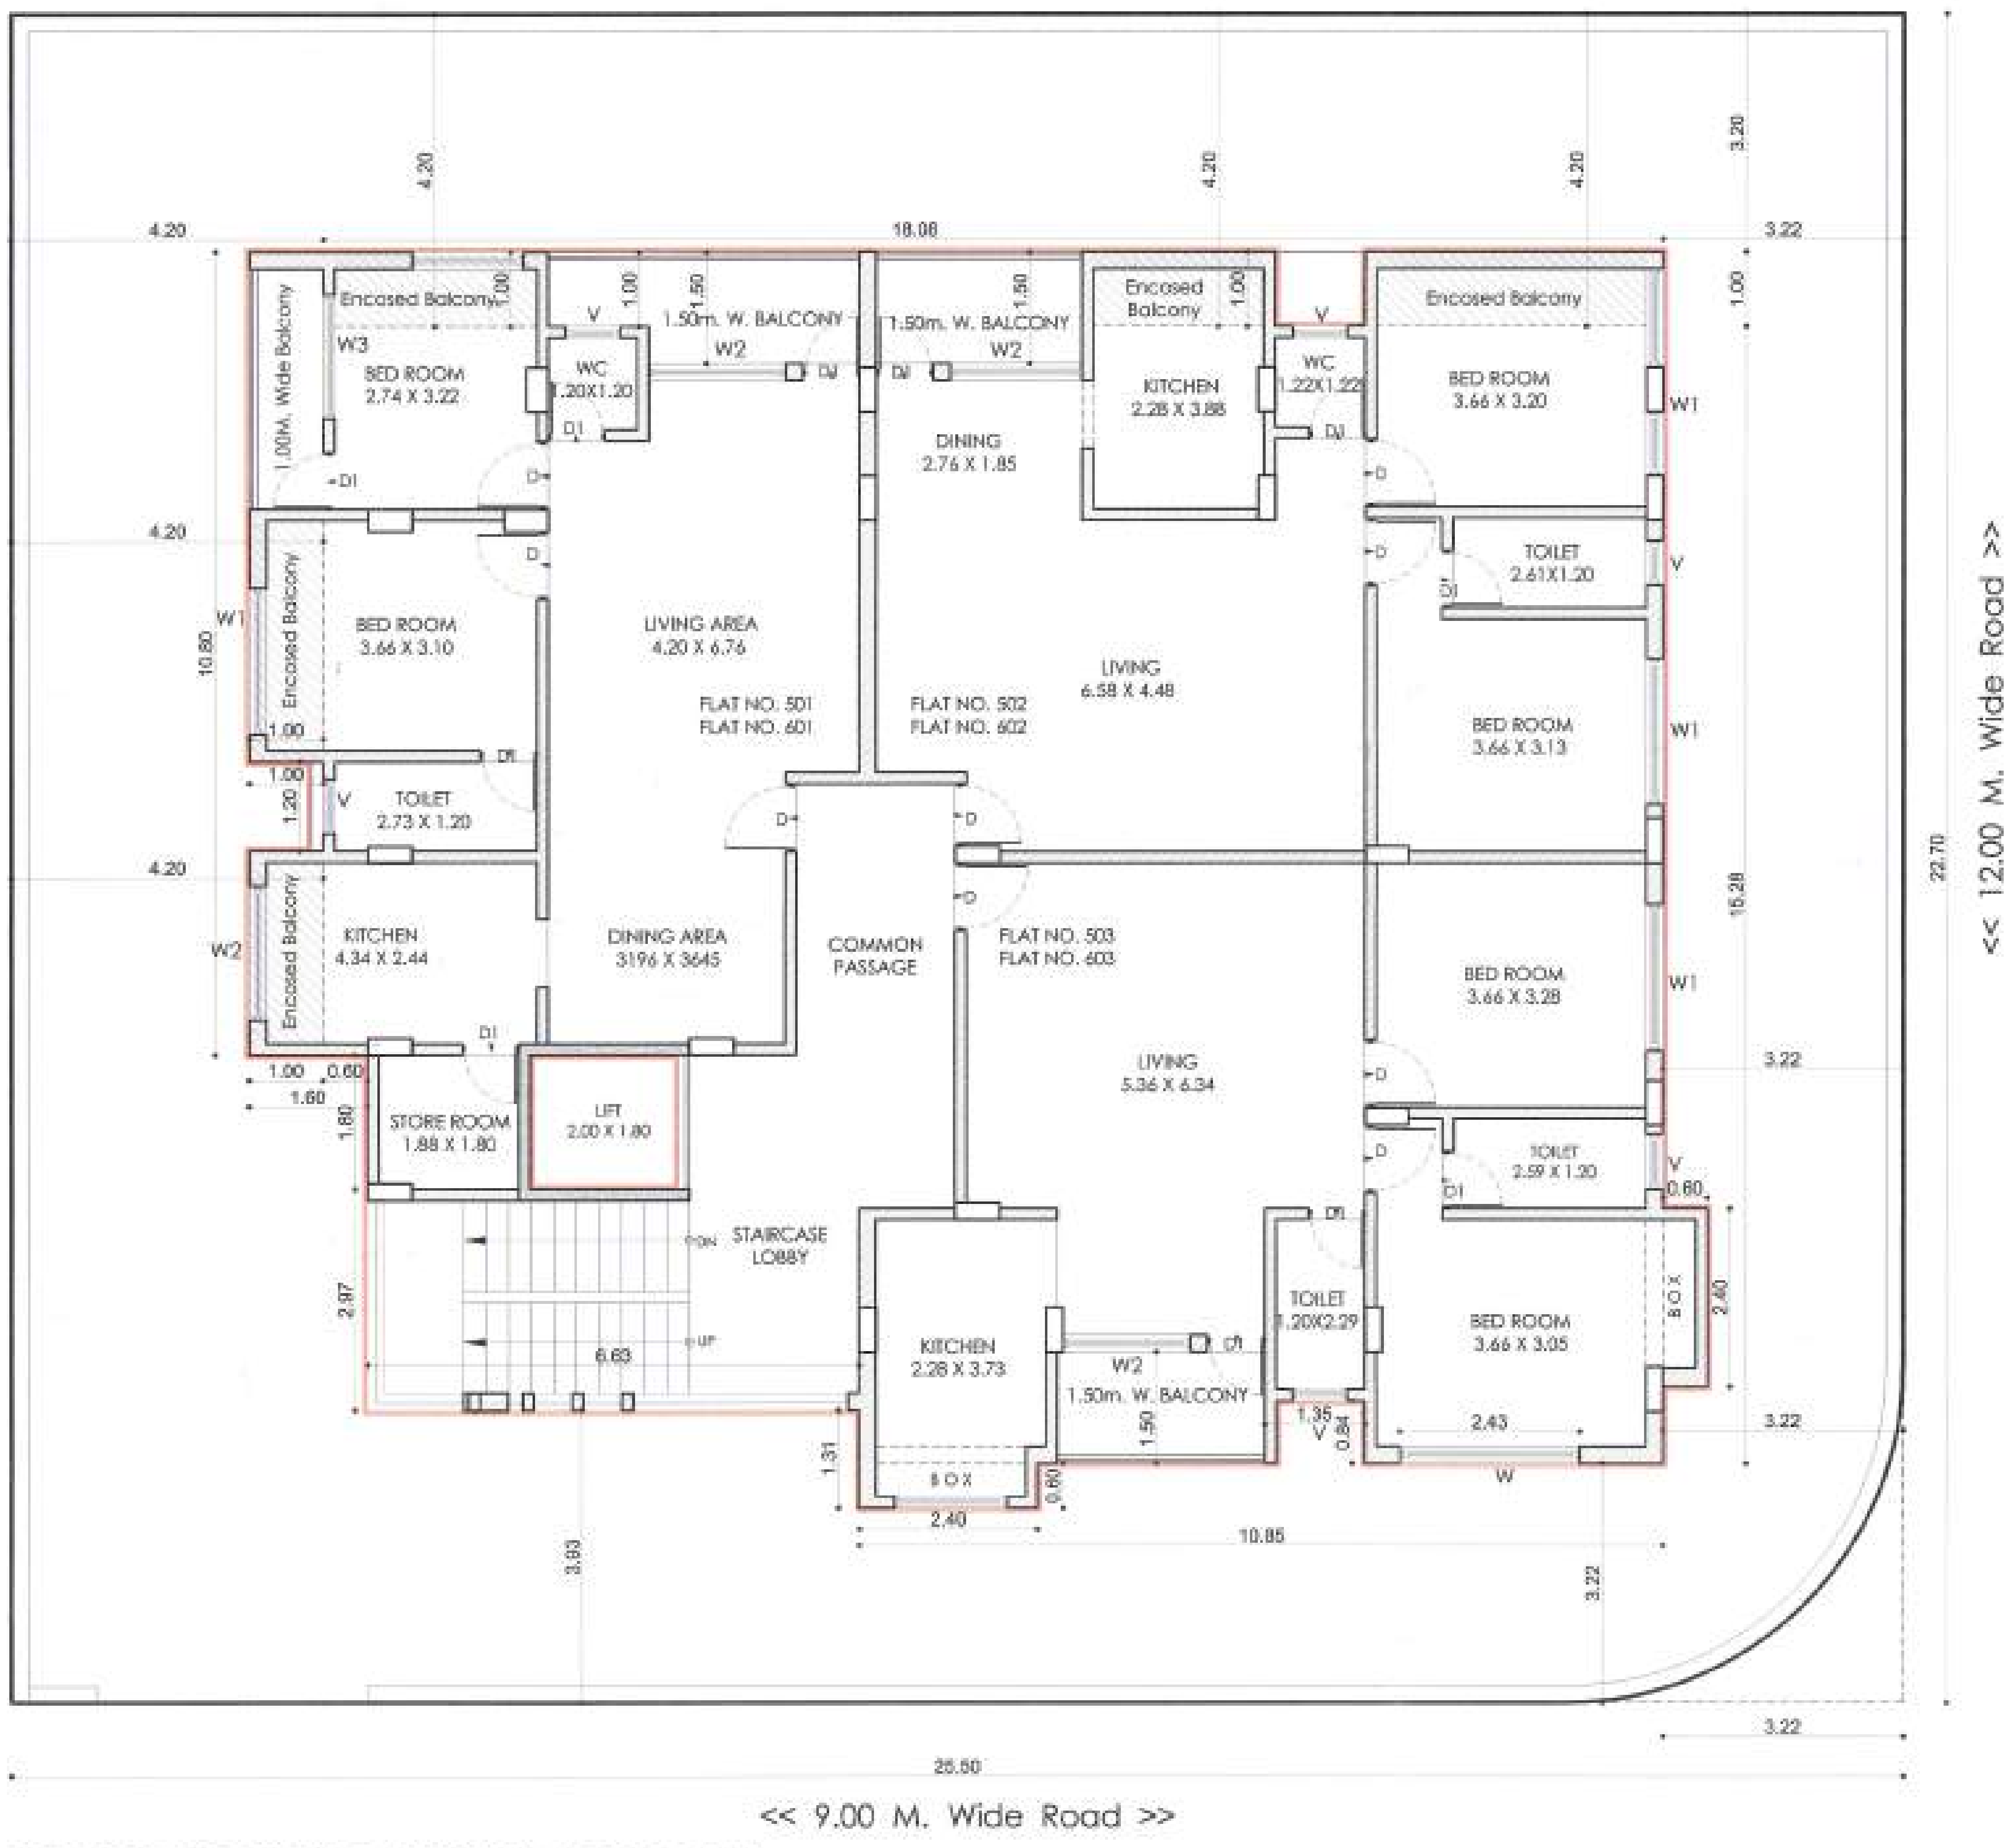

PROPOSED FIFTH & SIXTH FLOOR PLAN

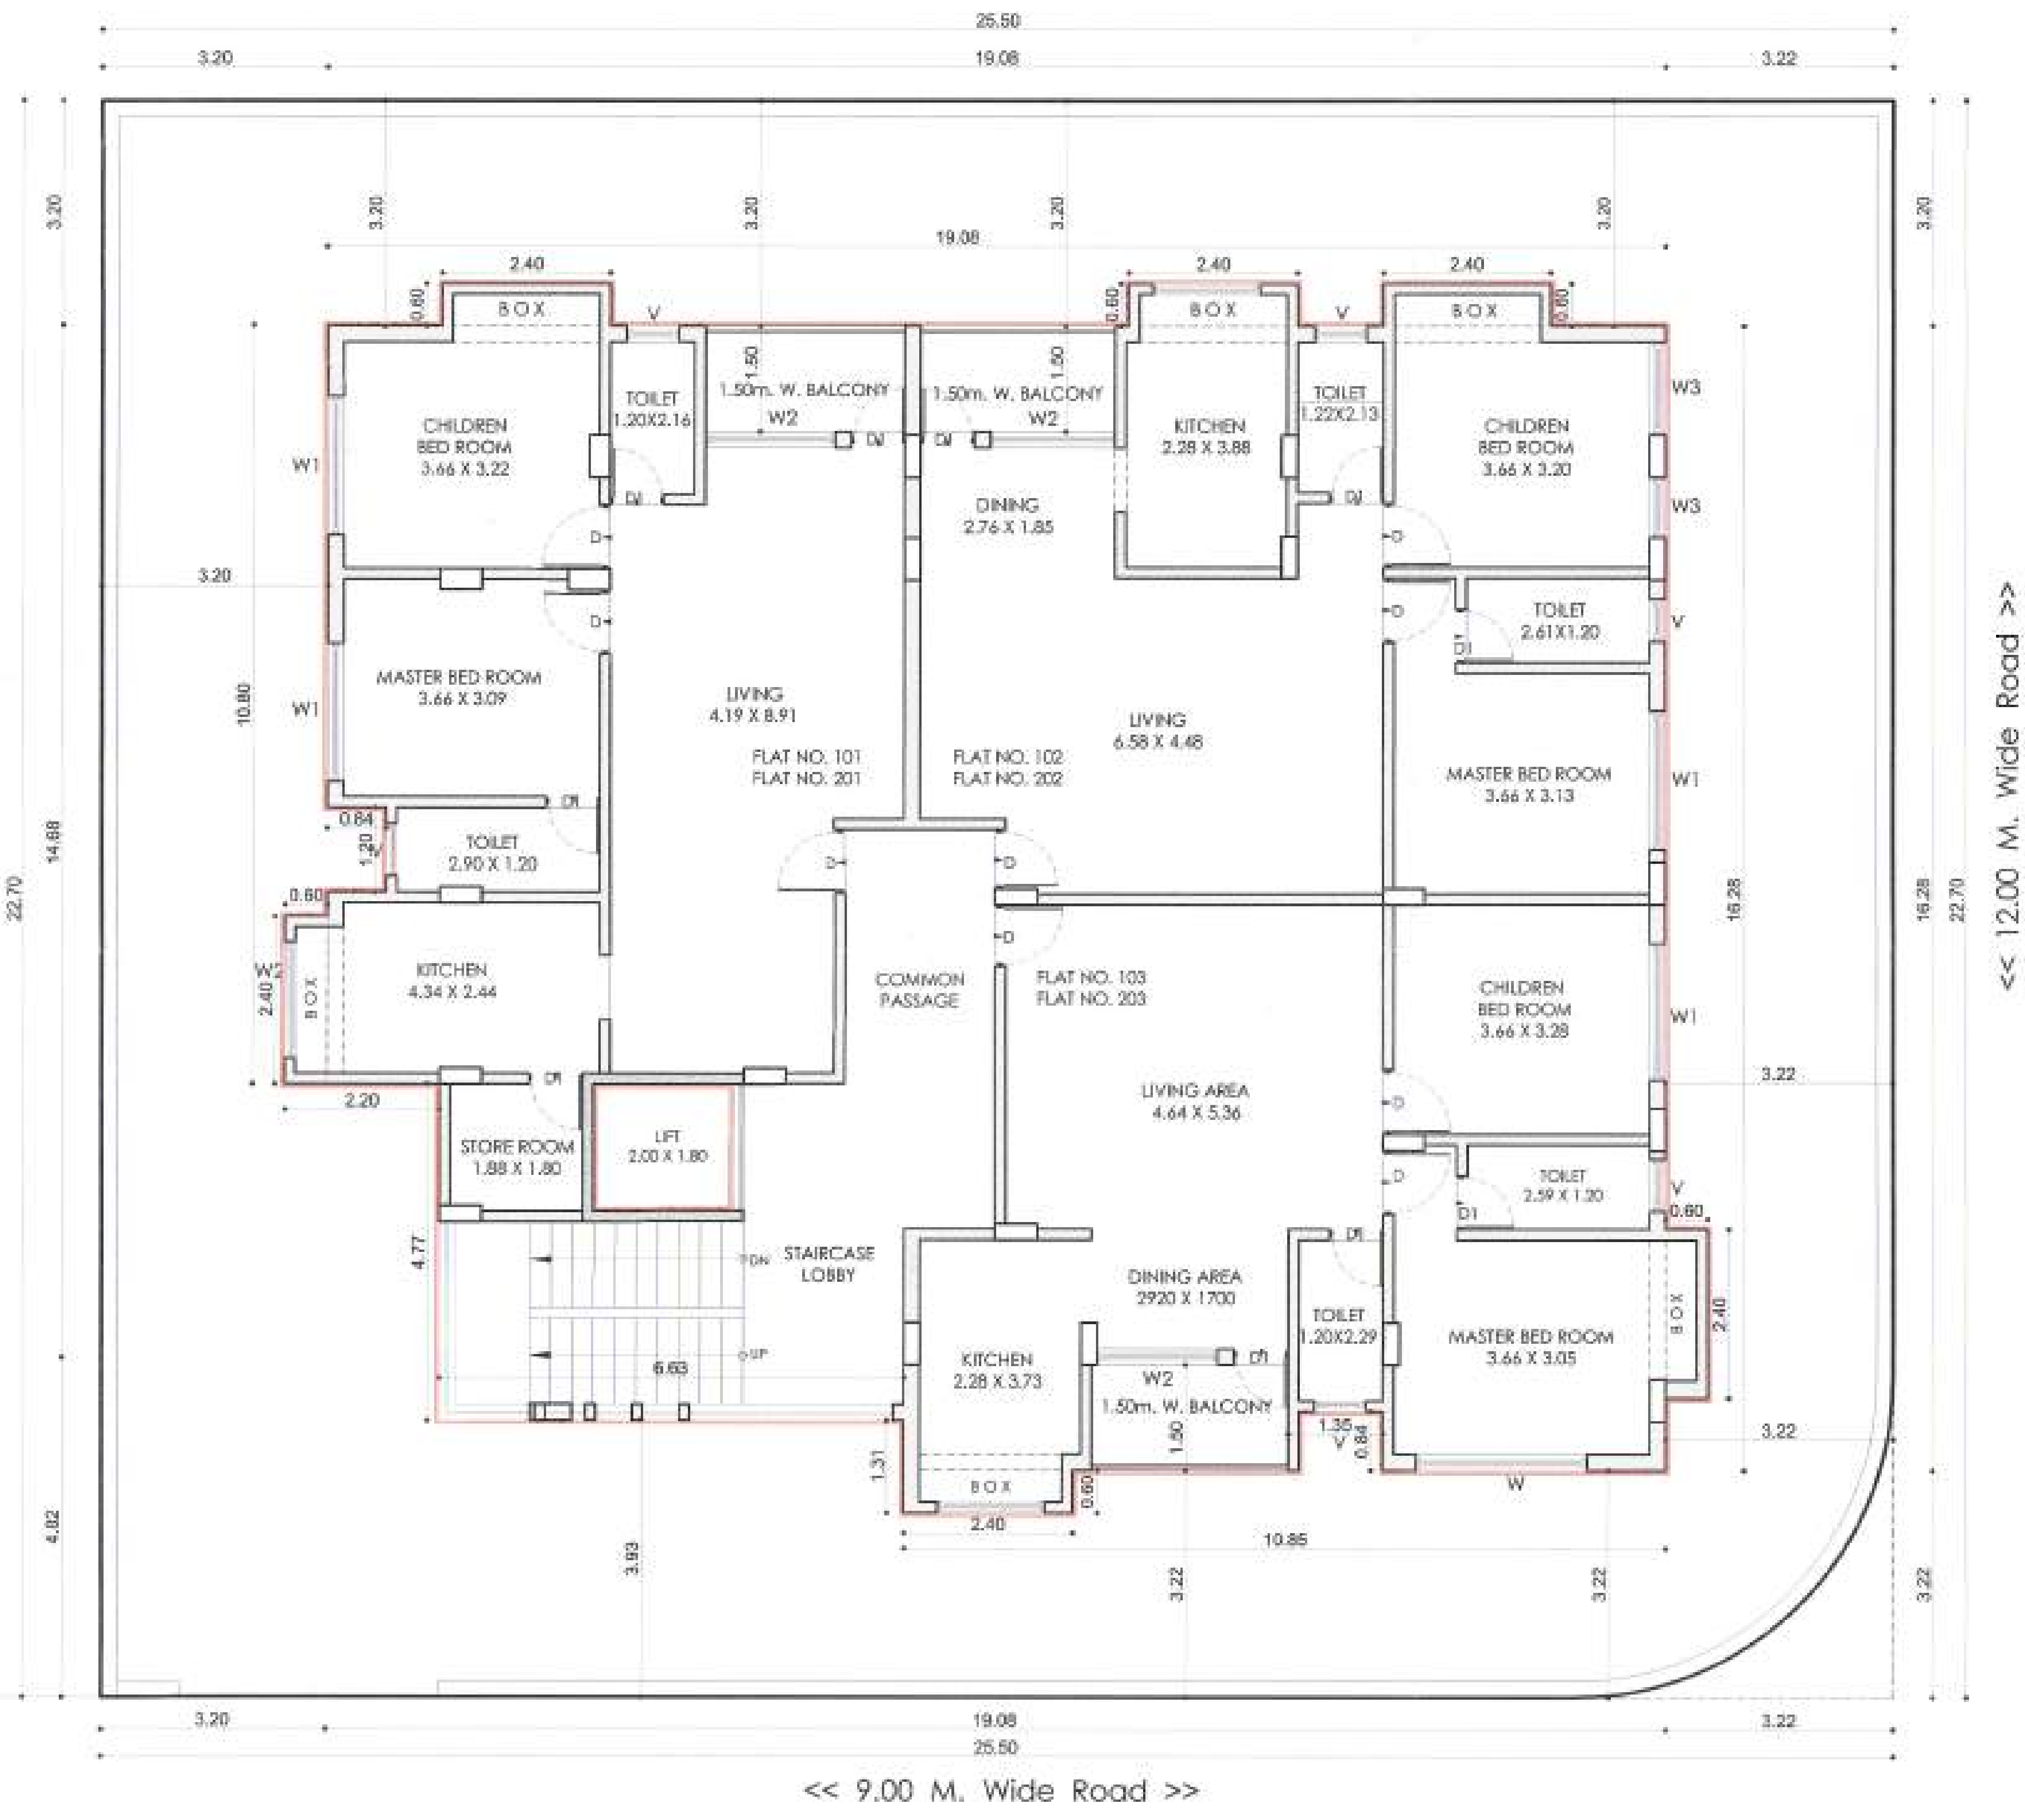

REVISED FIRST, SECOND, THIRD & FOURTH FLOOR PLAN

SHEET NO. 2/2

OFFICE USE

अनदार यांची प्रत

Approved as ammended in......................colour, Subject to the onditions mentioned in this office's Building Permit No. 488/2021-22 Date 08/09/2021

Town Planner
Town Planning Department
Municipal Corporation
Aurangabad
O.C. Signed By D.D.T.P.

OPENING SCHEDULE

SR NO.	SYMBOL	SIZE	SILL	LINTEL	REMARK
1	D1	0.90 X 2.10	–	2.10	
2	D2	1.00 X 2.10	–	2.10	
3	D3	0.75 X 2.10	–	2.10	
4	W	2.40 X 1.20	0.90	2.10	
5	W1	2.00 X 1.20	0.90	2.10	
6	W2	1.80 X 1.20	0.90	2.10	
7	W3	1.50 X 1.20	0.90	2.10	
8	V	0.60X0.90	1.50	2.10	
9	V1	0.90X0.60	1.50	2.10	

REFERENCE :-

1. EXISTING WORK SHOWN IN BLUE
2. PROPOSED WORK SHOWN IN RED
3. PLOT BOUNDRY SHOWN IN THICK BLACK
4. DRAINAGE LINE SHOWN IN GREEN DOTTED
5. WATER LINE SHOWN IN GREEN

REVISED BUILDING PLAN ON PLOT No.44, C.T.S. No. 20295/2/5, SITUATED AT KESARSINGPURA, ADALAT ROAD, (OLD ASHOKA HOTEL LAYOUT), AURANGABAD, BELONGING TO SHRI. LAXMINARAYAN SHRIRAMJI ATTAL. MRS. SUNITA LAXMINARAYAN ATTAL.

SIGN. OF OWNER

1) [signature] 2) Sunita Attal

DRAWN BY : SSN	CHECKED BY : SVS
DEALT BY : HAI	
DATE : 05TH AUG. '2021	SCALE : 1:100
DRG No :	PROJECT No:

SACHIN SANGSHETTY
ARCHITECTS
REG. NO. - CA/2007/39390
BLOCK NO. 2, SHREE VISHWAROOP HALL
PLOT NO. 75, JYOTI NAGAR, AURANGABAD
PHONE NO. :- (0240) 2350222
MOBILE NO. :- +91-9822639222
SACHIN SANGSHETTY ARCHITECT
SIGN. OF ARCHITECT

THIS DRAWING IS THE PROPERTY OF AR. SACHIN V. SANGSHETTY, AND SHOULD NOT BE REPRODUCED IN PART OR WHOLE WITHOUT PRIOR PERMISSION FROM THE ARCHITECT.