for Building- 'A & B'

Stair-case & Lobby Premium Area Statement

Floor	Bldg A area	25%	Proposed saleable S.Entry Area		Total Sale-able Premium Area
			Bldg A	Bldg B	
Stilt	357.55	71.51	2.40(4.65) = (2.5X0.05) = (4.65X2.40) = (11.25X1.65)		= 39.67 m²
1st Flrr	297.55	71.51	2.40(4.65) = (2.5X0.05) = (4.65X2.40) = (11.25X1.65)		= 39.67 m²
2nd Second	317.72	52.34	2.40(4.65) = (2.5X0.05) = (4.65X2.40) = (11.25X1.65)		= 39.67 m²
3rd Third	162.63	33.12	(2.5X0.05)		= 5.12 m²
			Total Stair-case premium Area for Building 'A' & 'B' =		54.18 M²
			- Previous Approved Staircase Area = 4.8 (B. DKD.-Bd) =		41.74 M²
			Stair-case & Lobby PREMIUM AREA of Building 'A & B' =		52.17 M²

Carpet Area Statement

Flat No.	Carpet Area
S1 to S3 (1sA-3.25 + 4.22 - 2x0.3 (345.05 = 22.71 M²	
S2 & S'2'	
S5 & S'3'	
S4, S6, S'2', S'3' (Flat-3.20 x 4.30 - Bar-3.05x0.30) = 21.54 M²	
S'1' & S'4 & S'6 (Flat-3.0 x 4.20 = 2.31 M²	
S'1', S'2', S'3', S'4', S'5', S'6' (Flat-3.65 x 3.20) - (Bar-1.60x0.30) = (Bal-3.0x0.30) = 20.62 M²	

Note: Carpet Table 'S1' to 'S6', 'S'1' to 'S'6' W.C., passage, balcony, door sill etc. are not deducted in calculation of the above area.

Rain Water Harvesting

SCHEDULE OF OPENINGS

Sr. No.	Size	Description
V	0.23 x 0.60	V.C. Ventilator
D	0.75 x 2.10	Flush Door
D1	0.85 x 2.10	Flush Door
D2	0.90 x 2.10	Flush Door
A1	1.20 x 1.20	Aluminium Window
A2	1.50 x 1.20	Aluminium Window
A3	1.80 x 1.20	Aluminium Window
A4	2.40 x 1.20	Aluminium Window
A5	3.00 x 1.20	Aluminium Window
Ch	1.20 x 2.10	Fabricated Iron Grill Door

Balcony Area Statement for Building A

Floor	Permissible	Proposed	Excess
Stilt	24.73	24.66	—
Stilt First	24.73	24.66	—
Stilt Second	24.73	24.66	—
Stilt Third	5.62	1.25	—
Total Excess Balconies			—

LOCATION PLAN

N

APPROVED

The Plans amended in — Red

As per the conditions Mentioned in the accompanied commencement Certificate No. [4]3[6]9 dated 13/[05]/[2]0[1]5

Executive Engineer TOWN PLANING Nashik Municipal Corporation Nashik

Sheet 1/2

Area Area Diagram & Calculations for building A

First/Second/Third Floor (Building - 'A') (scale: 1:200)

STILT /STILT FIRST / STILT SECOND FLOOR PLAN (scale: 1:100)

(BALCONY AREA = 1.2 (0.15+2.05+2.15+2.05+2.15+0.67) = 24.66 M²)

(Building -'A')

GROUND FLOOR PLAN (scale: 1:100)

(Building -'A')

FRONT ELEVATION (scale: 1:100)

(Building -'A')

STILT THIRD FLOOR PLAN (scale: 1:100)

(Building -'A') (BALCONY AREA = 1.2 (0.15+2.05+2.15+2.05) = 1.25 M²)

SECTION A-A' (scale: 1:100)

(Building -'A')

Area Calculations On First/Second/Third Floor

(Building -'A')

AREA CALCULATION ON STILT FLOOR
AREA OF BLOCK - 20.80 X 14.40 = 429.12

Deduction

1.) -	1 X 2.45 X 1.35	= 3.31
2.) -	1 X 3.20 X 0.45	= 1.44
3.) -	1 X 2.25 X 3.50	= 7.88
4.) -	2 X 2.33 X 0.35	= 1.65
5.) -	2 X 2.15 X 2.10	= 11.55
6.) -	2 X 3.20 X 2.80	= 17.89
7.) -	1 X 1.35 X 3.55	= 4.79
8.) -	1 X 2.50 X 14.40	= 36.00
9.) -	2 X 2.35 X 2.65	= 12.46
10.) -	1 X 1.35 X 3.15	= 4.25
11.) -	2 X 2.75 X 1.75	= 9.63
12.) -	2 X 3.20 X 2.60	= 16.64
13.) -	1 X 2.10 X 3.75	= 7.88
14.) -	1 X 2.40 X 10.75	= 25.80
15.) -	1 X 3.80 X 2.16	= 8.19
16.) -	1 X 0.95 X 4.60	= 4.37
17.) -	1 X 0.70 X 3.45	= 2.42
18.) -	1 X 1.55 X 2.75	= 4.26

Total deduction = 181.40

Proposed BUp area of Stilt Floor
= 429.12 - 181.40
= 247.72 M²

Area Calculations On Fourth Floor

(Building -'A')

AREA OF BLOCK
-19.7 X 14.25 = 280.55

Deduction

1.) -	2 x 2.75 X 1.75	= 9.63
2.) -	2 x 8.90 X 2.60	= 46.28
3.) -	1 x 2.50 X 8.85	= 22.13
4.) -	2x 2.35 X 2.65	= 12.46
5.) -	2 x 7.90 X 1.05	= 4.95
6.) -	2 x 1.10 X 7.45	= 16.39

Total reduction = 111.84

Acc. Lift Area 2.50 X 1.65 = 4.12

Proposed BUp area of Stilt Third Floor
= 268.55 - 111.84 + 4.12
= 160.83 M²

Forth Floor (Building -'A') (scale: 1:200)

1) Proposed BUp area of Stilt Floor = 247.72 M²
2) Proposed BUp area of Stilt 1st Floor = 247.72 M²
3) Proposed BUp area of Stilt Second Floor = 247.72 M²
4) Proposed BUp area of Stilt Third Floor = 160.83 M²

Proposed Total BUp Area(Building A) = 903.79 M²

NOTES

PLOT BOUNDARY SHOWN IN THICK BLACK COLOUR ARE, - AS PER SITE
PROPOSED WORK SHOWN IN RED INTERNAL AREA - AS PER SITE
CHANGES IN THE GIVEN APPROVED PLAN, CONDITIONS ARE APPLICABLE

Architect: Alok R. Soman Signature / Date

PROPOSED REVISED PLAN of RES. BUILDING in PLOT NO. 35, S. NO. 27/B/14 at DASAK SHIWAR, NASHIK for, Shri. VIJAY A. DHATRAK & Shri. SUNIL A. DHATRAK.

DEAL	: Ver Power	DRG NO.:
CHECKED	: Vijay Dalvi	M1.1
SCALE	: as shown	
DATE	: 12.10.16	JOB NO.: SVS / 12 / 1001 V

SOHAM
Architectural Engineering Services
CONSULTANCY DESIGN, ENGINEERING, PROJECT MANAGEMENT

APPROVED
Th plans amended in.... ..... Sheet 2/2
As per the conditions Mentioned in the accompaning commencement Certificate No. 14/369 dated 18/Last/2015

Executive Engineer
TOWN PLANING
Nashik Municipal Corporation
Nashik

Parking Statement		
Required	4 Wheeler	2 Wheeler
for Plot	4.	8.
for Building -	12.	12.
for Comm. -	—	—
TOTAL -	16	20
Provided -	24	20

Carpet Area Statement

Flat No	Carpet Area
A1,A3,A5	(hall-4.25 x 3.25) + (bed-2.40x3.35) + (Bed-3.05 x 3.05)+ (bed-2.40x3.35)=38.96 M²
A2,A4	(hall-4.40 x 3.25) + (bed-2.40x3.50) + (bed-3.05x2.85)=31.63 M²

Note: Kitchen, Toilet, Bath, W.C., passage, balcony, stag, balcony, etc are not included in calculation of the above area.

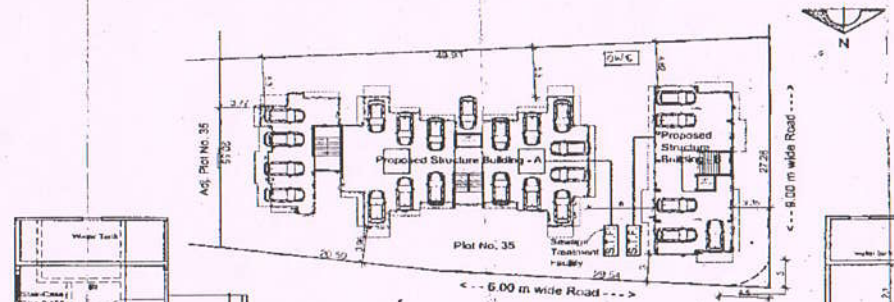

SITE PLAN (scale: 1:200)

T.D.R. Statement
Plot Area - 951.42 m²
Permissible T.D.R.(40%)- 380.56 m²
Purchased T.D.R. - 260.00 m²
(TP scheme - I) (T.C. No. 458, dated 05/11/2013)
(Regd. doc. no. 4603, dated 21/05/2015)
Total F.S.I. - 1211.42 m²

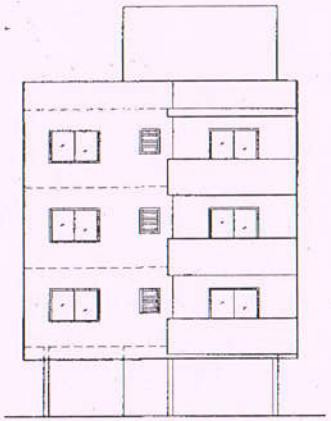

EAST SIDE ELEVATION (scale : 1:100)
(Building - "B")

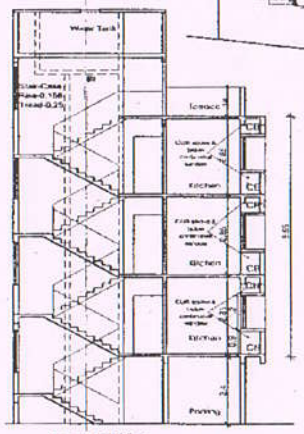

SECTION A-A' (scale : 1:100)
(Building - "B")

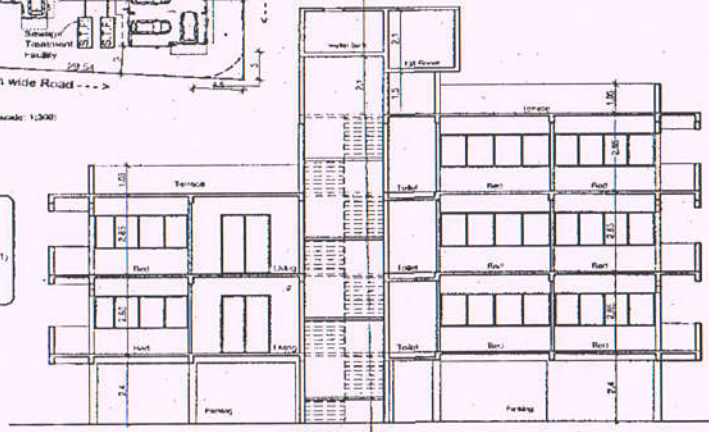

SECTION B-B' (scale : 1:100)
(Building - "B")

B/UP AREA STATEMENT (BUILDING - A)

B/up area on still floor	- 247.72 M²
B/up area on still First floor	- 247.72 M²
B/up area on still Second floor	- 247.72 M²
B/up area on still Third floor	- 160.63 M²
Total B/up Area of Building A	- 903.79 M²

B/UP AREA STATEMENT (BUILDING - B)

B/up area on still floor	-110.22 M²
B/up area on still First floor	-110.22 M²
B/up area on still Second floor	-64.39 M²
Total B/up Area of Building B	-284.83 M²

TOTAL B/UP AREA = 903.79 + 284.83 = 1188.62 M²

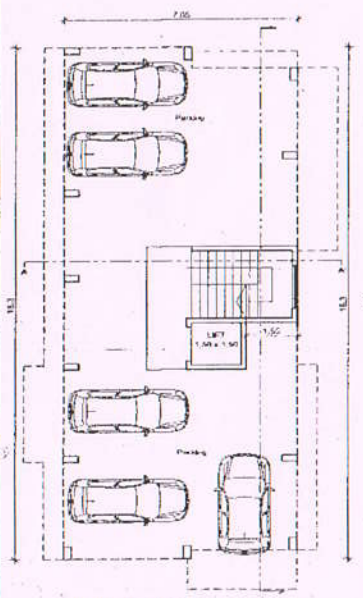

GROUND FLOOR PLAN (scale : 1:100)
(Building - "B")

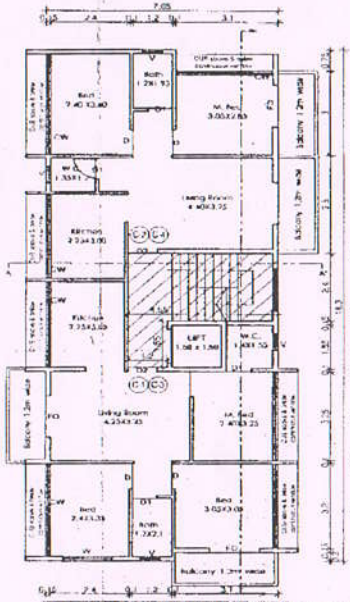

STILT / STILT FIRST FLOOR PLAN (scale : 1:100)
(Building - "B")
(BALCONY AREA = 1.2 (3.00 + 3.50 + 3.20 + 3.5) = 15.84 M²)

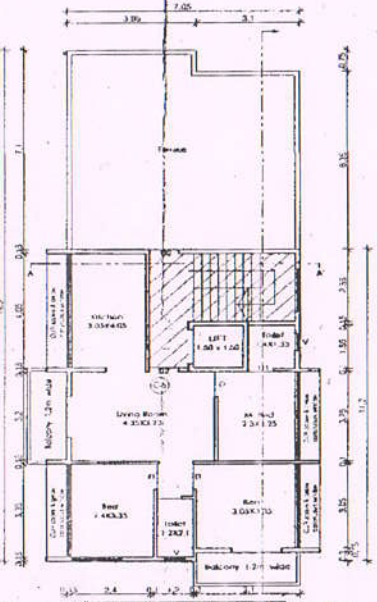

STILT SECOND FLOOR PLAN (scale : 1:100)
(Building - "B")
(BALCONY AREA = 1.2 (3.20 + 3.50 = 6.04 M²)

Area Area Diagram & Calculations for Building -"B"
Scale 1:200

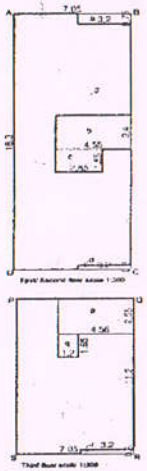

Area of □ ABCD - 7.05 x 18.3 = 129.02
Deduction
1. Area of block 'a' = 3.20 x 0.75 = 2.40
2. Area of block 'b' = 4.55 x 2.40 = 10.92
3. Area of block 'c' = 2.85 x 1.65 = 4.70
4. Area of block 'd' = 3.20 x 0.30 = 0.96
Total deduction = 18.98

1) Proposed B/up area of Still Floor
= 129.20 - 18.98 = 110.22 m²

2) Proposed B/up area of Still First Floor
= 110.22 m²

Area of □ PQRS - 7.05 x 11.20 = 78.96
Deduction
1. Area of block 'p' = 4.56 x 2.55 = 11.63
2. Area of block 'q' = 1.20 x 1.65 = 1.98
3. Area of block 'r' = 3.20 x 0.30 = 0.96
Total deduction = 14.57

3) Proposed B/up area of Still Second Floor
(Including LIft Area)
= 78.96 - 14.57 = 64.39 m²

TOTAL PROPOSED B/UP AREA
= 110.22 + 110.22 + 64.39 = 284.83 M²

Balcony Area Statement

Floor	Permissible	Proposed	Paraits
Stilt	11.02 M²	15.84 M²	4.82 M²
Stilt First	11.02 M²	15.84 M²	4.82 M²
Stilt Second	8.44 M²	8.04 M²	1.60 M²
Total Excess Balcony =			11.24 M²

(BALCONY AREA = 1.2 (3.00 + 3.50 + 3.20 + 3.5) = 15.84 M²)
(BALCONY AREA = 1.2 (3.20 + 3.50) = 8.04 M²)

* ALL CUD above & below CONTINUOUS WINDOW are as per SECTION A-A shown in plan.

AREA STATEMENT		M²
AREA OF THE PLOT		951.42
F.S.I. PERMISSIBLE		ONE
Add - 40% (BP)		260.00
TOTAL PERMISSIBLE F.I. FLOOR AREA		1211.42
PROPOSED BUILT UP AREA AT:-	FIRST FLOOR -	357.55
	SECOND FLOOR -	357.55
	THIRD FLOOR -	311.72
	FORTH FLOOR -	160.63
	EXCESS BALCONY -	11.24
TOTAL BUILT UP AREA PROPOSED		1198.69

NOTES

PLOT BOUNDARY SHOWN IN Thick BLACK	EXISTING WALL - 150 MM Thick
PROPOSED WORKS SHOWN IN RED	INTERNAL WALL - 100 MM Thick
DRAINAGE LINE SHOWN IN DOTTED PATTERN	ALL DIMENSIONS ARE IN METER

CERTIFICATE OF AREA

Certified that the plot under reference was surveyed by me on 04.01.2015 and dimensions of all above etc. of plot worked on (Plan are as assumed on site and the area so worked out tallies with the area stated in document of ownership) U.T.P. Act.

Er. Vijay K. Sanap.
Regd. No. 116 (NMC)

Er. Vijay K. Sanap

Signature of Owner

PROPOSED REVISED PLAN of RES. BUILDING in PLOT NO. 35, S. NO. 27/B/14 of DASAK SHIWAR, NASHIK for, Shri. VIJAY A. DHATRAK & Shri. SUNIL A. DHATRAK

DRAFT	: Rajit Pawar	DRG. NO. :	M1.2
CHECKED	: Vijay Sanap		
SCALE	: as shown		
DATE	: 19.05.2015	JOB NO. : SVS / 15 / 900 / M	

SOHAM
Architectural Engineering Services
CONSULTANCY, DESIGN, ENGINEERING, PROJECT MANAGEMENT
3A/15, Suvidya Arcade, Behind HDFC Bank, Bhadkal Farm Road, New Nashik.
e-mail: vijay.sanap@sohamsons.com, Phone: 0253 3204888 Cell: 09823020938

Copying of this document & giving it to others and the use of communication of the contents thereof are forbidden without express authority. Offenders are liable to the payment of damages. All rights reserved. In the event of the grant of permission and/or the registration of a design, © Copy Right 2015. Sanap Architectural Engineering Services. Nashik. e-mail: vijay.sanap@sohamsons.com