



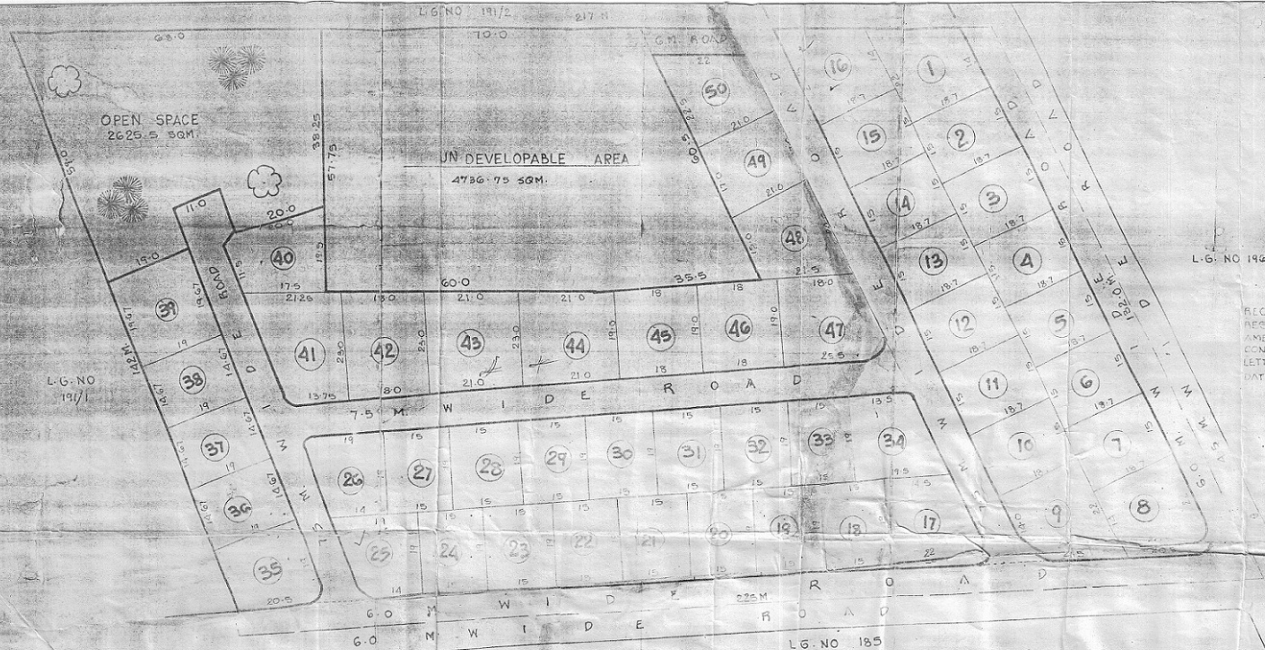

RECOMMENDED FOR APPROVAL FOR
RESIDENTIAL PURPOSE ONLY
AMENDED IN GREEN SUBJECT TO THE
CONDITIONS MENTIONED IN THIS OFFICE
LETTER NO 52/PM, BHARUA/LAY OUT 5/21
DATED 15.7.21

LAY OUT PLAN

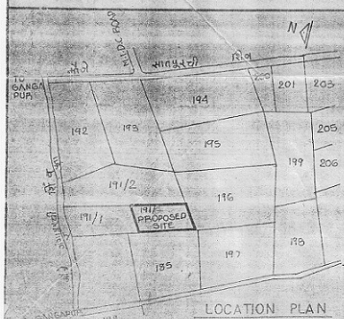

AREA STATEMENT FOR PLOTS

PLOT NO	AREA IN SQ. MTR.	PLOT NO	AREA IN SQ. MTR.	PLOT NO	AREA IN SQ. MTR.
1	230.50	18	285.00	35	313.50
2	230.50	19	285.00	36	278.75
3	230.50	20	285.00	37	278.75
4	230.50	21	285.00	38	278.75
5	230.50	22	285.00	39	278.75
6	230.50	23	285.00	40	313.50
7	230.50	24	285.00	41	402.50
8	336.60	25	313.50	42	411.00
9	336.60	26	313.50	43	489.00
10	230.50	27	285.00	44	441.00
11	230.50	28	285.00	45	348.00
12	230.50	29	285.00	46	348.00
13	230.50	30	285.00	47	473.25
14	230.50	31	285.00	48	409.50
15	230.50	32	285.00	49	597.00
16	330.62	33	285.00	50	372.75
17	346.15	34	313.50		

AREA STATEMENT

AREA OF LAND GNO 19/1	= 28000	SQ.MTR.
AREA OF PLOTS 1 TO 50	= 15322.24	SQ.M.
AREA UNDER OPEN SPACE	= 2625.50	"
AREA UNDER ROADS	= 4815.51	"
AREA UNDER UNDEVELOPABLE SPACE	= 4736.75	SQ.MTR.

NOTES

BOUNDARY OF G. NO 19/1 SHOWN IN RED.
PROPOSED OPEN SPACE SHOWN IN GREEN.
PROPOSED ROADS SHOWN IN BLUE.

LAY OUT PLAN IS PREPARED AS PER
APPROVED LAY OUT PLAN OF GNO 19/1
AT: PIMPALGOAN BHARUA TAL: DIST: NASHIK
FOR: SHRI. P. K. NAGARE

प. क. नागरे

[Signature]
ARCHITECT/ENGINEER

SPAN CONSULTANTS

ARCHITECTS & ENGINEERS,
BELA VISTA, OLD AGRA ROAD,
N. A. S. I. H. - 422002
PHONE - 4050

JOB NO. DATE 23-11-21
Dwg NO. SCALE 1:500