

PLOTWISE AREA STATEMENT

PLOT NOs.	AREA IN SQ.M.	PLOT NOs.	AREA IN SQ.M.
1	680.06	33	518.75
2, 3	650.81	34 TO 38	650.00
4	541.13	39	437.50
5	407.00	40	506.25
6, 7	489.50	41	222.30
8	497.75	42, 43	216.00
9 TO 12	275.00	44	556.50
13 TO 16	178.75	45	511.00
17 TO 20	275.00	46,47	213.50
21	322.68	48	335.50
22, 23, 24	246.00	49,50	286.00
25, 27	275.00	51	280.50
26	253.50	52	608.29
28,29, 30	246.00	—	—
31	271.63	—	—
32	690.19	TOTAL —	18,539.31 SQM

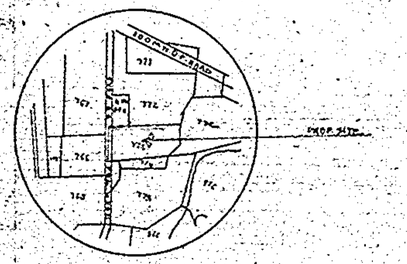

LOCATION PLAN
SCALE 1:10,000

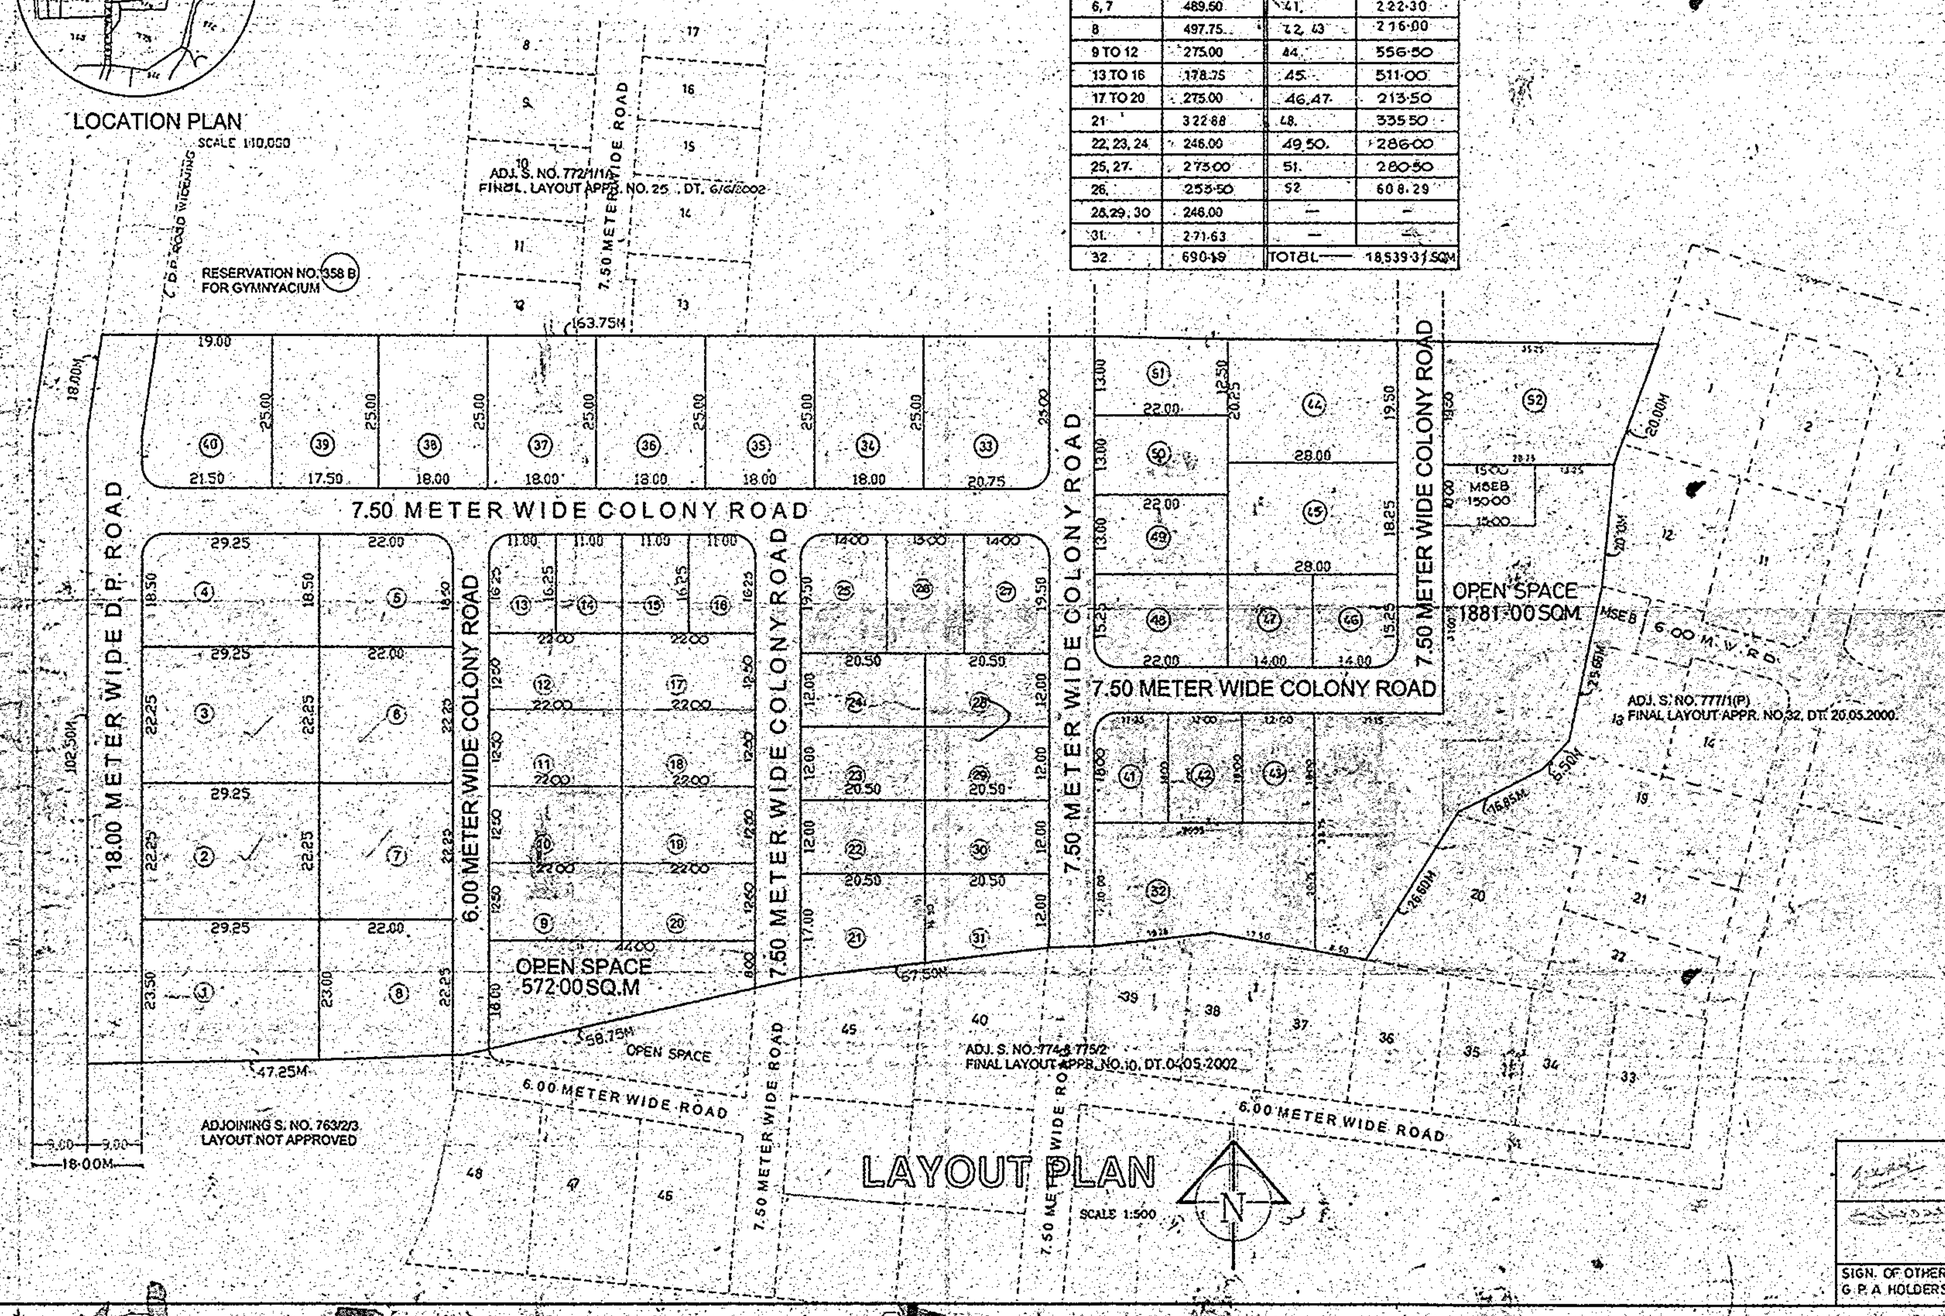

LAYOUT PLAN

SCALE 1:500

APPROVAL

APPROVED REVISED
(DEMARKATED FINAL) LAYOUT AS PER CONDITIONS MENTIONED IN THE LETTER NO. LND/WS/123/ DT-11/ 03/2003 IN VIEW OF SECTION 152 (13) AND 69 OF THE MAHARASHTRA REGIONAL AND TOWN PLANING ACT 1966.

SD/- X- X- X-

ASSISTANT DIRECTOR OF TOWN PLANING
NASHIK MUNICIPAL CORPORATION
NASHIK

DEMARCATION CERTIFICATE

THIS IS TO CERTIFY THAT I HAVE PERSONALLY DEMARCATED THIS LAYOUT WHICH IS TENTATIVELY APPROVED BY NASHIK MUNCIPAL CORPORATION NASHIK VIDE LT. NO. 287, DT. 29/09/1999 AND FURTHER CERTIFY THAT THE MEASUREMENTS OF PLOTS, ROADS AND OPEN SPACE ETC. SHOWN IN DEMARCATION PLAN ARE ACTUALLY ON SITE.

ARCHITECT SIGN.

AREA STATEMENT

	AREA IN SQ.M
AREA UNDER LAND (AS PER 7/12)	27,600.00
AREA UNDER D.P. ROAD	3076.50
AREA UNDER OPEN SPACE	2453.00
AREA UNDER MSEB	150.00
AREA UNDER COLONY ROAD	3382.19
AREA UNDER PLOTS	18539.31

NOTES

ALL DIMENSION ARE IN METER
LAND BOUNDARY SHOWN IN BLACK
OPEN SPACE SHOWN IN GREEN
PREVIOUSLY FINAL APPR. LAYOUT LT. NO. 112 DT. - 14.05.2002

REVISED DEMARCATED FINAL LAYOUT PLAN IN S. NO. 773 AT - NASHIK

FOR. SHRI. P. H. KOKNI & OTHERS
G.P.A. HOLDER, SHRI. V. F. SABADRA +1

SHRI G. V. KATALE
ARCHITECT SIGN.

G.P.A. HOLDER SHRI V. F. SABADRA +1
OWNER SIGN.

SIGN. OF OTHERS G.P.A HOLDERS

G.V.KATALE AND ASSOCIATES
CONSULTING ENGINEERS & ARCHITECTS
OFF: 105, SHRIRAM SANKUL,
OPP. HOTEL PANCHVATI, NASIK-ROAD,
NASHIK-1 PH.(0Y) 550926,579927

JOB NO.	DATE- 25.11.2002	CLD. BY- KATALE G. V.	
DRG. NO	SCALE- 1:500	DRN. BY- APPA	