
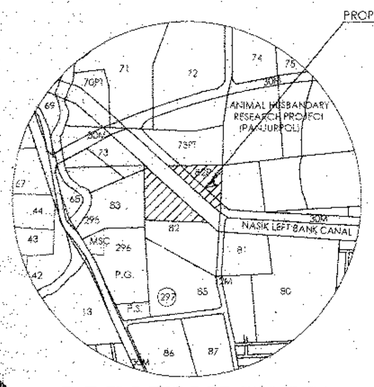


LOCATION PLAN

SCALE 1:10,000 (D. P. PAGE No.10)

PLOT AREA STATEMENT

PLOT NO.	AREA IN SQM.	PLOT NO	AREA IN SQM.	PLOT NO.	AREA IN SQM
1	713.68	12	220.48	25	218.61
2	856.60	13	220.86	26	221.40
3	481.61	14	221.79	27,28,29	216.00
4	247.44	15	222.73	30	265.50
5	245.03	16	223.66	31	380.00
6	216.89	17	224.53	32,33	230.00
7	214.08	18	225.46	34	282.70
8	212.82	19	226.40	35	292.70
9	211.56	20	229.94	36	494.60
10	227.86	21	223.47	37	461.55
11	382.48	22,23,24	207.00		
				TOTAL PLOTED AREA =10595.43 SQM.	

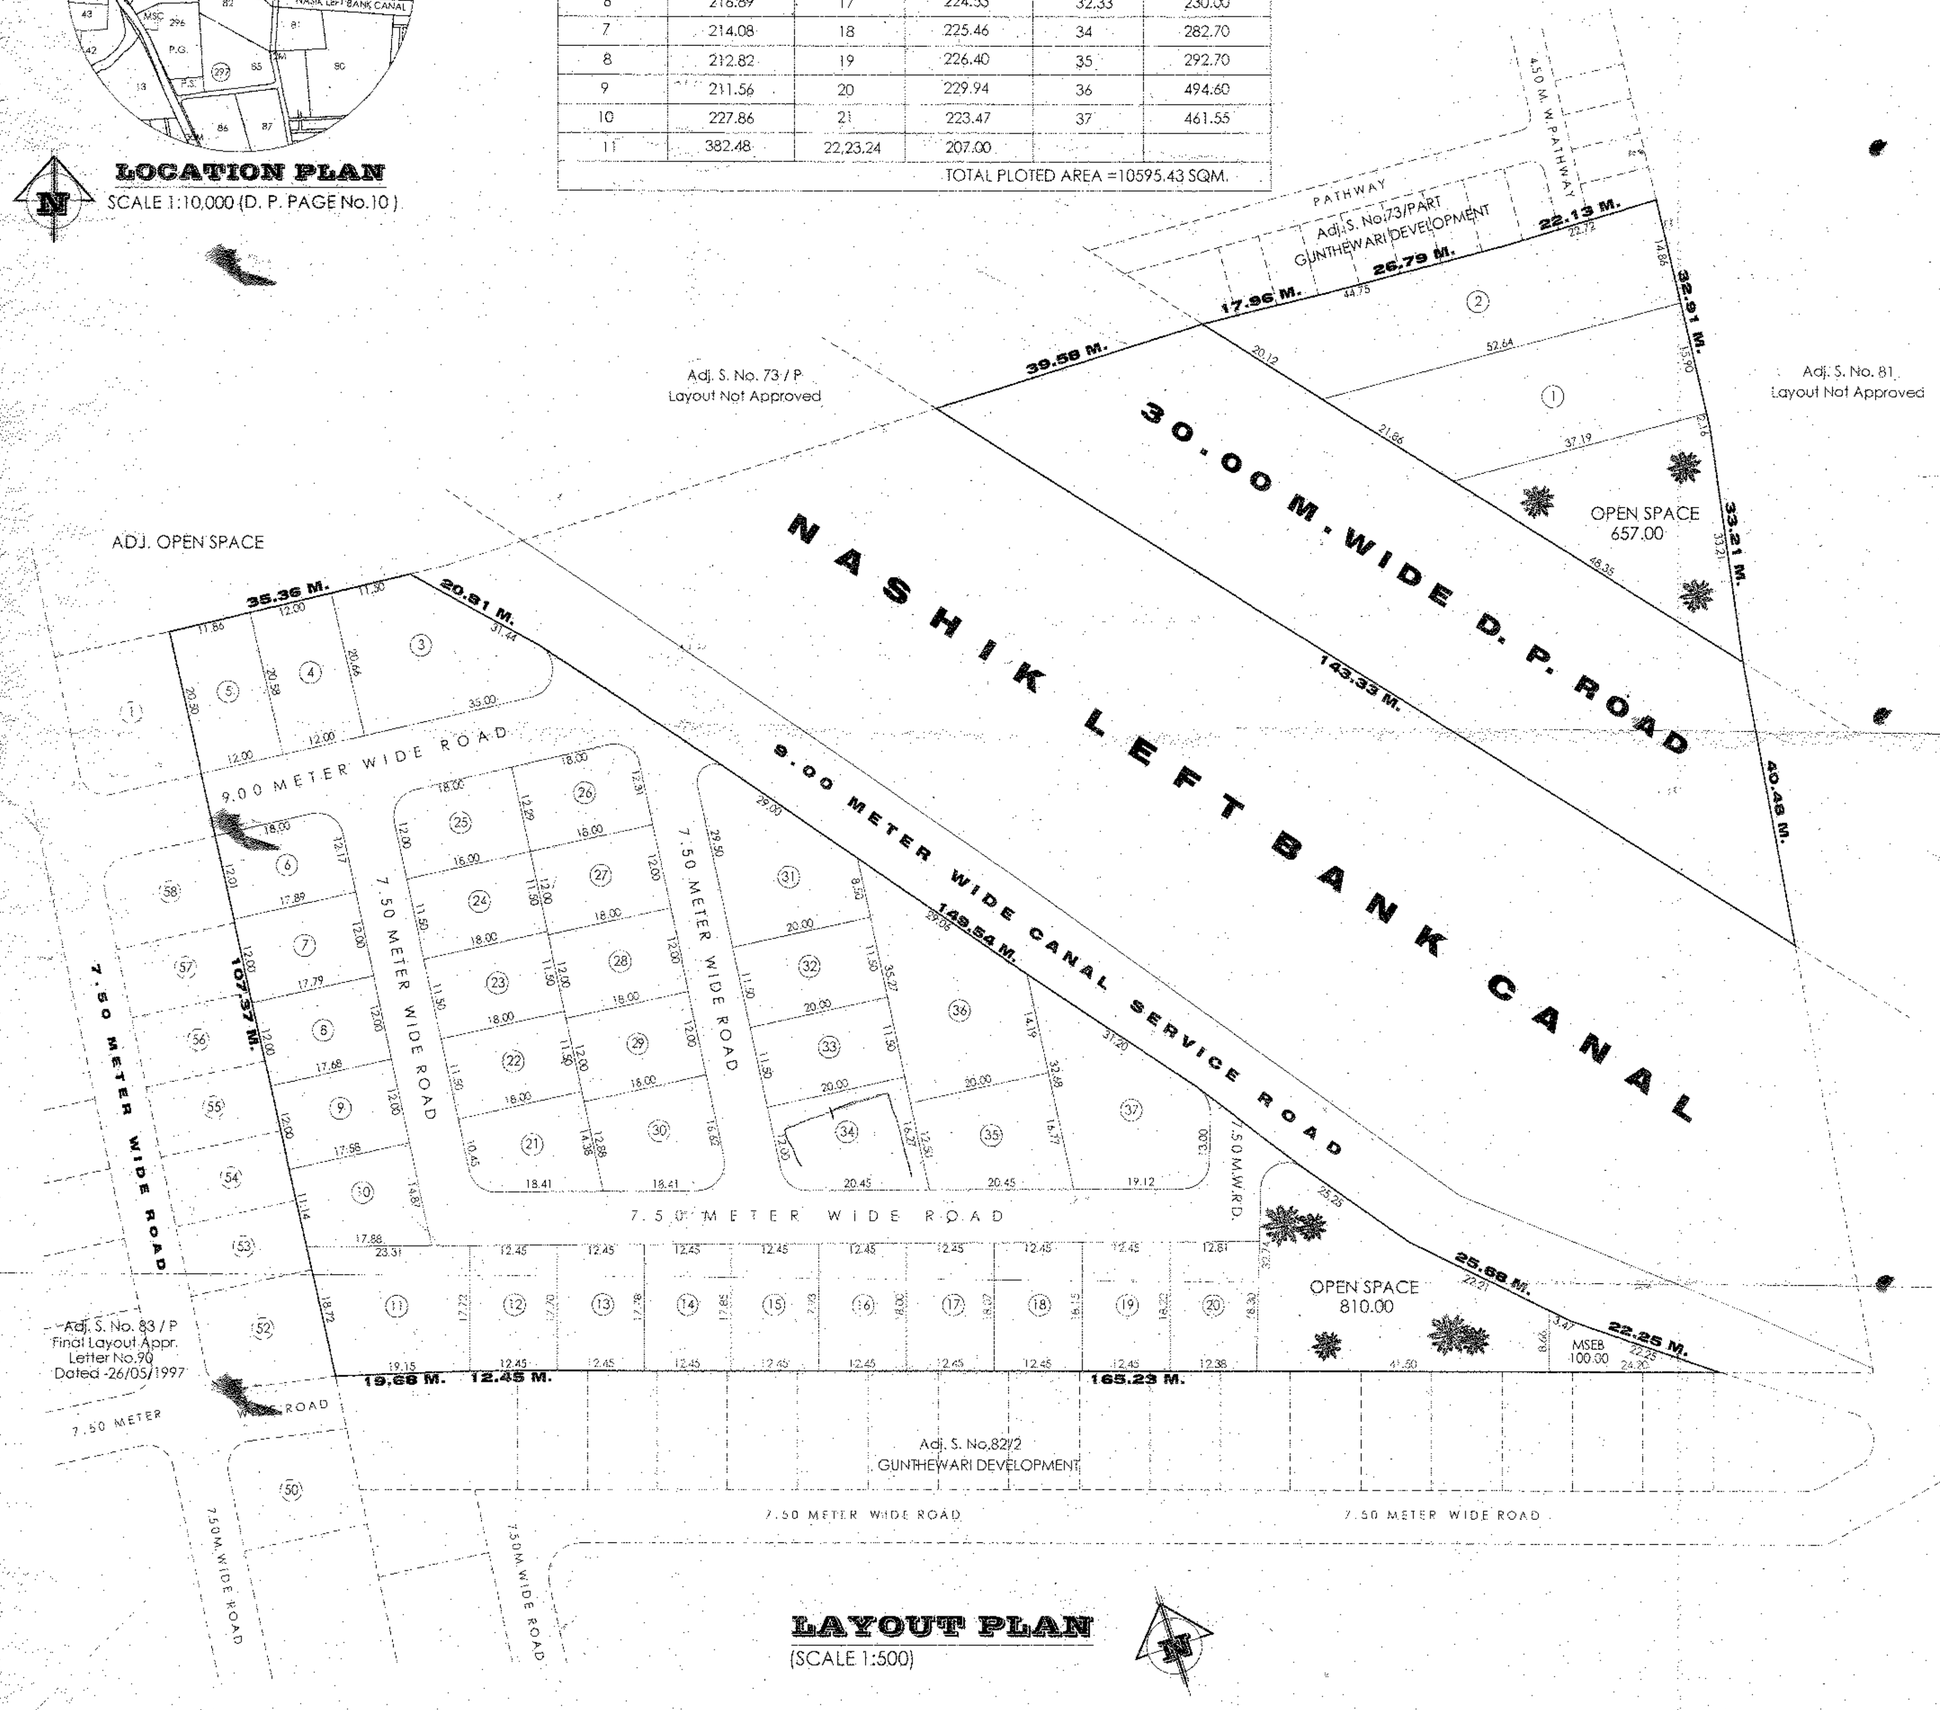

LAYOUT PLAN

(SCALE 1:500)

APPROVAL

APPROVED

(Demarketed Final) Layout as per Conditions. Mentioned in the letter No. LND/WS/C-1/70(Panch),dated 30/11/2009 View of Section 152 (13) and 69 of the Maharashtra Regional and Town Planning Act 1966.

Sd /- x-x-x
Assistant Director of Town Planning
Nashik Municipal Corporation
Nashik

DEMARCATION CERTIFICATE

THIS IS TO CERTIFY THAT I HAVE PERSONALLY DEMARCATED THIS LAYOUT WHICH IS TENTATIVELY APPROVED BY NASHIK MUNCIPAL CORPORATION NASHIK VIDE LT. NO. 102 (PANCH). DT. 01/02/2008 AND FURTHER CERTIFY THAT THE MEASUREMENTS OF PLOTS, ROADS AND OPEN SPACE ETC. SHOWN IN DEMARCATION PLAN ARE ACTUALLY ON SITE.

ARCHITECT SIGN.

AREA STATEMENT

	AREA IN SQM.
1) AREA OF THE LAND (AS PER 7/12)	21,100.00
2) AREA UNDER EXIST.RD,CANAL,FADIT & ENCROACH.	2930.00
3) AREA UNDER D. P. ROAD	3500.00
4) NET AREA UNDER LAYOUT	14670.00
5) AREA UNDER OPEN SPACE	1467.00
6) AREA UNDER M.S.E.B.	100.00
7) AREA UNDER COLONY ROAD	2507.57
8) AREA UNDER PLOTS	10595.43

NOTES :-

1. ALL DIMENSIONS ARE IN METER.
2. LAND BOUNDARY SHOWN IN BLACK.
3. OPEN SPACE SHOWN IN GREEN.

DEMARKETED FINAL LAYOUT PLAN IN S.NO.82/1 OF NASHIK FOR ——— / SHRI MANOHAR S.PATIL &OTHERS 3, G.P.A.HOLDER FOR SELF & OTHERS 3 SHRI. SANDIP G. MHATRE .

	SHRI SANDIP G. MHATRE	SHRI GANPAT K.MHATRE
	SHRI MANOHAR S.PATIL	SHRI [illegible] K.MHATRE
	SHRI P.P.GAVAND	SMT. [illegible]
		SAU.YOGITA KAILAS PATIL
AR. SHRI G. V. KATALE	SAU.GAURI R.PATHAREAR	SHRI REKHA K. PATHAREAR
ARCHITECT SIGN	OWNER SIGN	

G.V. KATALE AND ASSOCIATES
CONSULTING ENGINEERS & ARCHITECTS
OFFICE No. 01, KAMAL RESIDENCY, PATIL LANE No. 4, COLLEGE ROAD, NASHIK-5. PH.: (0) 2360928, 2579929
Email : gv_katale@sify.com

ACCESS KEY : D:\NASHIK\S.NO. 82/P | DATE : 16-OCT-2008 | CKD. BY - KATALE G. V.
JOB REF : AS PER P.T.SHEET | SCALE : 1:500 | DRN. BY - RAHUL GHATE