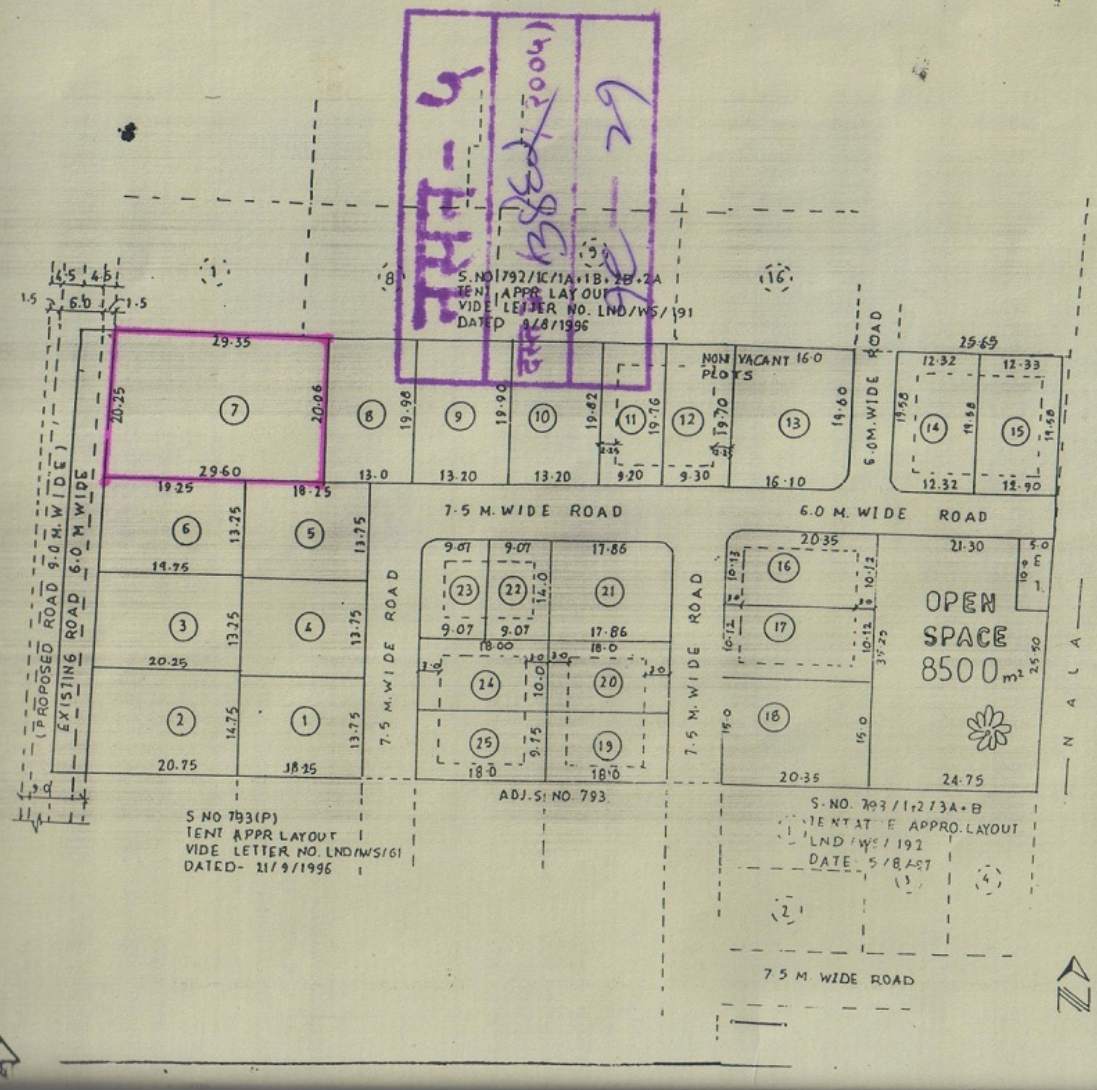


APPROVED


(Demarked final) Layout as per the conditions mentioned in the letter no. LND/ws/392/dt. 16/1/1998. View of section 152(1) & 69 of the Maharashtra Regional & Town Planning Act 1966.

Assistant Director of Town Planning
Nashik Municipal Corporation.
Nashik.

PLOT NO.	AREA	PLOT NO.	AREA
1	250 · 94	13	316 · 50
2	302 · 01	14	241 · 22
3	265 · 00	15	247 · 00
4	250 · 94	16	206 · 14
5	250 · 94	17	205 · 94
6	258 · 00	18	305 · 25
7	593 · 92	19	175 · 50
8	260 · 26	20	180 · 00
9	263 · 20	21	250 · 04
10	262 · 15	22	126 · 98
11	181 · 94	23	126 · 98
12	183 · 50	24	180 · 00
		25	175 · 50

+ AREA STATEMENT +

	sq.m
AREA OF LAND (as per 7/12)	8500 · 00
AREA UNDER	
OPEN SPACE	850 · 00
ELECTRIC TRANSFORMER	50 · 00
ROAD	1528 · 19
PLOT	6059 · 85
NALA	11 · 96

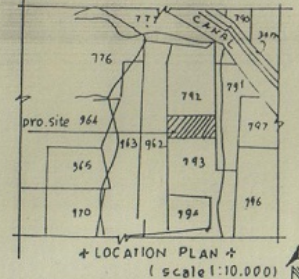

+ LOCATION PLAN +
(scale 1:10,000)

+ DEMARKETION CERTIFICATE +

This is to certify that I have personally demarketed this layout which was approved 'TENTATIVELY' by Nasik Municipal Corporation vide letter no. 561/ dated 20/3/1998 and further certify that the measurement of plots, open spaces, road etc as on demarketion plan are actually tally on site.

engineer's sign

+ NOTE +

+ Land boundry shown in black.
+ Open space shown in green.

DEMARKETED FINAL LAYOUT PLAN OF S. NO. 792/1A/1+2+3 AT NASIK, FOR SHREE BALASAHEB NIVRUTI PANGARE AND OTHERS,
G.P.A. HOLDER,
SHREE. D.R. BAGAD, AND OTHERS

+ G. P. A. HOLDER + | + ENGINEER +

Sunil Venikar
+ CONSULTING ENGINEER +
24, SHRAMIK COLONY-1, GANGAPUR ROAD, NASIK-5. PH. NO.-578748.

drn. by: jayesh	chkd by: S.V.
scale 1:500	drg no: 2