


LOCATION PLAN

SCALE 1:10,000 (D. P. PAGE NO. 14)

PLOT AREA STATEMENT

PLOT NO.	AREA IN SQM.
1	321.56
2	250.87
3	254.37
4	258.12
5	259.37
6	190.80
7	180.90
8 TO 14	250.00
15	269.62
TOTAL	3735.61

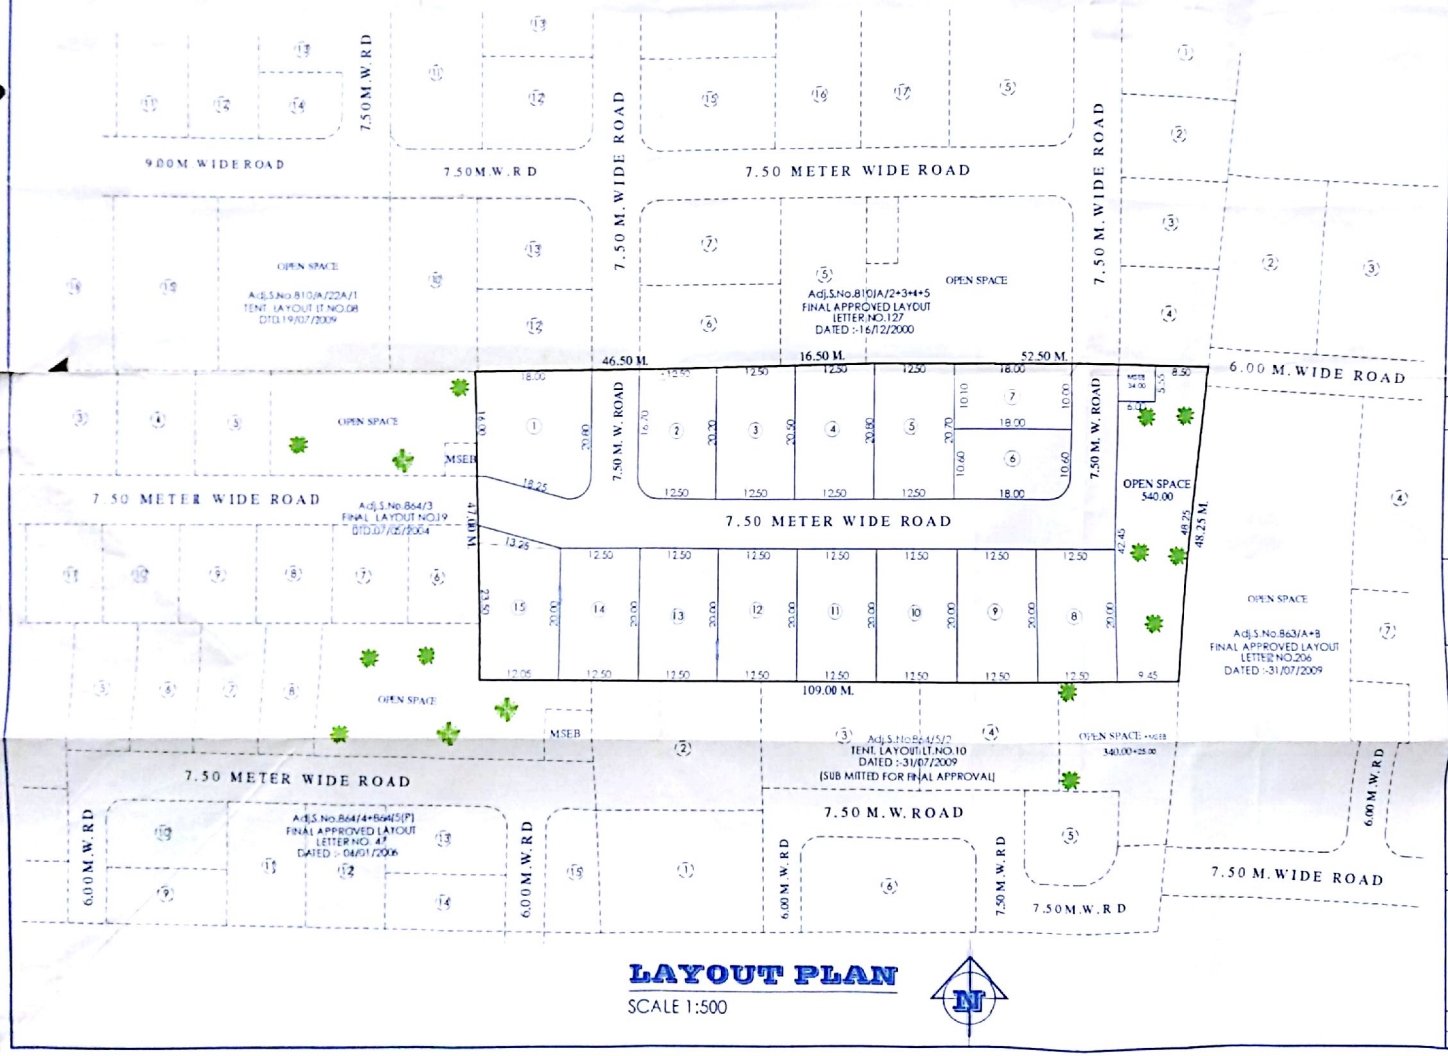

LAYOUT PLAN

SCALE 1:500

APPROVAL

APPROVED
(Demarketed Final) Layout as per Conditions Mentioned in the letter No. LND/WS/A-4/36, dated 14/09/2010 View of Section 152 (13) and 69 of the Maharashtra Regional and Town Planning Act, 1966.

Sd / - x x x
Assistant Director of Town Planning
TOWN PLANNING
Nashik Municipal Corporation
Nashik

TRUE COPY
(KATALE G. V.)
ARCHITECT

DEMARCATION CERTIFICATE

THIS IS TO CERTIFY THAT I HAVE PERSONALLY DEMARCATED THIS LAYOUT WHICH IS TENTATIVELY APPROVED BY NASHIK MUNCIPAL CORPORATION NASHIK VIDE LT. NO.125, DT.15/03/2005 AND FURTHER CERTIFY THAT THE MEASUREMENTS OF PLOTS, ROADS AND OPEN SPACE ETC. SHOWN IN DEMARCATION PLAN ARE ACTUALLY ON SITE.

ARCHITECT SIGN.

AREA STATEMENT

	AREA IN SQM.
1) AREA OF THE LAND (AS PER 7/12)	5400.00
2) AREA UNDER OPEN SPACE	540.00
3) AREA UNDER M.S.E.B.	34.00
4) AREA UNDER COLONY ROAD	1090.39
5) AREA UNDER PLOTS	3735.61

NOTES :-
- ALL DIMENSIONS ARE IN METER.
- LAND BOUNDARY SHOWN IN BLACK.
- OPEN SPACE SHOWN IN GREEN.

DEMARCATED RESIDENTIAL FINAL LAYOUT PLAN IN S.NO. 864/6 OF NASHIK SHIWAR IN NASHIK FOR
SHRI. SHAKEEL AHMED ABDUL GAFOOR QUAZI

AR. SHRI G. V. KATALE	SHRI. SHAKEEL AHMED ABDUL GAFOOR QUAZI
ARCHITECT SIGN	OWNER SIGN

G.V. KATALE AND ASSOCIATES
CONSULTING ENGINEERS & ARCHITECTS
OFFICE No. 01 KAMAL RESIDENCY,
PATIL LANE No.4 COLLEGE ROAD,
NASHIK-5 PH (O) 2580928, 2579927
Email : gv.katale@sify.com

ACCESS KEY : D:\Nashik\S.NO 864\4.DAT	DATE : 07/09/2010	CKD BY : KATALE G. V.
JOB REF : AS PER P.T.SHEET	SCALE : 1 : 500	DRN. BY : Navlakhe

Generated by CamScanner from intsig.com