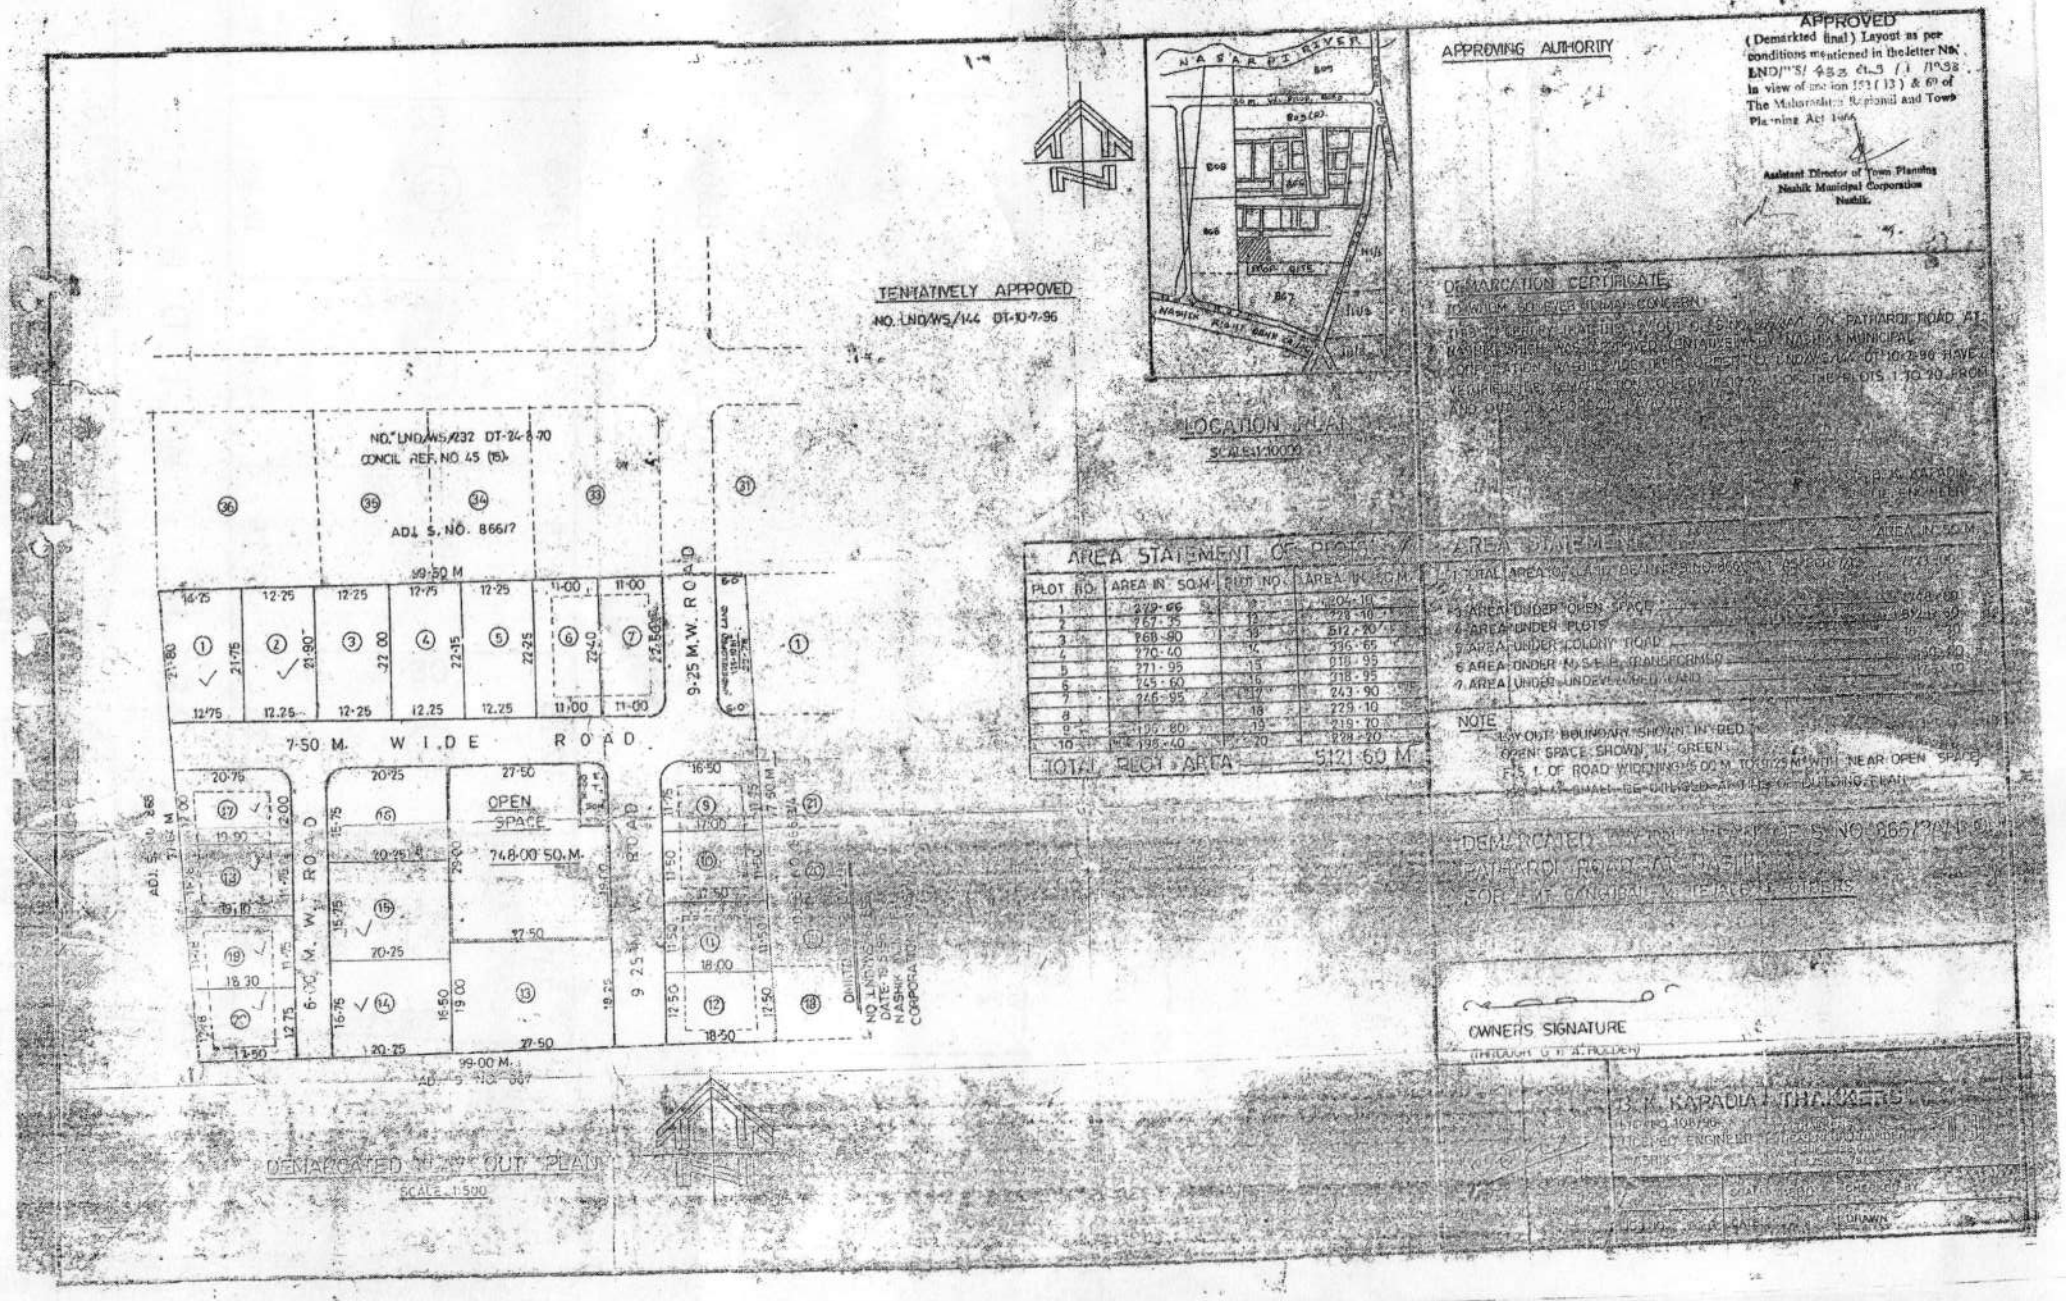

APPROVED
( Demarkted final ) Layout as per conditions menticned in the letter No. END/TS/ 433 dt. 3 / 1 /1998 in view of section 153 ( 13 ) & 69 of The Maharashtra Regional and Town Planning Act 1966
Assistant Director of Town Planning Nashik Municipal Corporation Nashik.
APPROVING AUTHORITY
TENTATIVELY APPROVED
NO. LND/WS/144 DT-10-7-96
NO. LND/WS/232 DT-24-8-70
CONCIL REF. NO. 45 (15)
ADJ. S. NO. 866/7
99.50 M
9.25 M.W. ROAD
7.50 M. WIDE ROAD
OPEN SPACE
748.00 SQ.M.
99.00 M.
LOCATION PLAN
SCALE 1:1000
AREA STATEMENT OF PLOTS
PLOT NO. | AREA IN SQ.M. | PLOT NO. | AREA IN SQ.M.
1 | 272.66 | 12 | 204.10
2 | 267.35 | 13 | 228.10
3 | 268.90 | 14 | 512.20
4 | 270.40 | 15 | 396.66
5 | 271.95 | 16 | 218.95
6 | 245.60 | 17 | 243.90
7 | 246.95 | 18 | 229.10
8 | 199.80 | 19 | 219.70
9 | 199.80 | 20 | 829.20
10 | 196.40
TOTAL PLOT AREA 5121.60 M
DEMARCATION CERTIFICATE
TO WHOM SO EVER IT MAY CONCERN
THIS IS TO CERTIFY THAT THE LAYOUT OF LAND SITUATED ON PATHARDI ROAD AT NASHIK WHICH WAS APPROVED TENTATIVELY BY NASHIK MUNICIPAL CORPORATION VIDE THEIR LETTER NO. LND/WS/144 DT 10-7-96 HAVE BEEN DEMARCATED ON THE GROUND BY US TODAY THE 17-7-98 OF THE PLOTS 1 TO 10 FROM AND OUT OF SURVEY NO. 866/7A/1A
P. K. KAPADIA
CIVIL ENGINEER
AREA STATEMENT
AREA IN SQ.M
1. TOTAL AREA OF LAND AS PER 7/12 EXTRACT OF S.NO. 866/7A/1A
2. AREA UNDER OPEN SPACE
3. AREA UNDER PLOTS
4. AREA UNDER COLONY ROAD
5. AREA UNDER M.S.E.B. TRANSFORMER
6. AREA UNDER UNDEVELOPED LAND
NOTE
LAYOUT BOUNDARY SHOWN IN RED
OPEN SPACE SHOWN IN GREEN
F.S.I. OF ROAD WIDENING 9.00 M. TO 12.25 M. WITH NEAR OPEN SPACE
DEMARCATED LAYOUT PLAN OF S.NO. 866/7A/1A, 8
PATHARDI ROAD AT NASHIK
FOR SMT. GANGABAI M. TELI & OTHERS
OWNERS SIGNATURE
THROUGH G.P.A. HOLDER
P. K. KAPADIA & THAKKERS
CIVIL ENGINEERS & TOWN PLANNERS
LIC. NO. 108/96
DEMARCATED LAY OUT PLAN
SCALE 1:500
DRAWN
CHECKED BY