



LAND AREA STATEMENT

PLOTWISE AREA STATEMENT

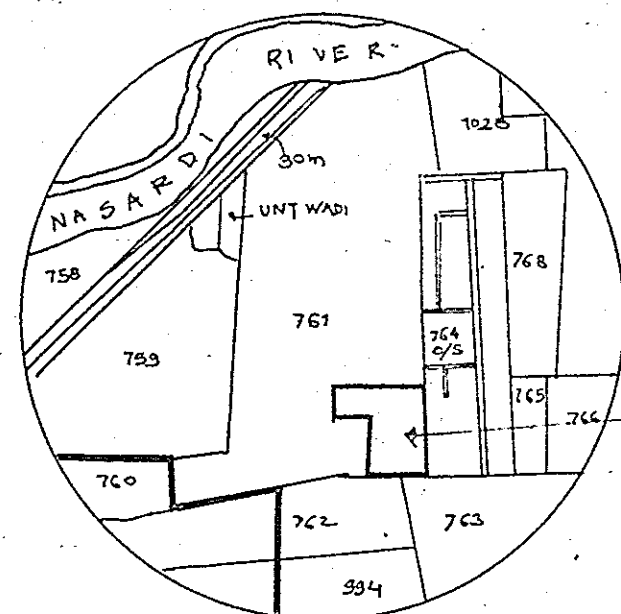

LOCATION PLAN

SCALE 1:10,000

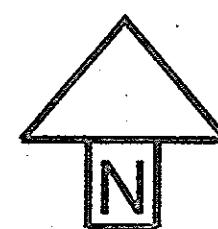

S.NO/HISSA NO	AREA IN SQ.M.
761/6/4/4	2000.00
761/6/4/5	1500.00
761/6/4/6	2000.00
761/6/4/7	2000.00
761/6/4/8	2000.00
TOTAL LAND AREA = 9500.00	

PLOT NOS.	AREA IN SQ.M.	PLOT NOS.	AREA IN SQ.M.
1.	263.25	14.	210.00
2.	258.75	15.	460.00
3.	242.25	16, 17.	225.00
4.	238.69	18.	240.00
5.	192.00	19, 20.	235.00
6.	198.28	21.	227.50
7.	202.69	22.	219.31
8.	217.38	23 TO 26.	210.25
9.	224.25	27.	217.50
10.	251.22	28.	195.75
11.	238.34	29, 30.	163.125
12, 13.	210.00	TOTAL	6804.41

APPROVAL

APPROVED
(DEMARKETED FINAL) LAYOUT AS
PER CONDITIONS MENTIONED IN THE
LETTER NO. LNDWS/31 DT. 22/07/2002
VIEW OF SECTION 152 (13) AND 69 OF
THE MAHARASHTRA REGIONAL AND
TOWN PLANNING ACT, 1966

TRUE COPY

(KATALE G. V.)
ARCHITECT

SD/- X. X. X.

ASSISTANT DIRECTOR OF TOWN PLANNING
NASHIK MUNICIPAL CORPORATION
NASHIK.

DEMARCATON CERTIFICATE

THIS IS TO CERTIFY THAT I HAVE PERSONALLY
DEMARCATED THIS LAYOUT WHICH IS TENTATIVELY
APPROVED BY NASHIK MUNICIPAL CORPORATION
NASHIK VIDE LT. NO. 15, DT. 08/04/1999 AND
FURTHER CERTIFY THAT THE MEASUREMENTS OF
PLOTS, ROADS AND OPEN SPACE ETC. SHOWN IN
DEMARCATON PLAN ARE ACTUALLY ON SITE.

(Signature)
ARCHITECT SIGN.

AREA STATEMENT - AREA IN SQ.M.

AREA OF THE LAND AS PER 7/12	9500.00
AREA UNDER OPEN SPACE	950.00
AREA UNDER M.S.E.B. TRANSFORMER	50.00
AREA UNDER ROADS	1695.59
AREA UNDER PLOTS	6804.41

NOTES

ALL DIMENSIONS ARE IN METER
LAND BOUNDARY SHOWN IN BLACK.
OPEN SPACE SHOWN IN GREEN.

DEMARCATED FINAL LAYOUT
PLAN IN S. NO. 761/6/4/108 AT
NASHIK...

FOR SHRI. P. B. JAGTAP & OTHERS.
G.P.A. HOLDER SHRI. A. B. JAGTAP.

(Signature)
SHRI G. V. KATALE

ARCHITECT SIGN.

(Signature)
G.P.A. HOLDER, SHRI. A. B. JAGTAP.


OWNER SIGN.



G.V. KATALE AND ASSOCIATES
CONSULTING ENGINEERS & ARCHITECTS

OFF: 108, SHRIRAM SANKUL,
OPP. HOTEL PANCHAVATI, WAKIL-WADI,
NASHIK-1 PH.(OFF) 580928, 579927

JOB NO.	DATE- 11.06.2002	CLD. BY-KATALE G. V.
DRG. NO.	SCALE- 1:500	DRN. APPA

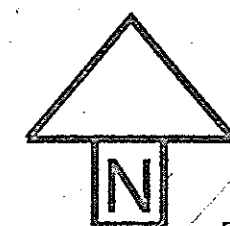

LAYOUT PLAN

SCALE 1:500