
LAND AREA STATEMENT

S.NO/ H1558 NO	AREA IN SQM.
761/6/4/4	2000·00
761/6/4/5	1500·00
761/6/4/6	2000·00
761/6/4/7	2000·00
761/6/4/8	2000·00
TOTAL LAND AREA = 9500·00	


PLOTWISE AREA STATEMENT

PLOT NOs.	AREA IN SQ.M.	PLOT NOs.	AREA IN SQ.M.
1.	263.25	14.	210.00
2.	258.75	15.	460.00
3.	242.25	16, 17.	225.00
4.	238.69	18.	240.00
5.	192.00	19, 20.	235.00
6.	198.28	21.	227.50
7.	202.69	22.	219.31
8.	217.38	23 TO 26.	210.25
9.	224.25	27.	217.50
10.	251.22	28.	195.75
11.	238.34	29,30.	163·125
12, 13.	210.00	TOTAL	6804.41

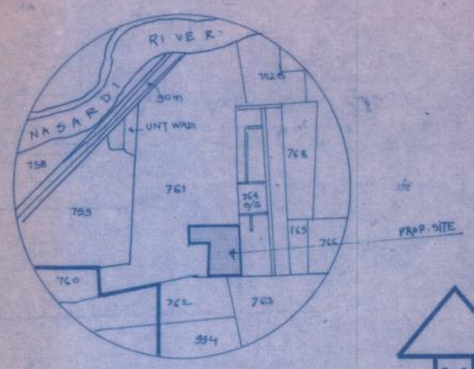

LOCATION PLAN

SCALE 1:10,000

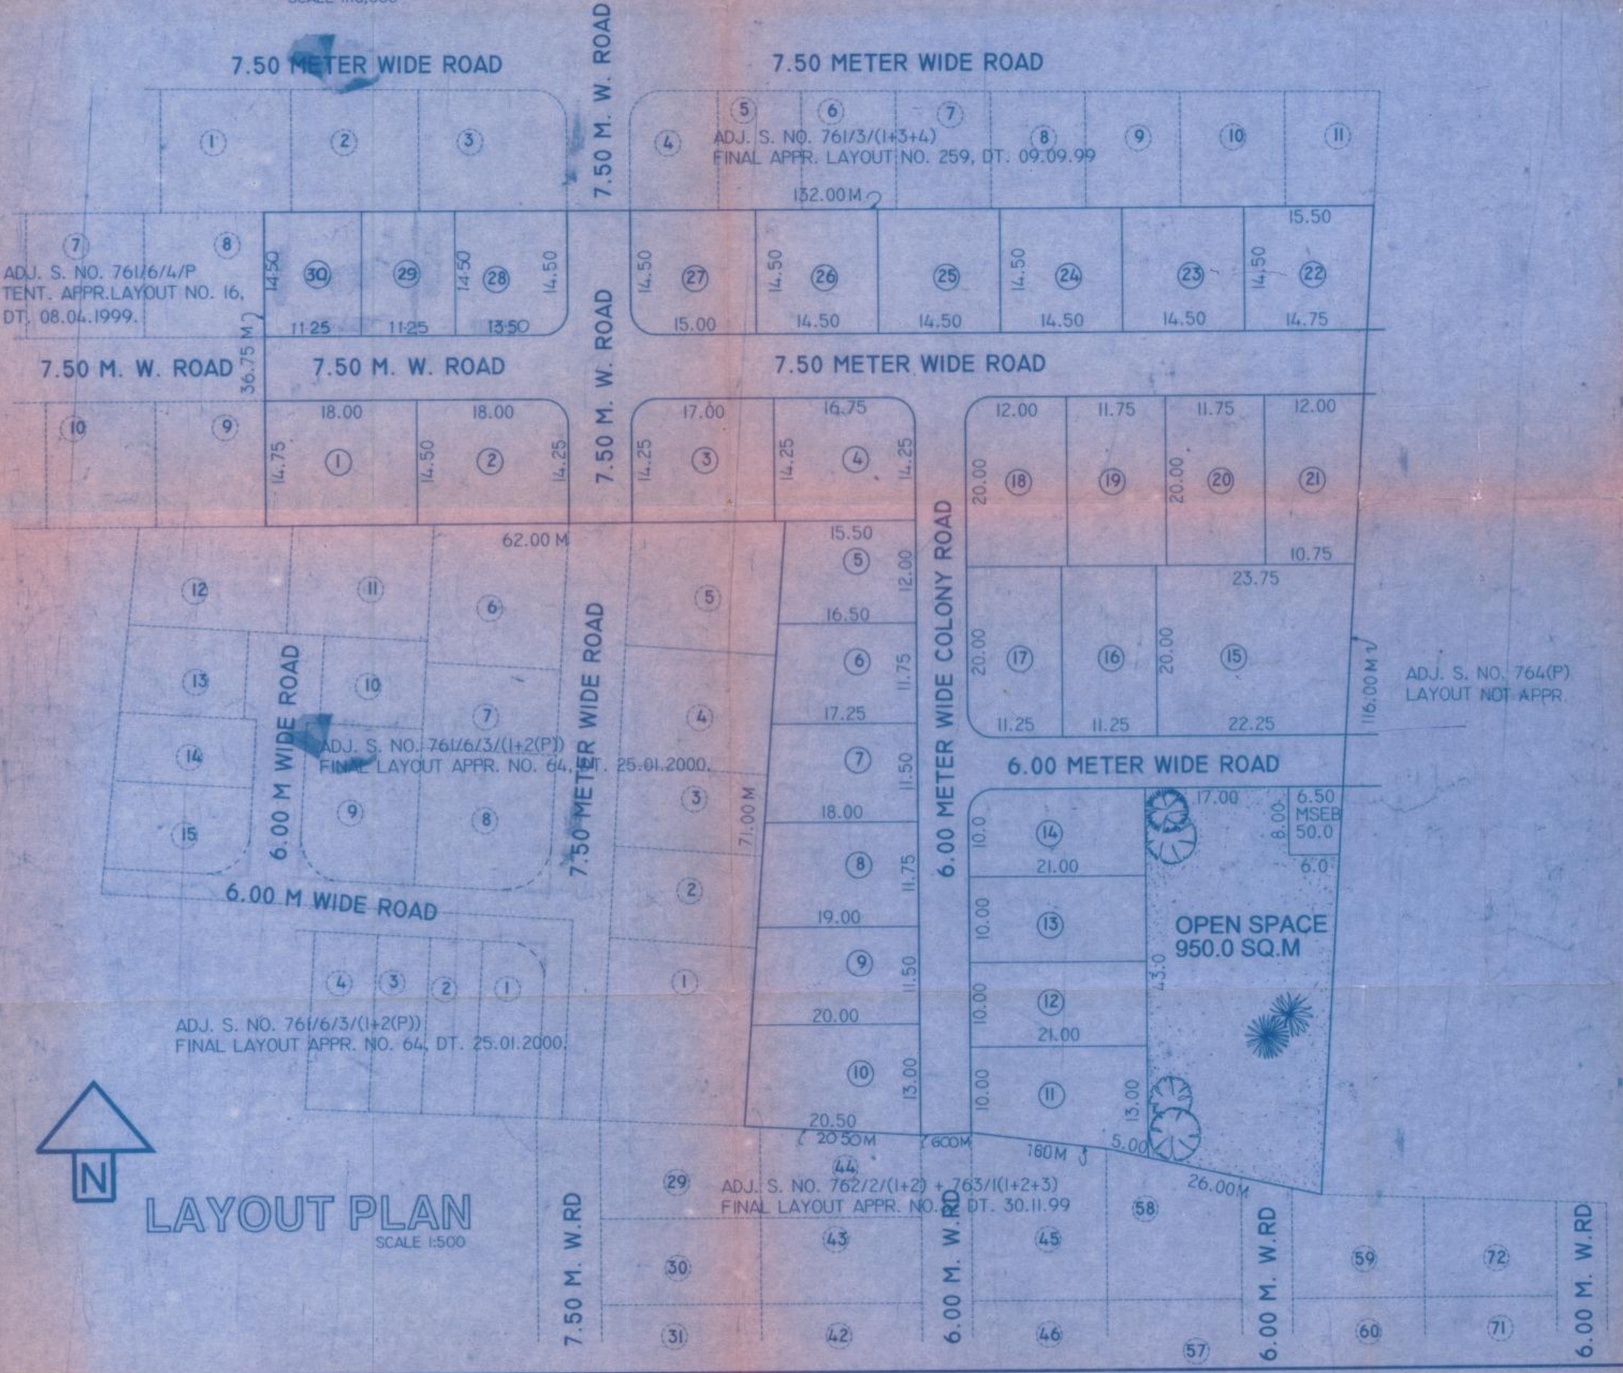

LAYOUT PLAN

SCALE 1:500

APPROVAL

APPROVED

(DEMARKETED FINAL) LAYOUT AS PER CONDITIONS MENTIONED IN THE LETTER NO. LND/WS/31 DT. 22/07/2002 VIEW OF SECTION 152 (1) AND 69 OF THE MAHARASHTRA REGIONAL AND TOWN PLANING ACT. 1966

TRUE COPY

(KATALE G. V.)
ARCHITECT

SD/- X. X. X.

ASSISTANT DIRECTOR OF TOWN PLANING
NASHIK MUNICIPAL CORPORATION
NASHIK.

DEMARCATION CERTIFICATE

THIS IS TO CERTIFY THAT I HAVE PERSONALLY DEMARCATED THIS LAYOUT WHICH IS TENTATIVELY APPROVED BY NASHIK MUNCIPAL CORPORATION NASHIK VIDE LT. NO. 15, DT. 08/04/1999 AND FURTHER CERTIFY THAT THE MEASUREMENTS OF PLOTS, ROADS AND OPEN SPACE ETC. SHOWN IN DEMARCATION PLAN ARE ACTUALLY ON SITE.

ARCHITECT SIGN.

AREA STATEMENT - AREA IN SQ.M

AREA OF THE LAND AS PER 7/12	9500.00
AREA UNDER OPEN SPACE	950.00
AREA UNDER M.S.E.B. TRANSFORMER	50.00
AREA UNDER ROADS	1695.59
AREA UNDER PLOTS	6804.41

NOTES

ALL DIMENSIONS ARE IN METER
LAND BOUNDARY SHOWN IN BLACK.
OPEN SPACE SHOWN IN GREEN.

DEMARCATED FINAL LAYOUT PLAN IN S. NO. 761/6/4/4 TO 8 AT.- NASHIK...

FOR. SHRI. P. B. JAGTAP & OTHERS.
G.P.A. HOLDER SHRI. A. B. JAGTAP.

SHRI G. V. KATALE.	G.P.A. HOLDER, SHRI. A. B. JAGTAP.
ARCHITECT SIGN.	OWNER SIGN.

G.V.KATALE AND ASSOCIATES
CONSULTING ENGINEERS & ARCHITECTS
OFF: 108,'SHRIRAM SANKUL',
OPP. HOTEL PANCHAVATI, WAKIL-WADI,
NASHIK-1 PH.(OFF) 580928,579927

JOB NO.	DATE- 11.06.2002	CLD. BY-KATALE G. V.
DRG. NO.	SCALE- 1:500	DRN. BY- APPA