


PROP SITE

LOCATION PLAN

SCALE :- 1 : 10000

PLOT WISE AREA STATEMENT

PLOT NOS	AREA IN SQ MT
1	536.54
2	737.64
3	627.00
4	627.00
5	[illegible]
6	244.23
7	127.97
8	125.78
9	178.75
10	255.50
TOTAL	4062.31 SQM

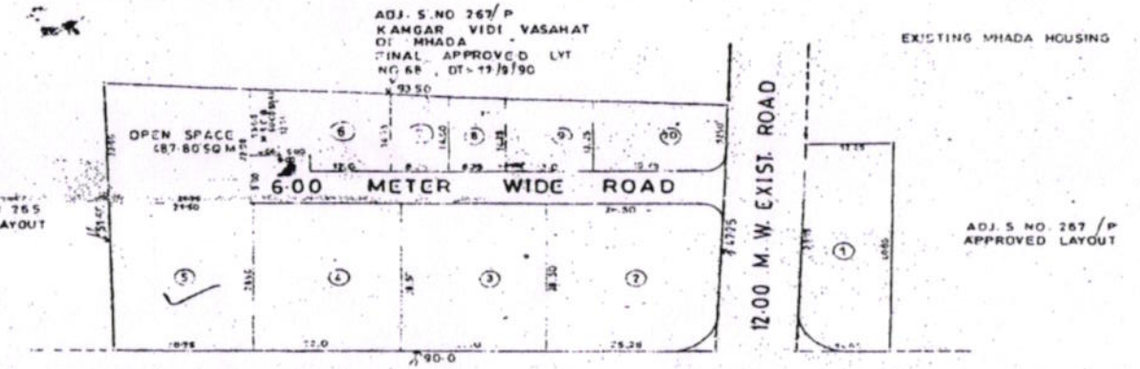

LAYOUT PLAN

APPROVAL

APPROVED
(DEMARKED FINAL) LAYOUT AS PER CONDITION MENTIONED IN THE LETTER NO. LND/WS/1 (Panch) DT. 3.04.2001 VIEW OF SECTION 152(1)3 & 89 OF MAHARASTRA REGIONAL & TOWN PLANING ACT 1966.

SD/-XXX
ASSISTANT DIRECTOR OF TOWN PLANING,
NASHIK MUNICIPAL CORPORATION
NASHIK

DEMARKATION CERTIFICATE

THIS IS TO CERTIFY THAT I HAVE PERSONALLY DEMARKATED THIS LAY OUT WHICH WAS APPROVED TENTATIVELY BY NASHIK MUNICIPAL CORPORATION NASHIK VIDE LETTER NO. LND/WS/152 DT-4/8/1998 AND FURTHER CERTIFY THAT THE MEASURMENT OF PLOTS, ROADS, & OPEN SPACE ETC SHOWN IN DEMARCATION PLAN ARE ACTUAL ON SITE

ARCH. SIGN.

AREA STATEMENT

	AREA IN SQMT
AREA OF THE LAND	4062.00
AREA UNDER OPEN SPACE	487.80
AREA UNDER M.S.E.B.	50.00
AREA UNDER ROAD	[illegible]
AREA UNDER PLOTS	[illegible]

NOTES

ALL DIMENSIONS ARE IN METER
LAND BOUNDARY SHOWN IN BLACK
OPEN SPACE SHOWN IN GREEN

DEMARKATED FINAL LAYOUT
PLAN IN S NO. 267/1/172
AT - NASHIK.
FOR - SHRI: M.L. ZURADE
G.P.A HOLDER- SHRI: B.L. JADHAV

SHRI G.V. KATALE — G.P.A. HOLDER SHRI B.L. JADHAV

ARCHITECT SIGN — G.P.A. SIGN

G. V. KATALE & ASSOCIATES
CONSULTING ENGINEERS & ARCHITECTS
OFF. : 103, 108 'SHRIRAM SANKUL'
OPP. HOTEL PANCHAVATI, VAKIL WADI
NASHIK-1. PH. : (OFF.) 580828, 6799[illegible]

JOB NO. - | DATE - 11/10/99 | [illegible]
DRG NO. - | SCALE - AS SHOWN | [illegible]