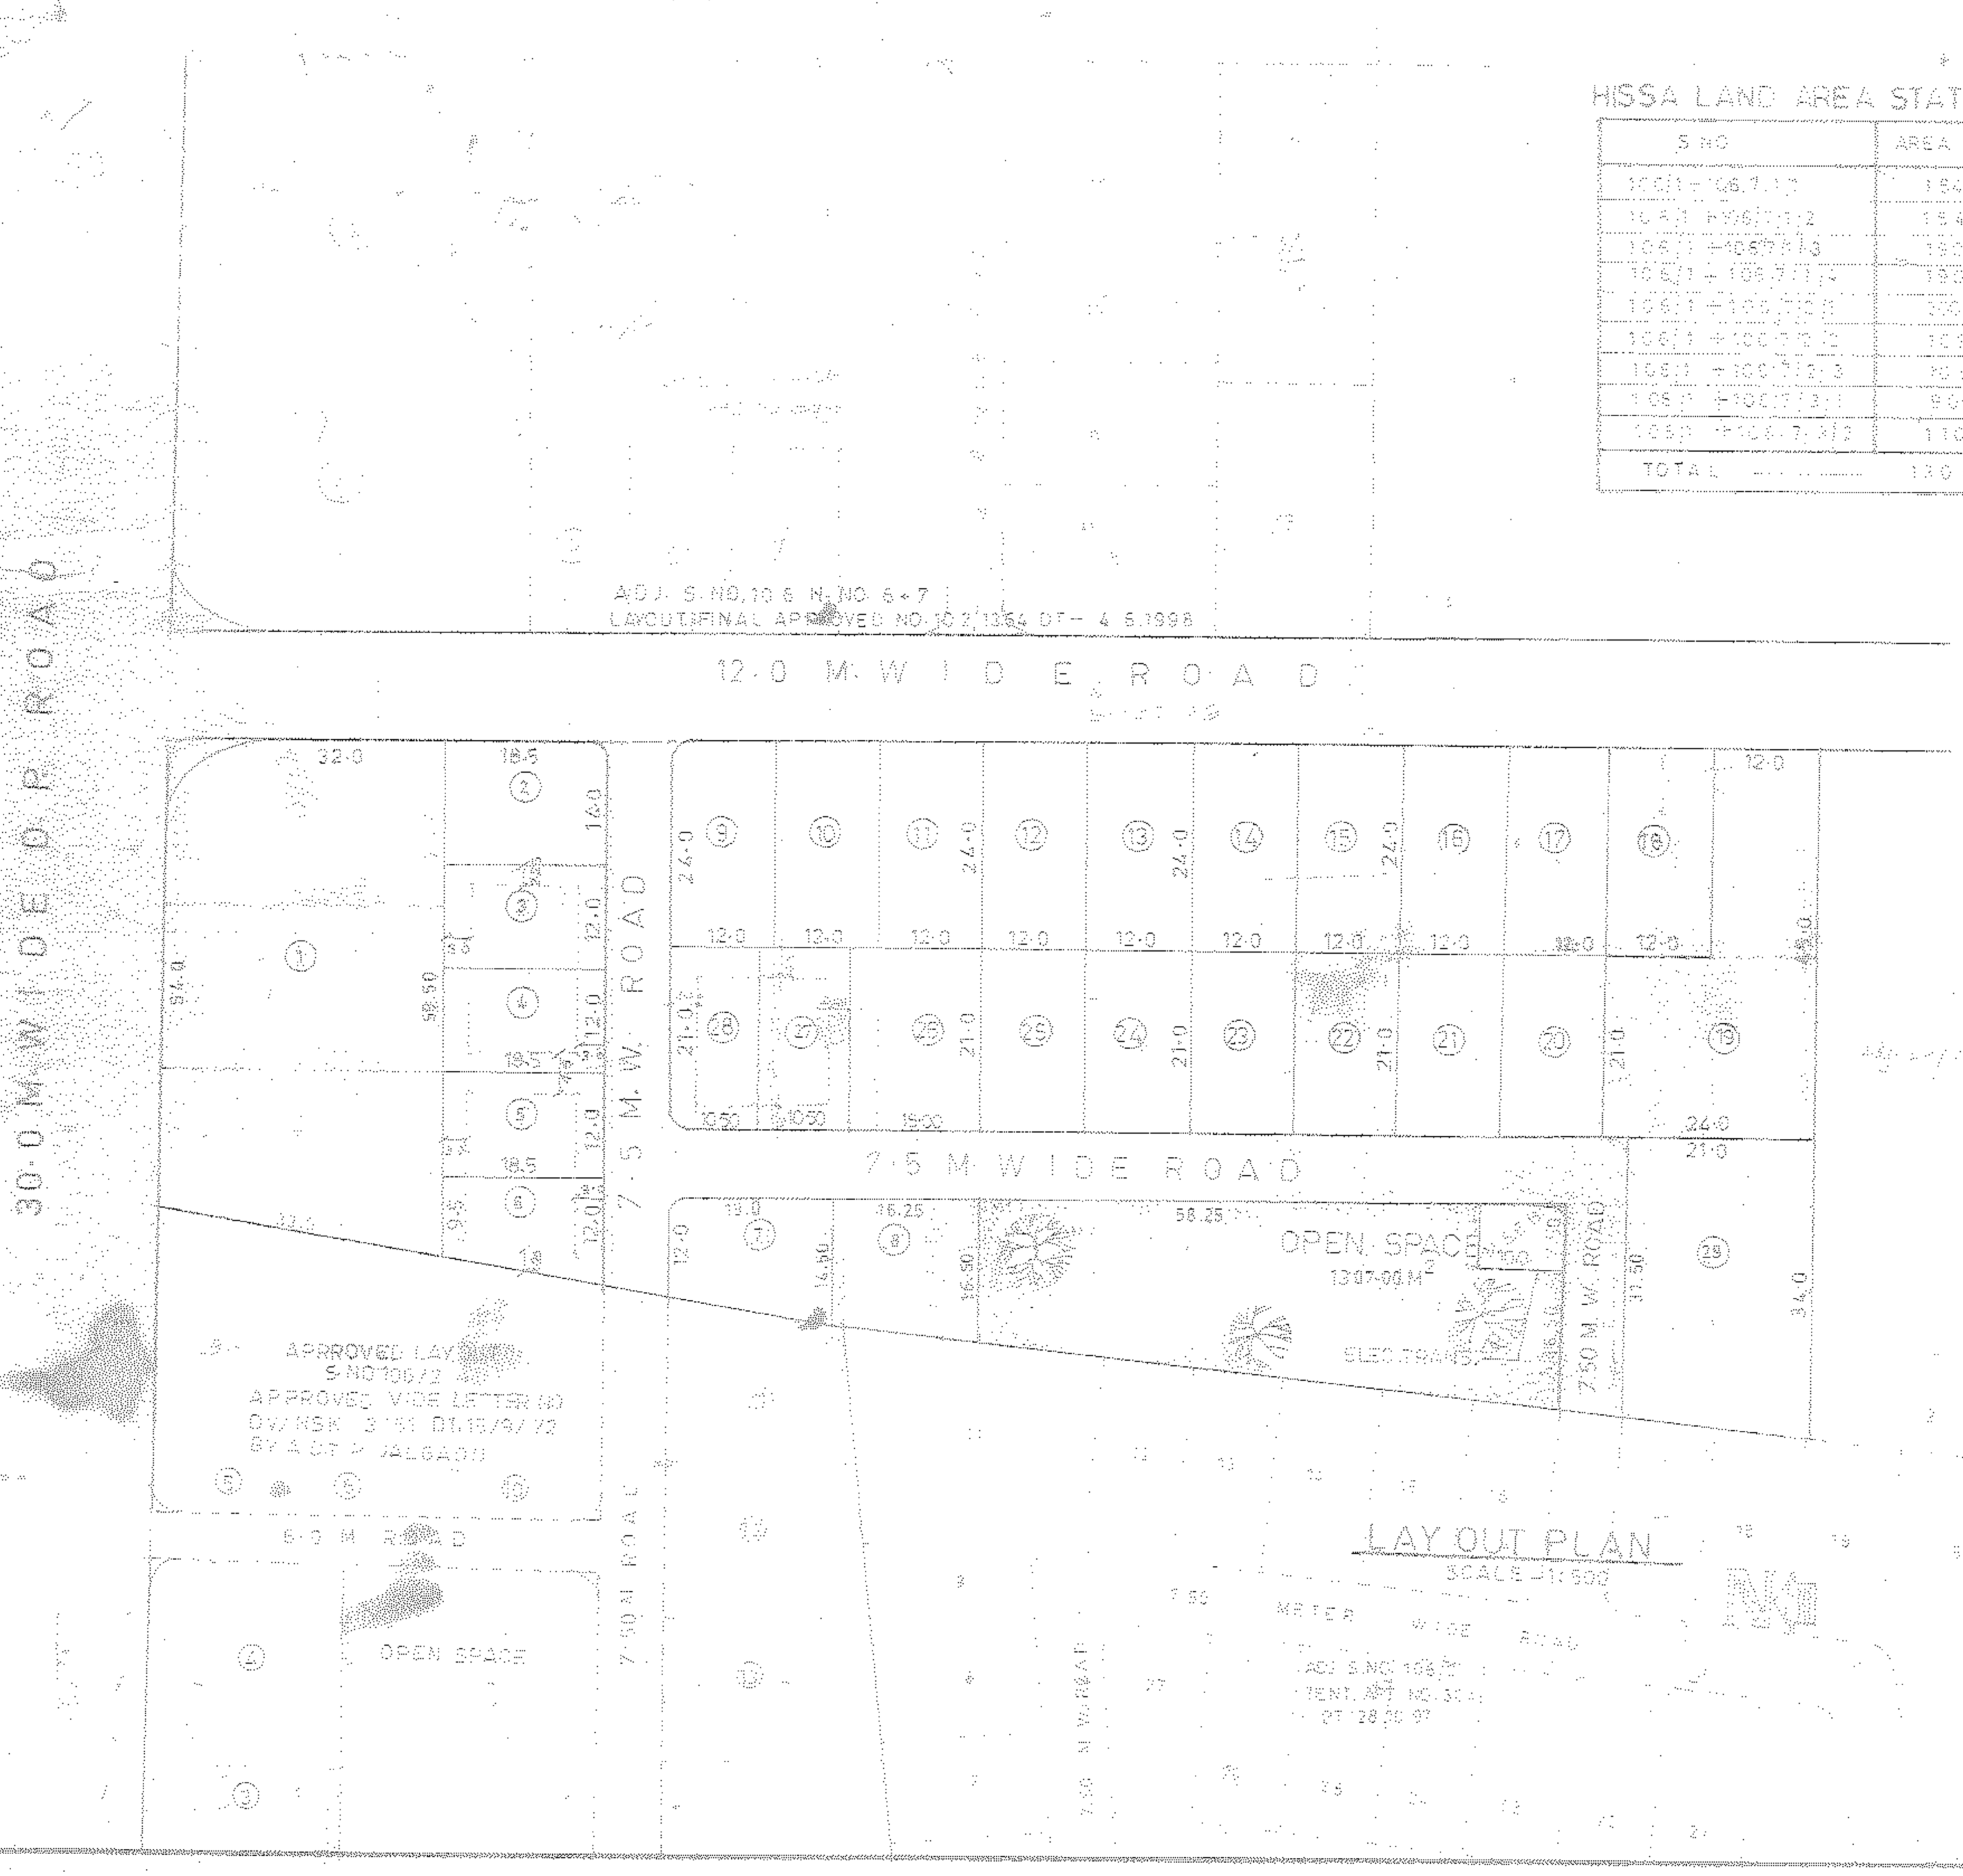


LAY OUT PLAN

SCALE 1:500

HISSA LAND AREA STATEMENT—

S NO	AREA IN SQM
106/1+106/7/1/1	1540.00
106/1+106/7/1/2	1540.00
106/1+106/7/1/3	1800.00
106/1+106/7/1/4	1900.00
106/1+106/7/2/1	2000.00
106/1+106/7/2/2	1090.00
106/1+106/7/2/3	1090.00
106/1+106/7/3/1	900.00
106/1+106/7/3/2	1100.00
TOTAL	13060.00 SQM

DEMARCATION CERTIFICATE

THIS IS TO CERTIFIED THAT I HAVE PERSONALLY DEMARKETED THIS LAYOUT ON SITE WHICH WAS APPROVED TENTATIVELY BY NASHIK MUNICIPAL CORP VIDE LETTER NO. LND/WS/435 DT— 8.12.96 AND FURTHER CERTIFY THAT THE MEASURMENT OF PLOTS ROADS ETC. SHOWN ON DEMARCATION PLAN ARE ACTUALY ON SITE

TRUE COPY

ARCHITECT SIGN

APPROVAL

DEMARKETED FINAL LAYOUT AS PER CONDITIONS MENTIONED IN THE LETTER NO. LND/WS/237/DT— 15/9/1998 VIEW OF SECTION 152 (13) AND 89 OF THE MAHARASHTRA REGIONAL AND TOWN PLANNING ACT 1966.

SD/-

ASSISTANT DIRECTOR OF TOWN PLANNING NASHIK MUNICIPAL CORPORATION NASHIK

DEMARKETED FINAL LAYOUT PLAN OF S.NO.106/1+106/7/1/1, 1/2, 1/3, 1/4, 2/1, 2/2, 2/3, 3/1, 3/2 AT VILLAGE WADALA TAL & DIST. NASHIK

FOR —

SHRI. YESHWANT A. SHINDE & OTHERS

AREA STATEMENT—


	AREA IN SQM
1. AREA OF THE LAND S.NO.106 AS PER 7/12	13060.00
2. AREA UNDER OPEN SPACE	[illegible]
3. AREA UNDER M.S.E.B.	[illegible]
4. AREA UNDER ROAD	[illegible]
5. AREA UNDER PLOTS	[illegible]

PLOT AREA STATEMENT

PLOT NO	AREA IN SQM	PLOT NO.	AREA IN SQM
1	1834.86	19	252.00
2	259.00	20	252.00
3	222.00	21	252.00
4	222.00	22	252.00
5	222.00	23	288.00
6	199.00	24	252.00
7	251.75	25	252.00
8	251.87	26	315.00
9	288.00	27	220.50
10	288.00	28	220.50
11	288.00	29	687.75
12	288.00		
13	288.00		
14	288.00		
15	288.00		
16	288.00		
17	288.00		
18	288.00	TOTAL =	10080.22

NOTES

LAY OUT BOUNDARY SHOWN IN ...
OPEN SPACE SHOWN IN GREEN
ALL DIMENSIONS ARE IN METERS

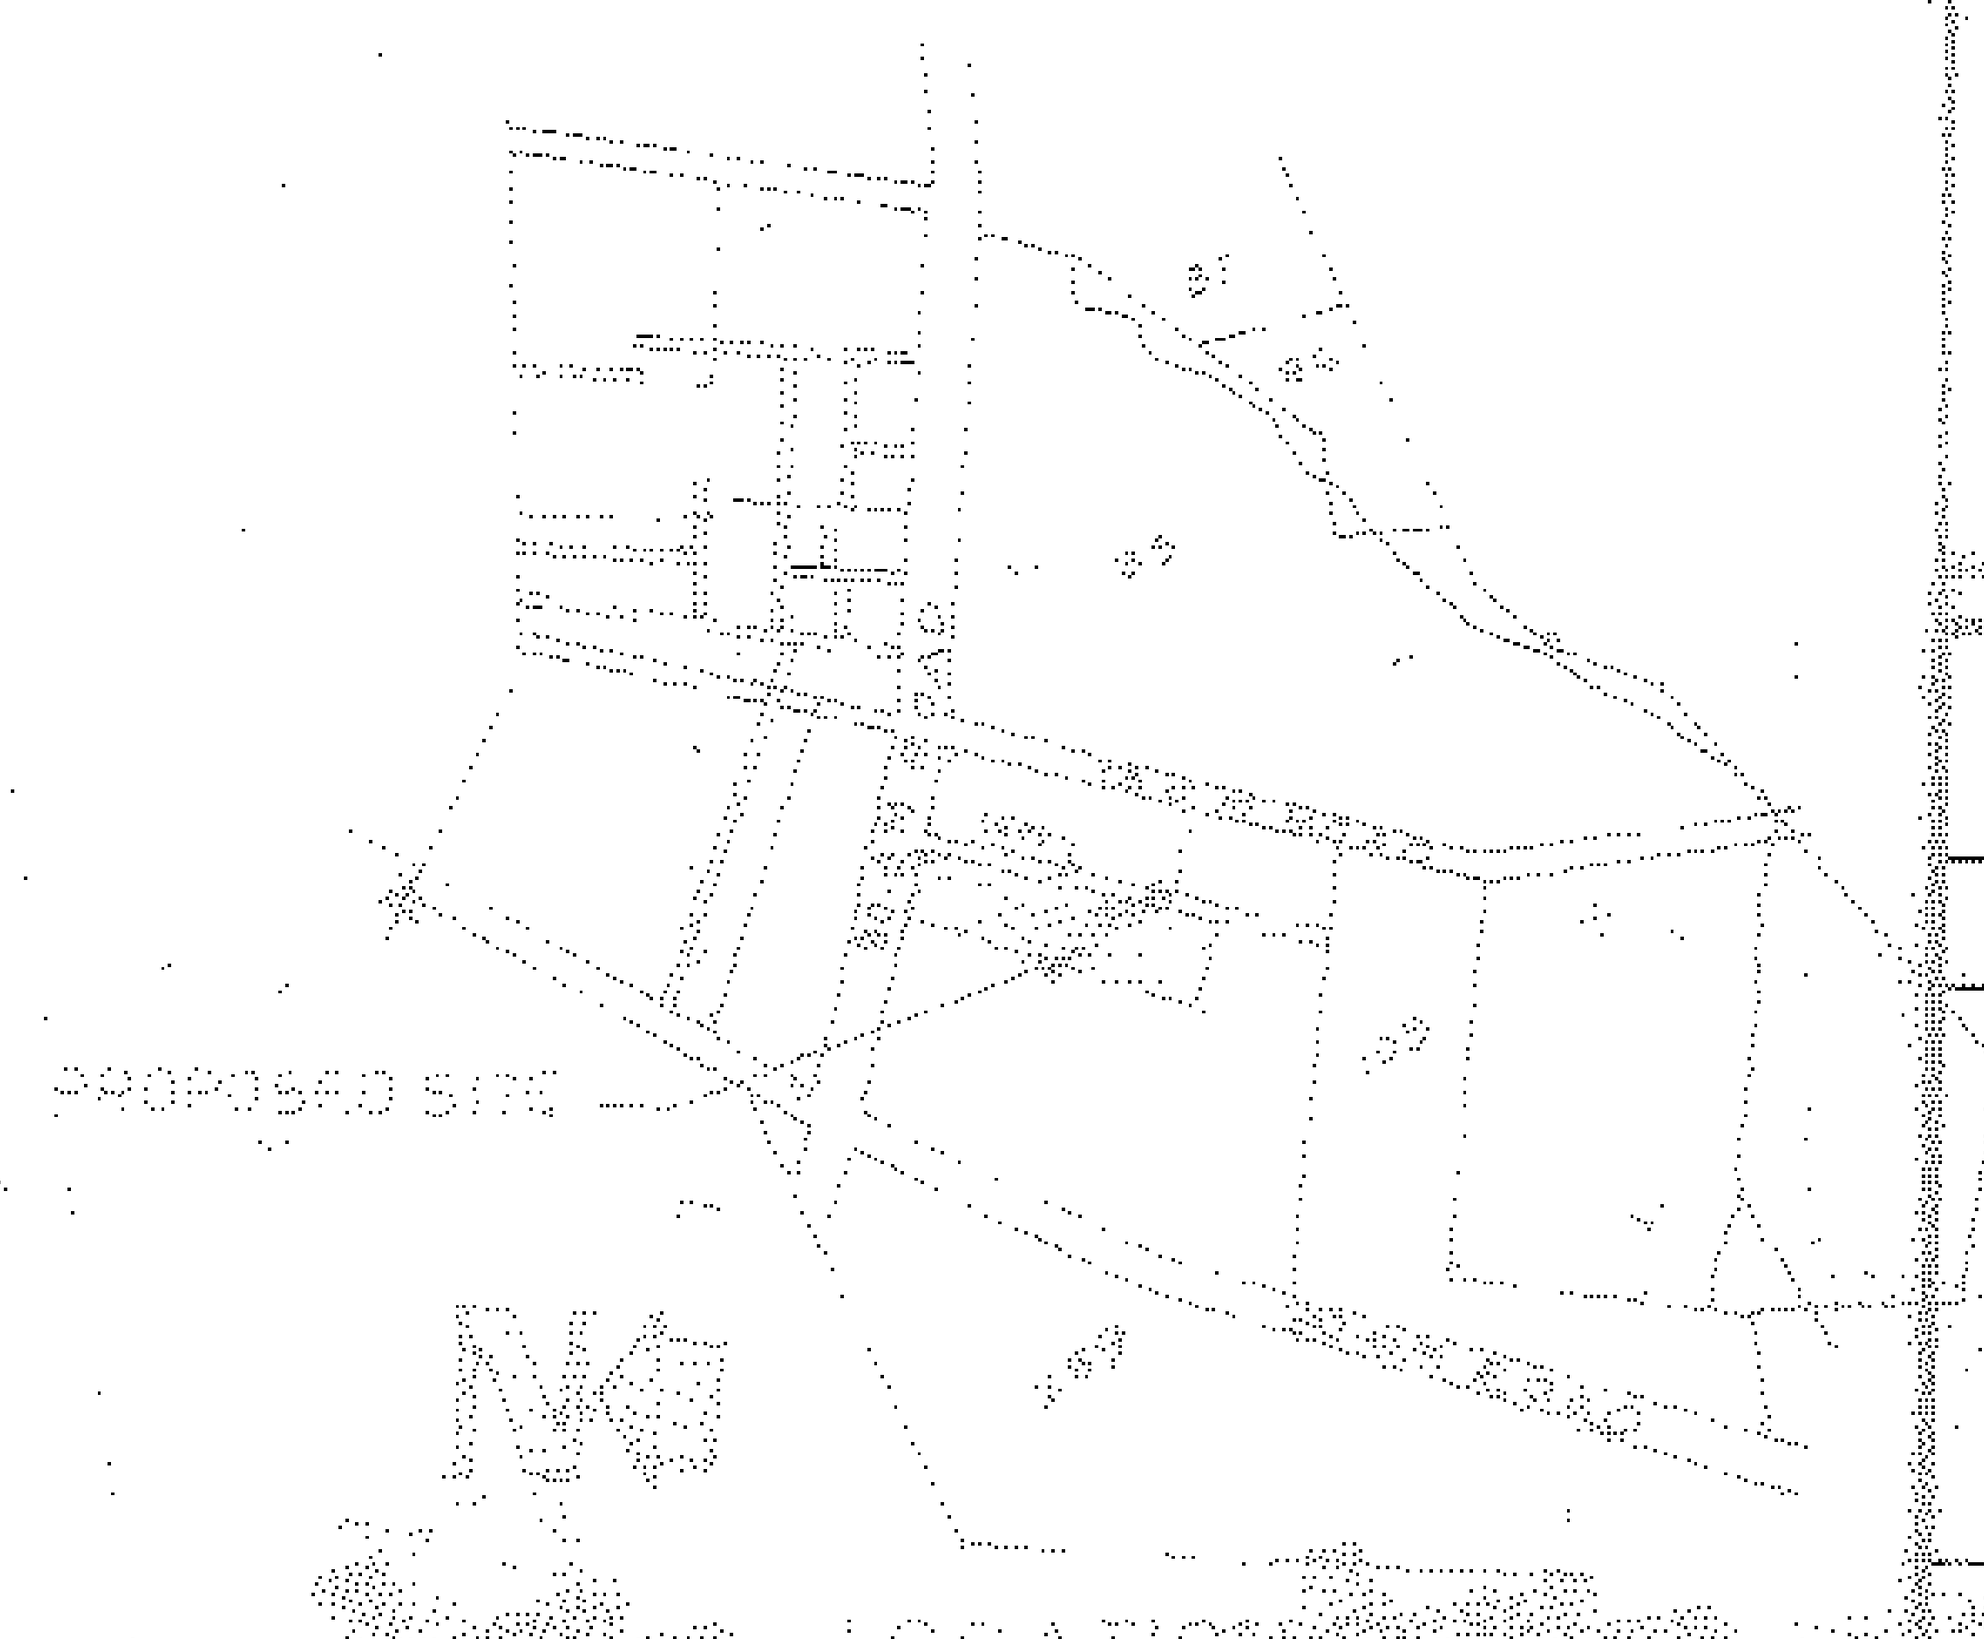

LOCATION PLAN

ARCHITECT SIGN

G. V. KATALE & ASSOCIATES

CONSULTING ENGINEERS & ARCHITECTS

JOB NO.

DRG. NO.