
DEMARKETED FINAL LAY-OUT PLAN

P.NO	AREA sqm	P.NO	AREA sqm	P.NO	AREA sqm	P.NO	AREA sqm
1	209.51	9	202.50	17	657.00	25	260.00
2	222.42	10	190.35	18	649.95	26	182.00
3	212.46	11	234.45	19	545.56	27	164.93
4	202.40	12	202.50	20	326.00	28	249.83
5	518.12	13	202.50	21	235.00	29	255.20
6	603.00	14	202.50	22	235.00	30	270.98
7	202.50	15	603.00	23	235.00	31	238.50
8	202.50	16	657.00	24	235.00	32	240.75

TOTAL= 9848.41
33 AMINITY- 696.60

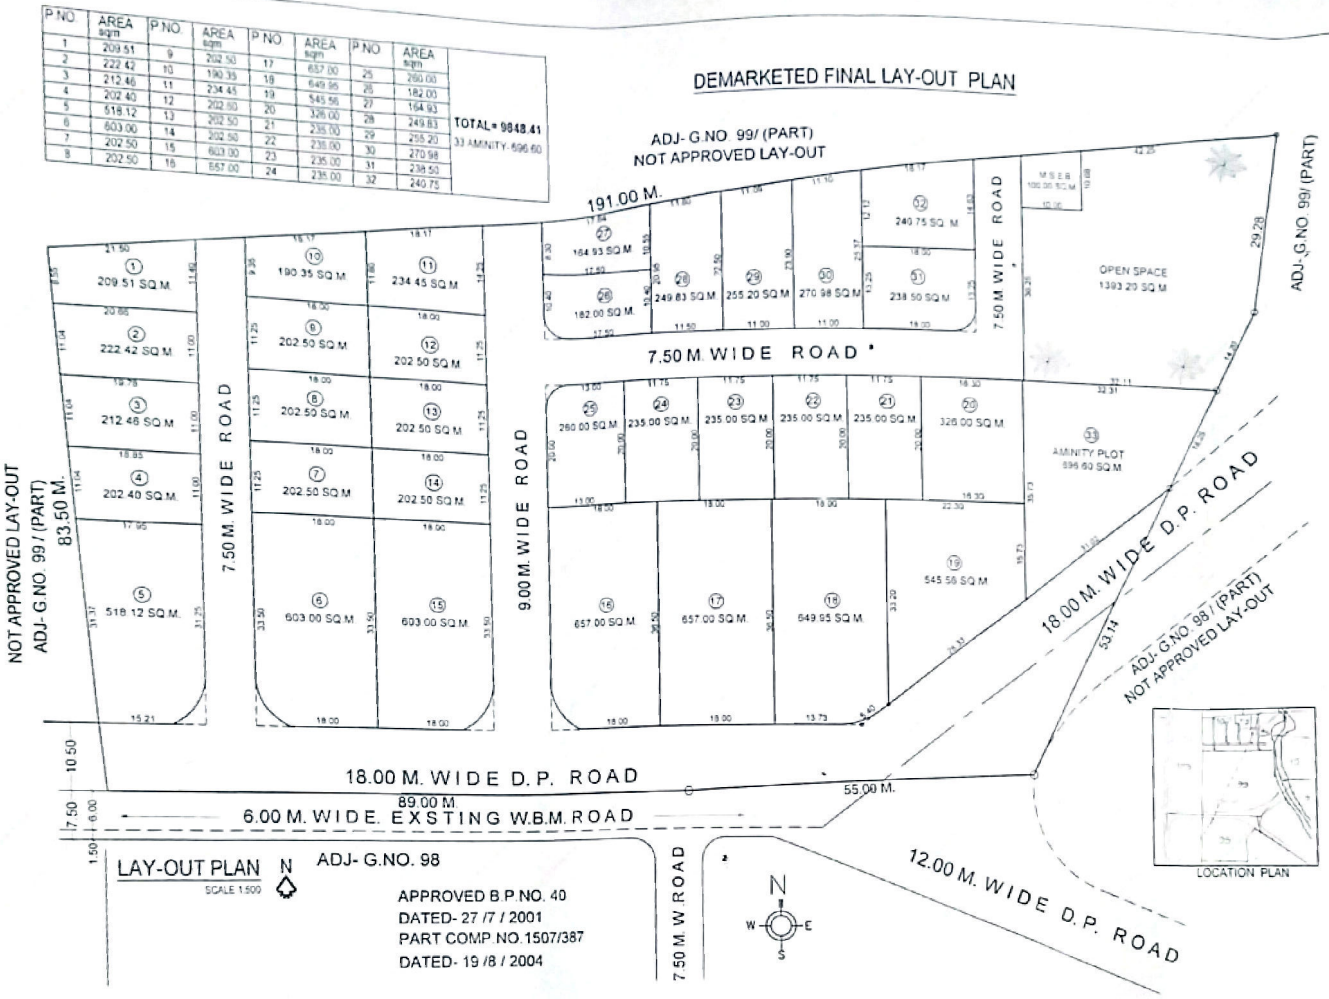

LAY-OUT PLAN N SCALE 1:500

ADJ- G.NO. 98

APPROVED B.P.NO. 40
DATED- 27 /7 / 2001
PART COMP.NO.1507/387
DATED- 19 /8 / 2004

APPROVING AUTHORITY

DEMARCATION CERTIFICATE

THIS IS TO CERTIFY THAT I HAVE PERSONALY DEMARKETED THIS LAY-OUT ON SITE WHICH WAS APPROVED TENTATIVELY BY NASHIK MUNCIPAL CORP. NASHIK VIDE LETTER NO. LND/WS/ TENT / SAT / 82 / 14 / 08 DATE - 02 / 09 / 2008 & FURTHER CERTIFY THAT MEASURMENT OF PLOTS, ROADS, OPEN SPACE ETC. SHOWN IN DEMARCATION PLAN ARE TALLIES ON SITE.

ARCHITECT SIGN

AREA STATEMENT	IN SQ.M.
AREA OF LAND AS PER 7/12	16000.00
AREA UNDER D.P. ROAD	2068.00
AREA UNDER LAYOUT	13932.00
AREA UNDER OPEN SPACE (10%)	1393.20
AREA UNDER AMINITY PLOT (5%)	696.60
AREA UNDER M.S.E.B.	100.00
AREA UNDER COLONY ROAD	1893.79
AREA UNDER PLOT	9848.41

NOTES :-1) ALL DIMENSION ARE IN METER.
2) LAY-OUT BOUNDARY SHOWN IN THICK BLACK.
3) ROAD WIDENING SHOWN IN BROWN.
4) OPEN SPACE SHOWN IN GREEN.

DEMARKETED FINAL LAYOUT PLAN
ON G.NO.99/+100 / D/ 2 (PART) AT-CHUNCHLE.
TAL & DIST NASHIK.
FOR SHRI. DILIP MOTIRAM NERE.

ARCHITECT SIGN | OWNER SIGNATURE

SIVA ASSOCIATES
Ar. Navnath Patil
REG.NO. CA/98/23014
Architects, Engineers,Interior, Designer, vastu Shastra Cconsultant/ App. Valuer
"SUYOJIT MORDEN POINT ", SHOP NO S-5/6 SECOND FLOOR
OPP. POLICE PARED GROUND , SHARANPUR ROAD, NASHIK-2
PH : 2570099

DATE	SCALE	CAD. BY	CHK.BY	DRG. NO.	JOB NO.
16/01/09	AS SHOWN	TUSHAR	N. PATIL	–	–