


LOCATION PLAN

D.P.PAGE NO.10 (SCALE 1:10,000)

PLOT AREA STATEMENT

PLOT NOS	AREA IN SQM	PLOT NOS	AREA IN SQM	PLOT NOS	AREA IN SQM
1	180.11	14	210.30	25	243.52
2	172.65	15	206.40	26	235.63
3	489.35	16	203.45	27	232.81
4	284.83	17	208.80	28	229.06
5	207.90	18	213.60	29	225.00
6	211.80	19	217.80	30	220.63
7	213.60	20	326.91	32	215.31
8	214.80	21	338.52	32	332.97
9,10,11	216.00	22	273.26		
12	213.60	23	299.20		
13	210.90	24	297.33		
			TOTAL PLOTTED AREA = 7778.04 SQM.		

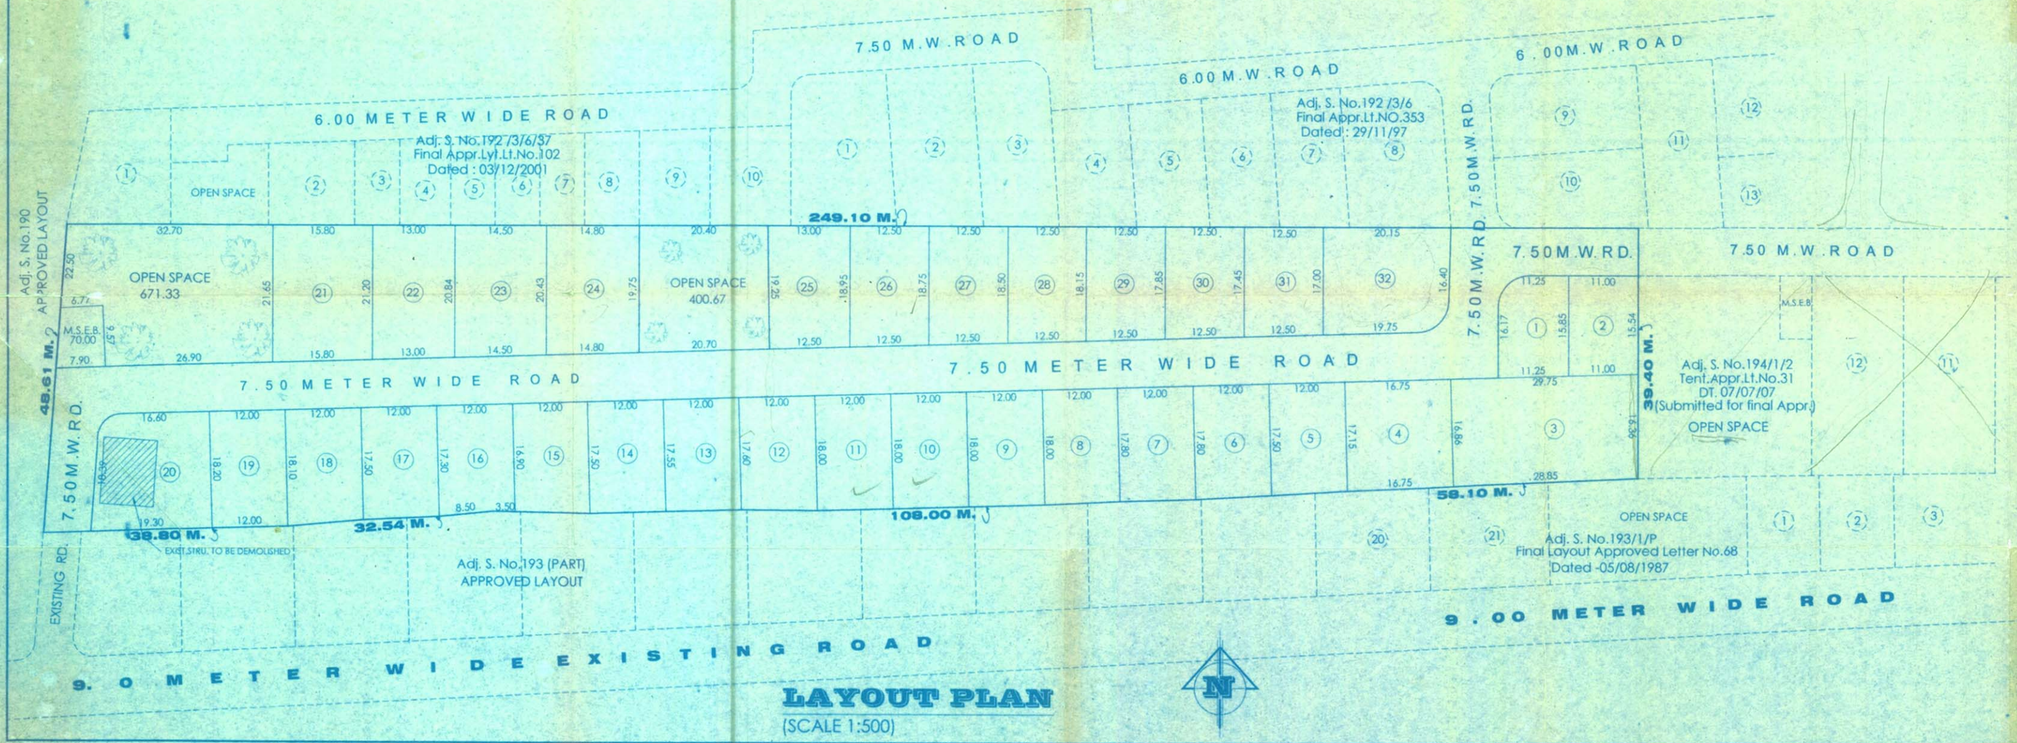

LAYOUT PLAN

(SCALE 1:500)

APPROVAL

APPROVED
(Demarketed Final) layout as per conditions mentioned in the letter No. LND/WS/98 (Panch) Date:-09/01/2008 View of Section 152 (13) and 69 of The Maharashtra Regional and Town Planing Act 1966.

TRUE COPY
(KATALE G. V.)
ARCHITECT

SD/-x-x-x
Assistant Director of Town Planing,
Nashik Municipal corporation, Nashik.

DEMARCATION CERTIFICATE

THIS IS TO CERTIFY THAT I HAVE PERSONALLY DEMARCATED THIS LAYOUT WHICH IS TENTATIVELY APPROVED BY NASHIK MUNCIPAL CORPORATION NASHIK VIDE LT. NO. 50, DT. 09/08/2007 AND FURTHER CERTIFY THAT THE MEASUREMENTS OF PLOTS, ROADS AND OPEN SPACE ETC. SHOWN IN DEMARCATION PLAN ARE ACTUALLY ON SITE.

ARCHITECT SIGN.

AREA STATEMENT

	AREA IN SQM.
1) AREA OF THE LAND (AS PER 7/12)	10,720.00
2) AREA UNDER VAHIWAT ROAD (NON-VACANT LAND)	1420.00
3) AREA UNDER RETENTION FOR DEVELOPMENT	9300.00
4) AREA UNDER OPEN SPACE	1072.00
5) AREA UNDER M.S.E.B.	70.00
6) AREA UNDER COLONY ROAD (INCLUSIVE AREA OF (2))	1799.96
7) AREA UNDER PLOTS	7778.04

NOTES :-

- ALL DIMENSIONS ARE IN METER .
- LAND BOUNDARY SHOWN IN BLACK .
- OPEN SPACE SHOWN IN GREEN .

DEMARCATED FINAL LAYOUT PLAN IN S.NO.193/A/1/2, DAMODAR NAGAR, PANCHAVATI, NASHIK SHIWAR NASHIK FOR SMT. RAJUBAI D. GITE & OTHERS 15, G.P.A.HOLDER SHRI SUDHIR S. BODKE.

AR. SHRI G. V. KATALE.	SMT. RAJUBAI D. GITE & OTHERS 15, G.P.A. HOLDER SHRI SUDHIR S. BODKE.
ARCHITECT SIGN	OWNER SIGN

G.V. KATALE AND ASSOCIATES
CONSULTING ENGINEERS & ARCHITECTS
OFFICE : 01, KAMAL RESIDENCY, PATIL LANE No. 4, NEAR POODAR HOUSE, COLLEGE ROAD, NASHIK-5.
PH.(OFF) 2580928, 2579927
Email : gv_katale@sify.com.

ACCESS KEY : D:\NASHIK\S.No.193(1)(PART)	DATE : 29 Dec. 2007	CHKD. BY- KATALE G. V.
JOB REF : AS PER P. T. SHEET.	SCALE: 1 : 500	DRN. BY- KATHALE V.