

Amrut409 / Layout Plan

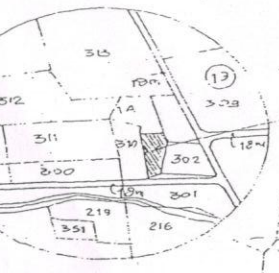

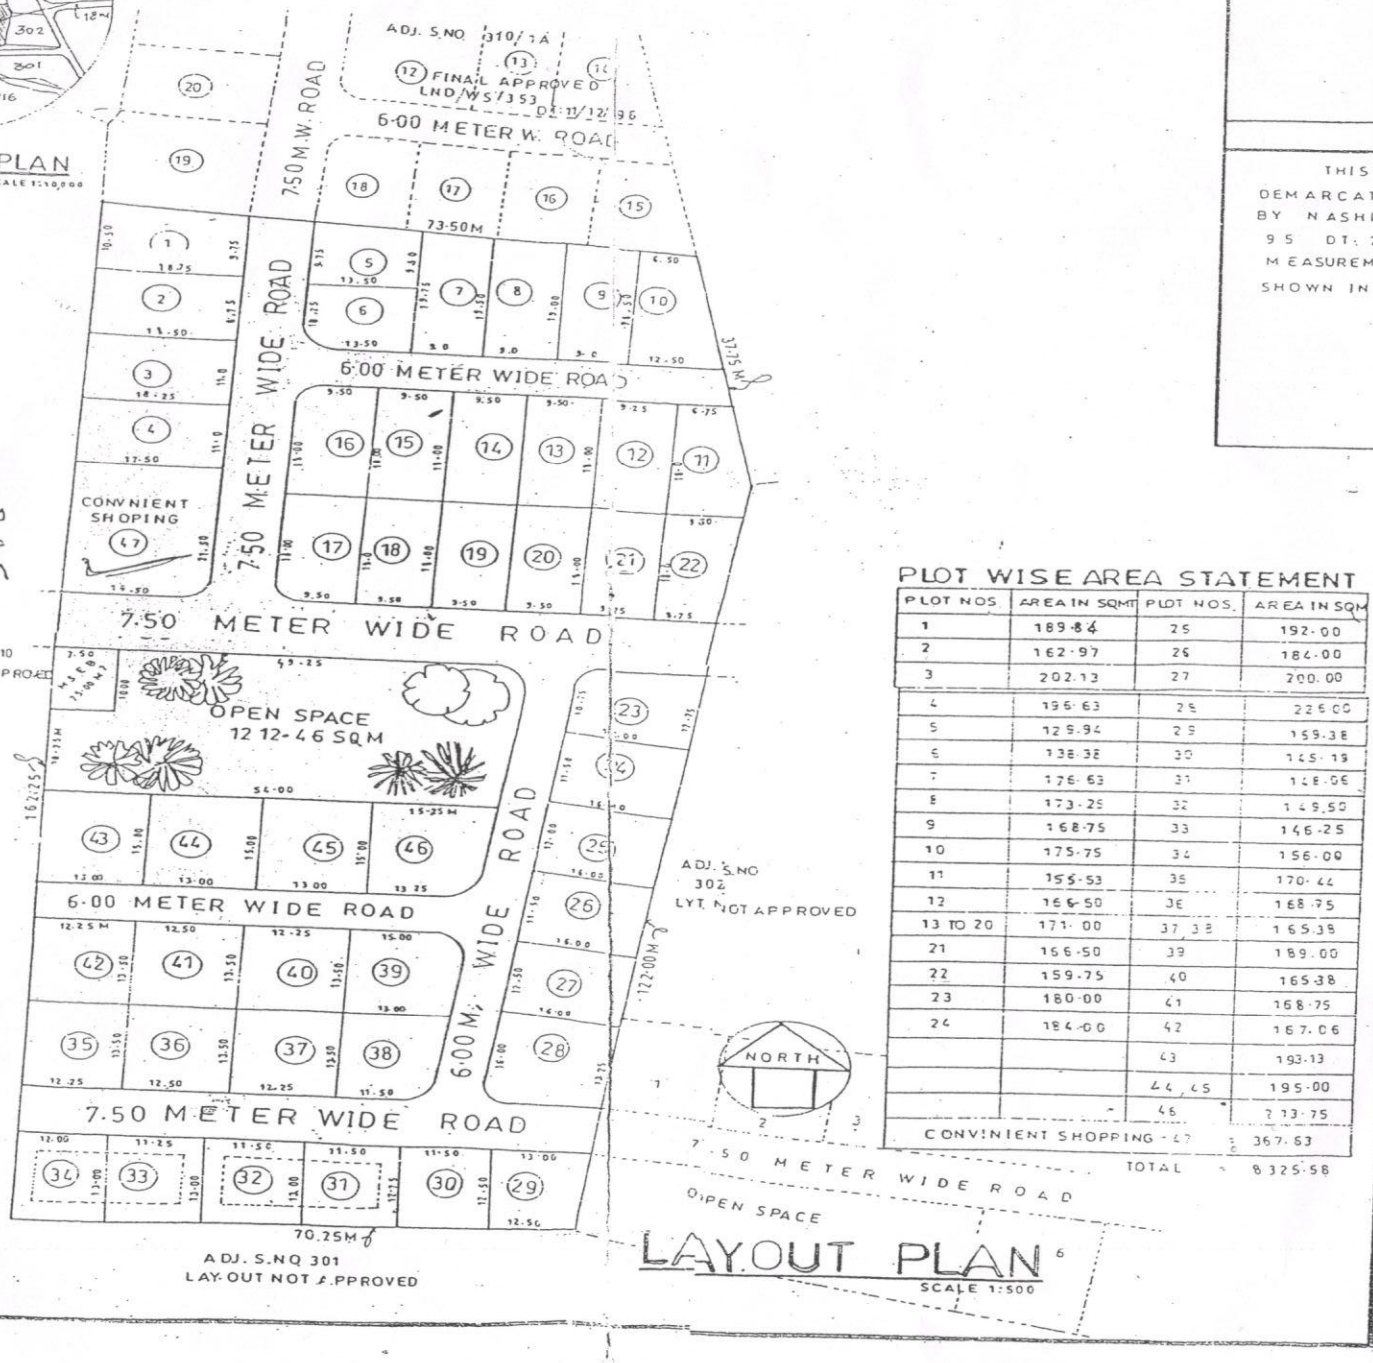

APPROVAL

APPROVED
(DEMARCATED) LAY-OUT AS PER CONDITIONS MENTIONED IN OFF. LETTER NO. LND/MS/ 297/01 : 7.10.1999 VIEW OF SECTION 111(2) AND 68 OF TOWN PLANING AND MAHARASHTRA REGIONAL & T.P. ACT, 1966.

S.D./x x x

ASSISTANT DIRECTOR OF TOWN PLANING
NASHIK MUNICIPAL CORPORATION
NASHIK

DEMARCATION CERTIFICATE

THIS IS TO CERTIFY THAT I HAVE PERSONALLY DEMARCATED THIS LAY-OUT WHICH IS TENTATIVELY APPROV BY NASHIK MUNICIPAL CORPORATION NASHIK VIDE LETTER 95 DT. 24-06-96 AND FUTHER CERTIFY THAT THE MEASUREMENTS OF PLOTS, ROADS AND OPEN SPACE SHOWN IN DEMARCATION PLAN ARE ACTUAL ON SITE

ARCHITECTS SIGN.

PLOT WISE AREA STATEMENT

PLOT NOS.	AREA IN SQMT	PLOT NOS.	AREA IN SQM
1	189-84	25	192-00
2	162-97	26	184-00
3	202.13	27	200.00
4	196-63	28	226.00
5	129-94	29	159.38
6	138.38	30	145-19
7	176-63	31	148-06
8	173-25	32	149.50
9	168-75	33	146-25
10	175-75	34	156-00
11	155-53	35	170-44
12	166-50	36	168-75
13 TO 20	171-00	37, 38	165.38
21	156-50	39	189-00
22	159-75	40	165.38
23	180-00	41	168-75
24	184-00	42	167.06
		43	193.13
		44, 45	195-00
		46	213-75
CONVINIENT SHOPPING - 47		TOTAL	367.63
			8325.58

AREA STATEMENT

	AREA IN SQ
TOTAL AREA OF S.NO 310/1A	20100-00
AREA UNDER APT. LAY-OUT	8000-00
AREA UNDER DEVELOPMENT	12,100-00
AREA UNDER OPEN SPACE	1212-46
AREA UNDER M.S.E.B.	75-00
AREA UNDER ROADS	2486-96
AREA UNDER PLOTS	8325-58

NOTES

ALL DIMENTIONS ARE IN METER.
LAND BOUNDARI SHOWN IN BLACK.
OPEN SPACE SHOWN IN GREEN

DEMARCATED FINAL LAY-OUT PLAN IN S.NO. 310/1A AT: PATHARDI, TAL DIST- NASHIK FOR- SHRI SITARAM KRISHNAJI NAWALE

SHRI. G.V. KATALE

ARCHITECT SIGN | OWNER'S SIGN.

G.V. KATALE & ASSOCIATES
CONSULTING ENGINEERS & ARCHITECTS
108, SHRIRAM SANKUL, OPP. HOTEL PANCHWATI, VAKILWADI, NASHIK 422 00 ☎ 40978

JOB NO.	DATE: 3-03-96	CHEDBY. G.V.K.
DRG NO.	SCALE: 1:100	DRN BY. KOLHE