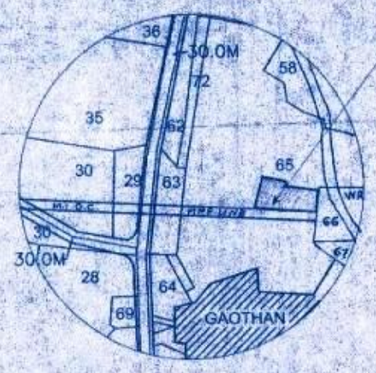



LOCATION PLAN
SCALE 1:10,000

PLOT WISE AREA STATEMENT

PLOT NOs.	AREA IN SQ.M.
1	244.00
2 to 8	200.00
9	204.00
10	228.00
11	349.46
12	284.70
13	280.48
14	184.00
15	155.20
16,17,18	184.60
19	248.86
TOTAL	4132.50

TRUE COPY

(KAUSHAL G. KATALE)
Architect

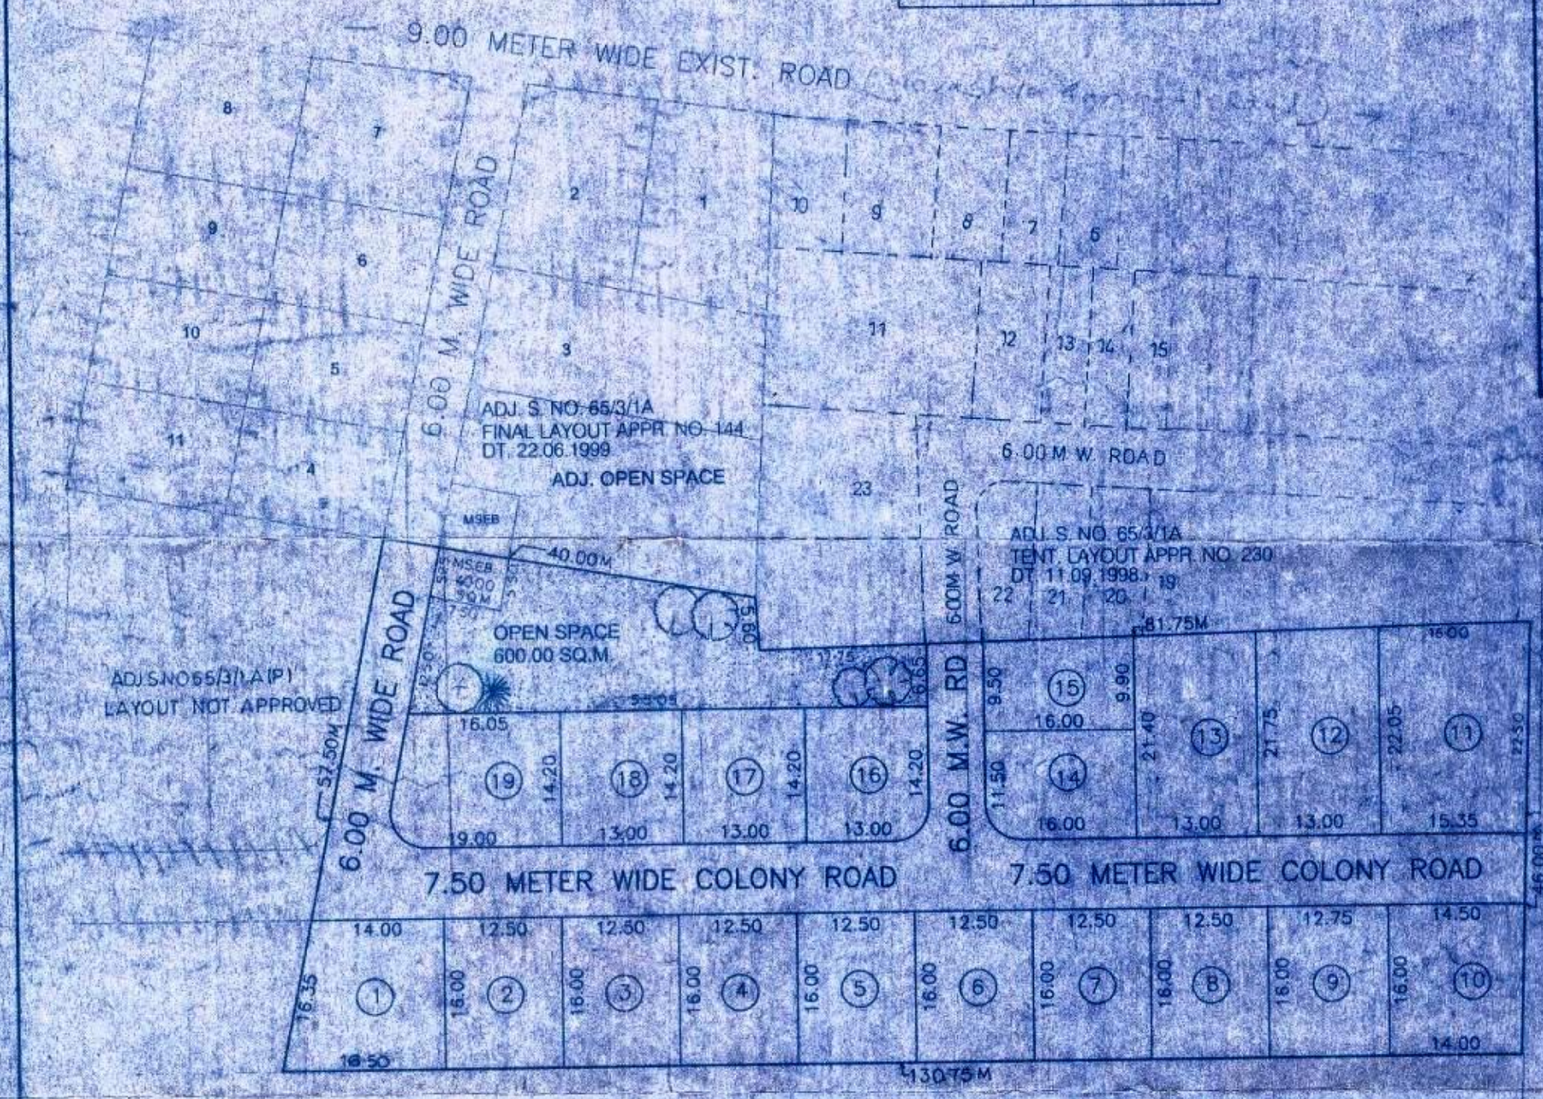

APPROVAL

APPROVED
(DEMARKATED FINAL) LAYOUT AS PER CONDITIONS MENTIONED THE LETTER NO. LND/W5/21 DT. 14/10/2003 (SATPUR) VIEW OF SECTION 152 (1) AND 69 OF THE MAHARASHTRA REGIONAL AND TOWN PLANING ACT 1966

SD/- X. X. X.

ASSISTANT DIRECTOR OF TOWN PLANING
NASHIK MUNICIPAL CORPORATION
NASHIK

DEMARKATION CERTIFICATE

THIS IS TO CERTIFY THAT I HAVE PERSONALLY DEMARKETED THIS LAYOUT WHICH IS TENTATIVELLY APPROVED BY NASHIK MUNICIPAL CORPORATION, NASHIK VIDE LETTER NO. TPD-58 DT. 29.03.2003 (SATPUR) AND FUTHER CERTIFY THAT THE MESUREMENT OF PLOTS, ROAD AND OPENSPACE ETC. SHOWN IN DEMARKATION PLAN ARE ACTUALLY ON SITE.

ARCHITECT SIGN

AREA STATEMENT

	AREA IN SQ.M.
AREA OF THE LAND (AS PER 7/12)	10,700.00
AREA UNDER LAY-OUT	6000.00
AREA UNDER OPEN SPACE	600.00
AREA UNDER M.S.E.B.	240.00
AREA UNDER ROAD	1228.50
AREA UNDER PLOTS	4132.50

NOTES

* ALL DIMENSION ARE IN METER.
* LAND BOUNDARY SHOWN IN BLACK.
* OPEN SPACE SHOWN IN GREEN.

DEMARKATED "FINAL" LAYOUT PLAN IN S. NO. 65/3/1A(PART) AT.- ANANDWALLI TAL & DIST. NASHIK.. FOR,
SHRI. KASHINATH B. JADHAV. & OTHERS.
G.P.A. HOLDER SHRI. DEEPAK R. BAGAD.

SHRI G. V. KATALE | G.P.A. HOLDER SHRI. DEEPAK R. BAGAD.

G. V. KATALE AND ASSOCIATES
CONSULTING ENGINEERS & ARCHITECTS
OFF: 108, "SHRIRAM SANKUL",
OPP. HOTEL PANCHAVATI, WAKIL-WADI,
NASHIK-1 PH.(OFF.) 2580928, 2579927

JOB NO.	DATE- 11.03.2003	CKD. BY- KATALE G. V.
DRG. NO.	SCALE- 1:500	DRN. BY-