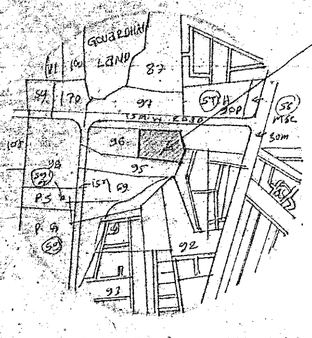

LOCATION PLAN

SCALE :- 1:10000

PLOT WISE AREA STATEMENT

PLOT NOS	AREA IN M²	PLOT NOS	AREA IN M²
1	277·50	13	189·00
2	272·81	14, 15	210·00
3	217·50	16	189·00
4, 5	202·50	17, 18	216·00
6	202·50	19	189·00
7	238·30	20, 21	210·00
8	243·75	22	189·00
9	237·94	23	216·00
10	221·00	24	183·00
11	226·50	25	163·50
12	216·00	26	267·38

TOTAL — 5616·68 SQMT

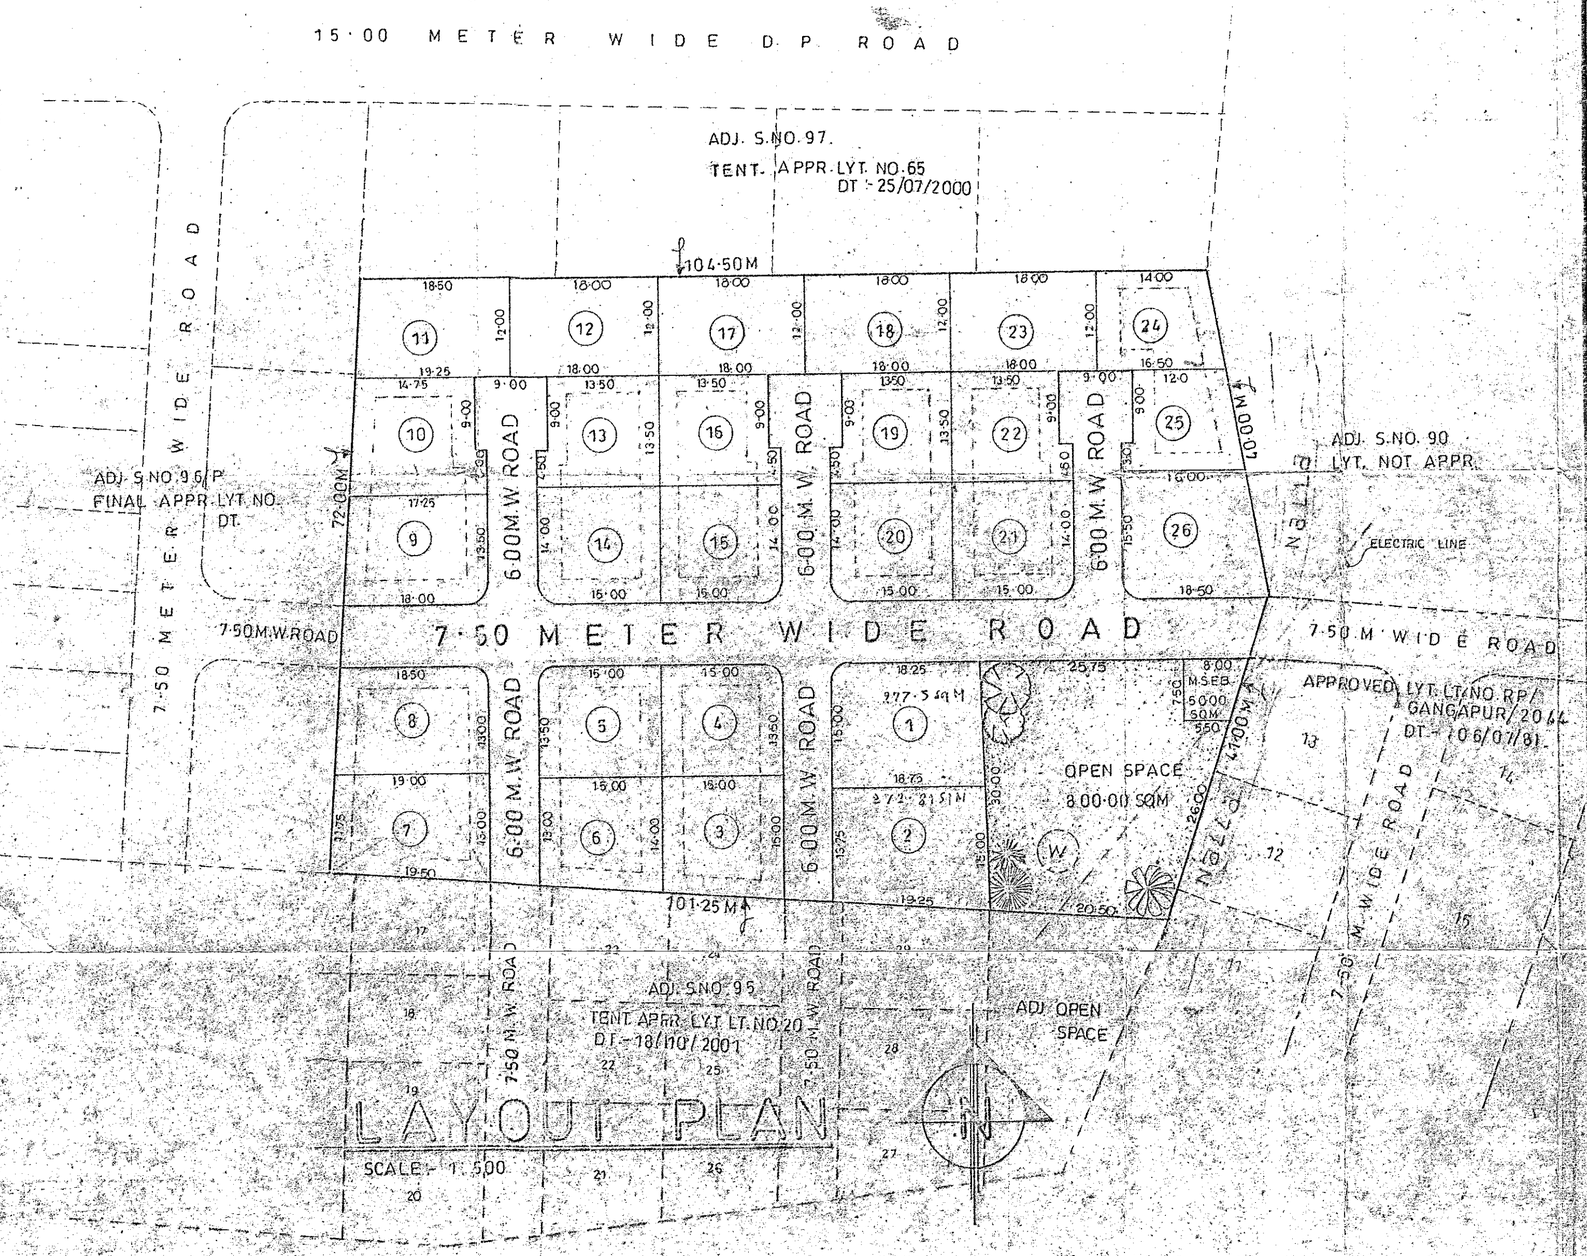

APPROVAL

APPROVED
DEMARKATED FINAL LAYOUT AS PER CONDITION MENTIONED IN THE LETTER NO. LND/WS/6 DT. 10.06.2003 (SATPUR) VIEW OF SECTION 15 (1) AND (69) OF THE MAHARASTRA REGIONAL AND TOWN PLANNING ACT 1966

TRUE COPY

SD/-

(KATALE G. V.)
ARCHITECT

ASSISTANT DIRECTOR OF TOWN PLANNING, NASHIK MUNICIPAL CORPORATION, NASHIK

DEMARKATION CERTIFICATE

This is to Certify that I have personally Demarketed this Layout which is tentatively approved By Nashik Municipal Corporation Nashik Vide Letter No. 77, Dt. 31/07/2000 and Further Certify that the measurements of Plots, Roads and open Space etc. shown in Demarkation Plan are Actually on site

Architects Sign

AREA STATEMENT

AREA IN SQMT

- AREA OF THE LAND — 8000·00
- AREA UNDER OPEN SPACE — 800·00
- AREA UNDER M.S.E.B — 50·00
- AREA UNDER ROADS — 1533·92
- AREA UNDER PLOTS — 5616·68

NOTES

- ALL DIMENSIONS ARE IN METER
- LAND BOUNDARY SHOWN IN BLACK
- OPEN SPACE SHOWN IN GREEN

DEMARKETED FINAL LAYOUT PLAN IN S.NO 96/3 AT - GANGAPUR, NASHIK. FOR - SHRI VISHWAS G. KAJALE AND OTHERS

SHRI G.V. KATALE	SHRI VISHWAS G. KAJALE
ARCHITECT SIGN.	OWNER SIGN.

G. V. KATALE & ASSOCIATES
CONSULTING ENGINEERS & ARCHITECTS
OFF :- 103, 105, SHRIRAM SANKUL,
OPP. HOTEL PANCHAVATI, VAKIL WADI,
NASHIK-1. PH. (OFF.) 580328, 579927

JOB NO. -	DATE - 02, JAN. 2001	CKD. BY - KATALE G. V.
DRG NO. -	SCALE - AS SHOWN	DRN. BY - BHAGWAN