


LOCATION PLAN
(SCALE 1:10.000)

PLOT AREA STATEMENT

PLOT NOS.	AREA IN SQM
1	351.33
2	355.00
3	158.33
4	168.35
5	248.88
6	250.56
7	210.00
8 TO 10	200.00
11	188.00
TOTAL PLOT AREA= 2530.45	

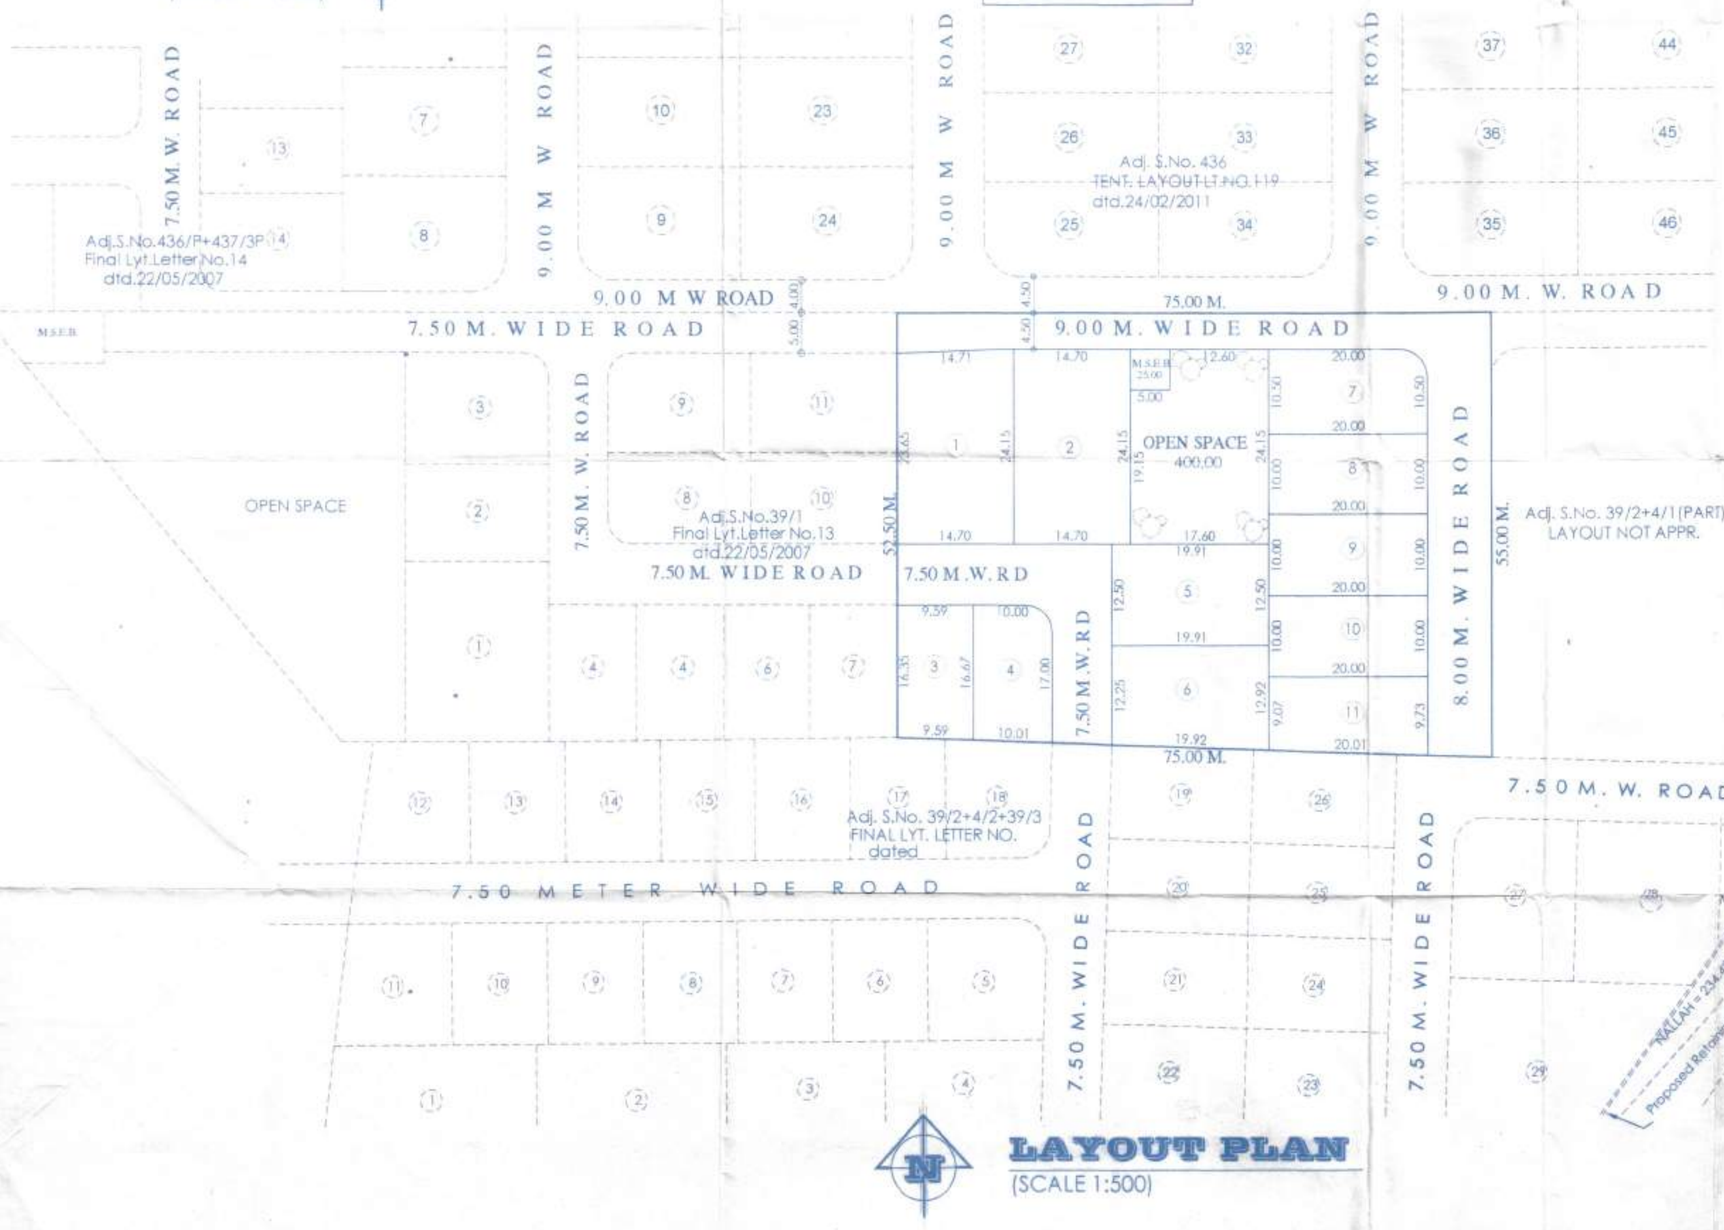

LAYOUT PLAN
(SCALE 1:500)

APPROVAL

APPROVED

(Demarketed Final) Layout as per Conditions mentioned in the letter no. LND/WS/Panch./122 dtd. 01/03/2011. View of Section 152(13) and 69 of The Maharashtra Regional and Town Planning Act, 1966.

TRUE COPY

SD/-X-X-X
(KATALE G. V.) ARCHITECT
Assitant Director of Town Planning
Nashik Municipal Corporation
Nashik.

DEMARCATION CERTIFICATE

THIS IS TO CERTIFY THAT I HAVE PERSONALLY DEMARCATED THIS LAYOUT WHICH IS TENTATIVELY APPROVED BY NASHIK MUNCIPAL CORPORATION NASHIK VIDE LT. NO.74 (PANCH).DT.29/10/2010 AND FURTHER CERTIFY THAT THE MEASUREMENTS OF PLOTS, ROADS AND OPEN SPACE ETC. SHOWN IN DEMARCATION PLAN ARE ACTUALLY ON SITE.

ARCHITECT SIGN.

AREA STATEMENT

	AREA IN SQM.
1) AREA OF THE LAND AS PER 7/12	7800.00
2) AREA UNDER DEVELOPMENT(LAY OUT)	4000.00
3) AREA UNDER OPEN SPACE	400.00
4) AREA UNDER M.S.E.B.	25.00
5) AREA UNDER COLONY ROAD	1044.55
6) AREA UNDER PLOTS	2530.45

NOTES :-

- ALL DIMENSIONS ARE IN METER .
- LAND BOUNDARY SHOWN IN BLACK .
- OPEN SPACE SHOWN IN GREEN .
- REF: TENT.APPR.LYT.LT.NO.PANCH./74,DATE:29/10/2010

DEMARCATED FINAL LAYOUT PLAN IN S. No.39/2+4/1(PART) OF MAKHAMALABAD SHIWAR IN NASHIK FOR SHRI.SHASHIKANT SHIVCHAND PARAKH & OTHERS-2

	SHRI.SHASHIKANT SHIVCHAND PARAKH
	SHRI.VISHAL KANTILAL JAIN
AR. SHRI G. V. KATALE. ARCHITECT SIGN	SHRI.RAJESH POPATLAL JAIN OWNER SIGN.

G.V. KATALE AND ASSOCIATES
CONSULTING ENGINEERS & ARCHITECTS
OFFICE : 01,"KAMAL RESIDENCY",
PATIL LANE No. 4, COLLEGE ROAD,
NASHIK -5 PH. :(OFF.) 2579927, 2580928.
Email : gv_katale @ sify.com.

JOB REF : D:\M.BAD\S.NO.39	DATE - 07 Feb. 2011	CKD. BY - KATALE G. V.
ORG. NO.: AS PER P.T.SHEET	SCALE: 1 : 500	DRN. BY - NavVaLatPE