




LOCATION PLAN
(SCALE 1:10000)

PLOT AREA STATEMENT

PLOT NOS	AREA IN SQM	PLOT NOS	AREA IN SQM	PLOT NOS	AREA IN SQM
1	1000.00	17	406.26	27	951.00
2	1071.22	18	366.00	28	486.60
3	954.04	19	366.25	29	478.51
4	860.01	20	349.06	30	408.70
5	169.20	21	257.52	31	549.53
6 to 8	237.93	22	274.68	32	848.38
9	676.80	23	274.68	33	1406.02
10 to 14	563.76	24	271.03		
15	274.50	25	382.59		
16	314.76	26	366.25		
				TOTAL	17286.70

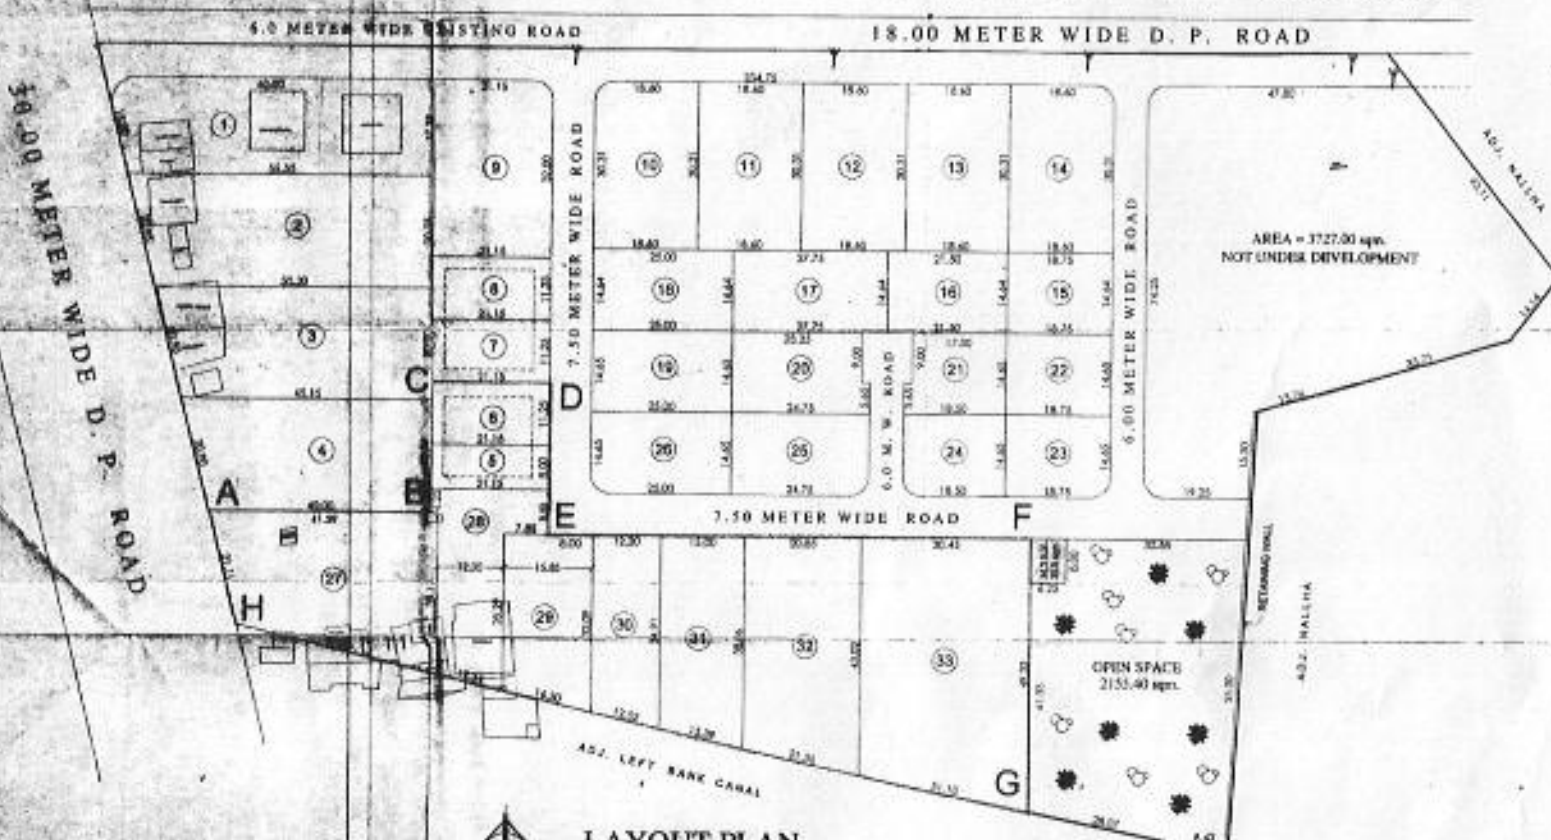

LAYOUT PLAN
(SCALE 1:500)

APPROVAL

APPROVED
(Detailed Final) Layout as per
Conditions mentioned in the letter
No. LMD/P/1554/13/24/14
Dated 15.12.13 and 09
of The Maharashtra Regional and
Town Planning Act 1966

Assistant Director of Town Planning
TOWN PLANNING

DEMARCATORY CERTIFICATE

THIS IS TO CERTIFY THAT I HAVE PERSONALLY VERIFIED
THE DEMARCATORY LAYOUT WHICH IS TENTATIVELY
APPROVED BY NASHIK MUNICIPAL CORPORATION,
NASHIK (VITE/LETTER No. LND/MSH/6/parish.)
DATED - 17/08/2000 AND FURTHER CERTIFY THAT THE
MEASUREMENTS OF PLOTS, ROADS AND OPEN SPACE
ETC. SHOWN IN DEMARCATORY PLAN ARE ACTUALLY
ON SITE.

ENGINEER'S SIGN

- NOTES :-
- ALL DIMENSIONS ARE IN METRE.
 - LAND BOUNDARY SHOWN IN BLACK.
 - OPEN SPACE SHOWN IN GREEN.
 - PREVIOUSLY TENTATIVELY APPROVED LAYOUT LETTER
No. LND/MSH/6/parish.) DATED - 17/08/2000
 - BLOCK (A+B+C+D+E+F+G+H) & PROPOSED REVISD
TENTATIVELY LAYOUT

AREA STATEMENT

AREA IN SQM.

1) AREA OF THE LAND AS PER 7/12	26681.00
2) AREA UNDER DEVELOPMENT	3727.00
3) AREA UNDER LAYOUT	22954.00
4) AREA UNDER D.P. ROAD	1400.00
5) NET AREA UNDER DEVELOPMENT	21554.00
6) AREA UNDER OPEN SPACE	2155.40
7) AREA UNDER M.S.E.B.	50.00
8) AREA UNDER ROAD	2061.50
9) AREA UNDER PLOTS	17286.70

PARTLY DEMARCATORY FINAL & PARTLY
REVISED TENTATIVELY LAYOUT PLAN IN
S.NO. 69/1+2(PART) +3 OF NASHIK
SHWAR IN NASHIK.

FOR
CHAIRMAN, SAI AVDHOOT CO.OP.SOC.

[Signature]

[Signature]

18-08-2014
S.A.O. SAI

CHAIRMAN, SAI AVDHOOT CO.OP.SOC.
OTHER SIGN

THAKKERS

1, THAKKARS
NEAR NASHIK GARDEN
NASHIK-422001
PH: 986438, 986435

