PRODUCED BY AN AUTODESK EDUCATIONAL PRODUCT

DATE AND STAMP OF APPROVAL

बांधकाम नकाशे मंजूरी ~~सशर्त~~
रंगाने दुरुस्ती दाखविल्याप्रमाणे व बांधकाम प्रारंभ
प्रमाणपत्र क्र. कडोंमपा / नरवि / बां.प्र / कवि- ~~अ~~ / 2092-22 | 206 | 88
दिनांक 07/04/2022
दिलेल्या अटिप्रमाणे.

KALYAN DOMBIVALI MUNICIPAL CORPORATION
कल्याण डोंबिवली महानगरपालिका
Dist. Thane

नगर रचनाकार
कल्याण डोंबिवली महानगरपालिका

PARKING AREA STATEMENT

TYPE OF BLDGS	TOTAL FLATS	TOTAL SHOP	REQUIRED CAR PARKING: NOS OF FLATS BELOW 35.00 SQ.M. (NO PARKING)	NOS OF FLATS ABOVE 35.0 SQ.M. (1 PARKING EVERY 4 FLATS)	NOS OF FLATS ABOVE 45.0 SQ.M. (1 PARKING EVERY 2 FLATS)	REQUIRED PARKING CAR	PARKING PROPOSED CAR
A	32	-	17	7	8	8	8
B	32	-	24	7	--	2	3
C	38	--	31	7	--	2	3
D	88	12	60	24	--	9	24
						TOTAL =	24 NO'S

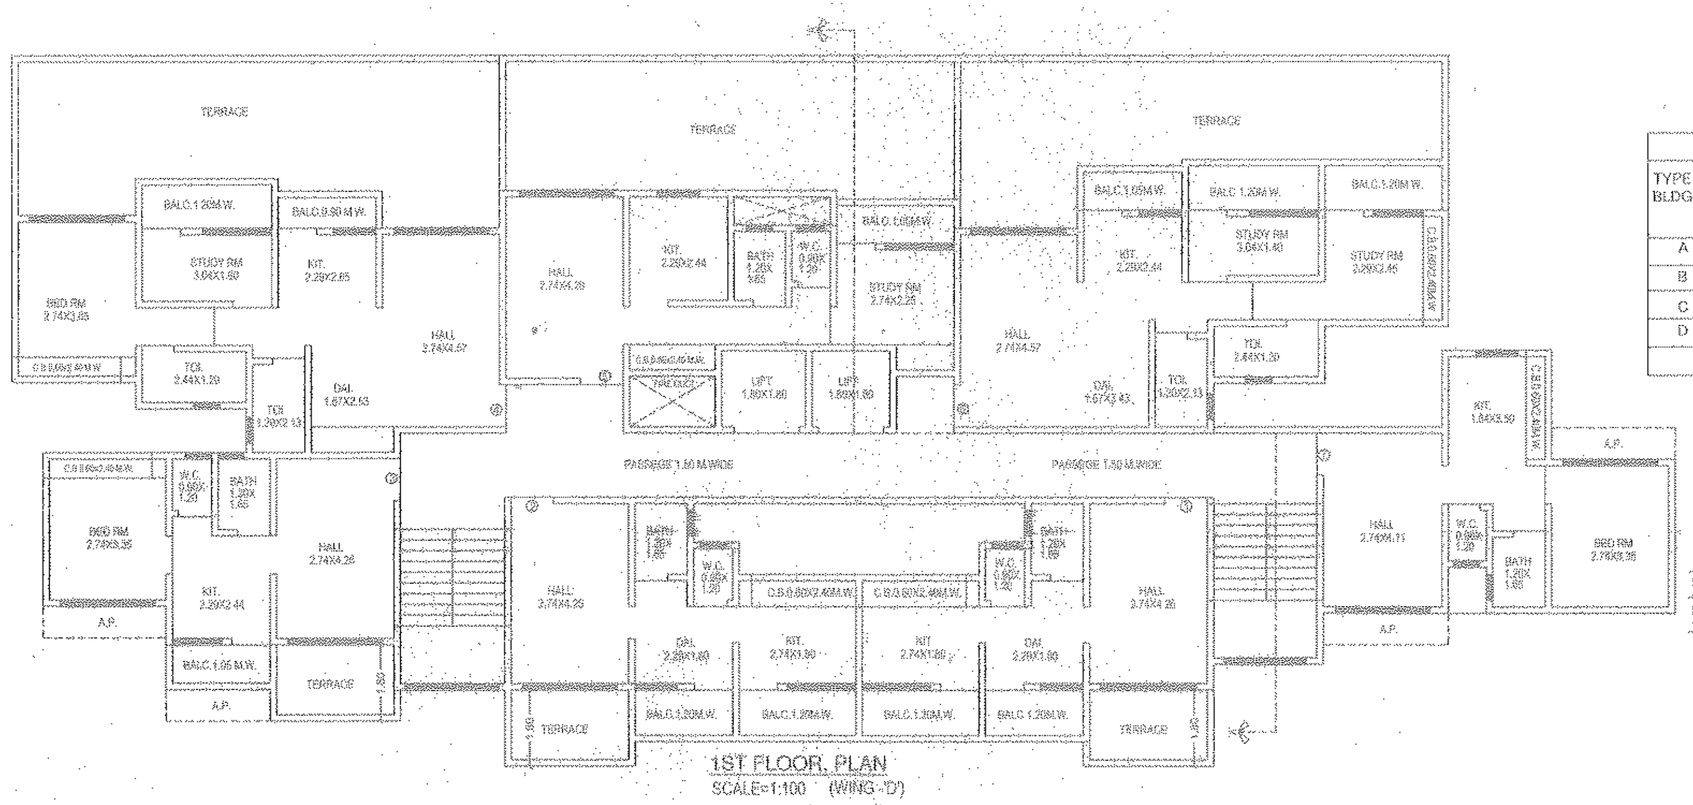

1ST FLOOR PLAN
SCALE=1:100 (WING -'D')

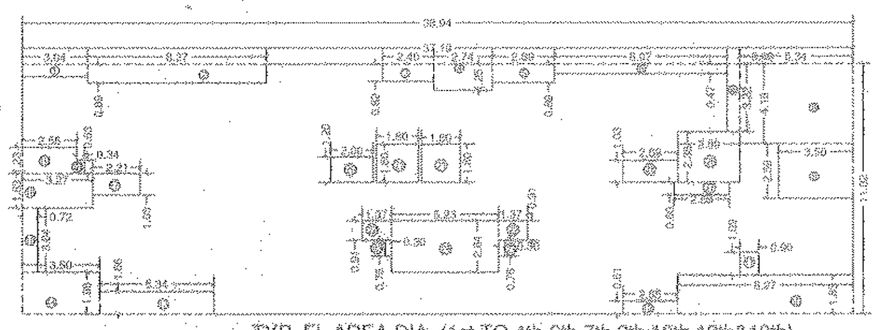

TYP. FL.AREA DIA. (1st TO 4th,6th,7th,9th,10th,12th&13th)
SCALE 1 : 200 (WING -'D')

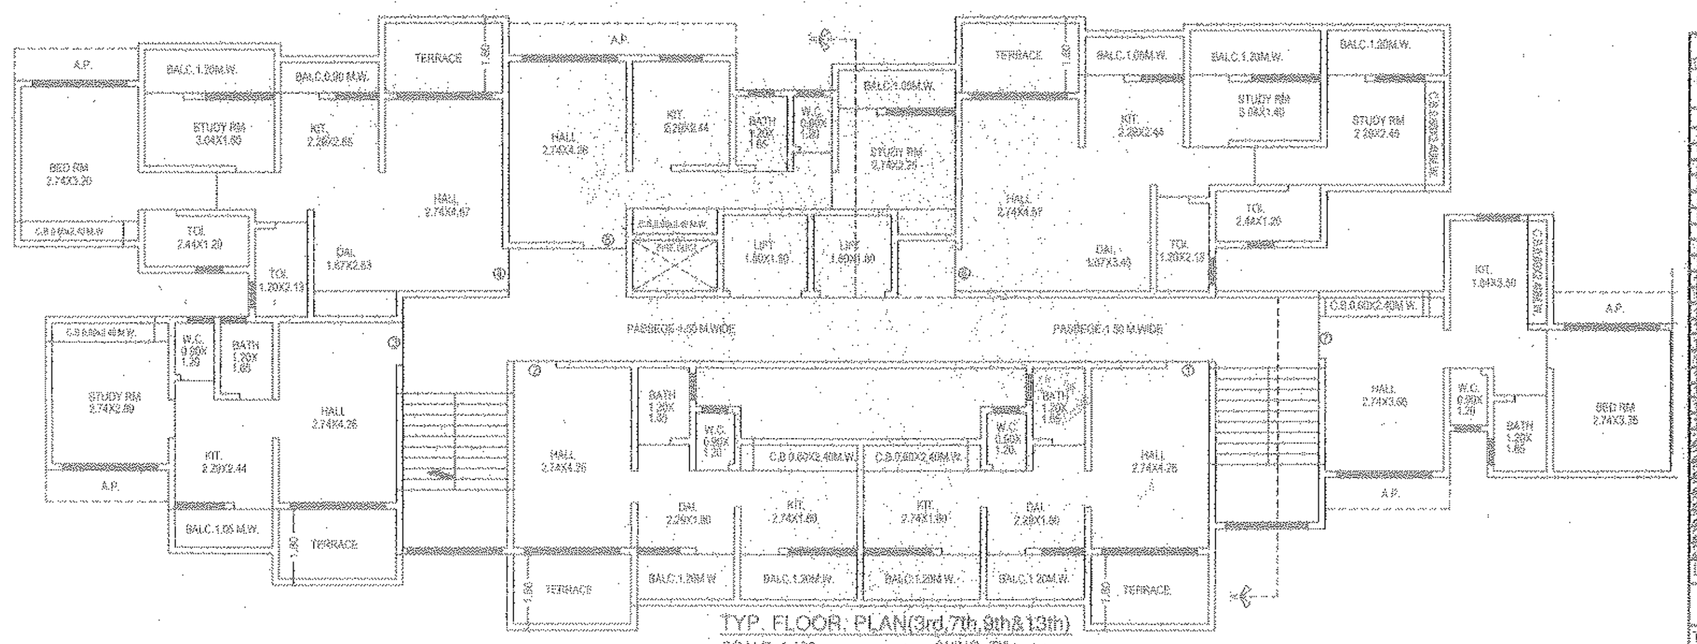

TYP. FLOOR PLAN(3rd,7th,9th&13th)
SCALE=1:100 (WING -'D')

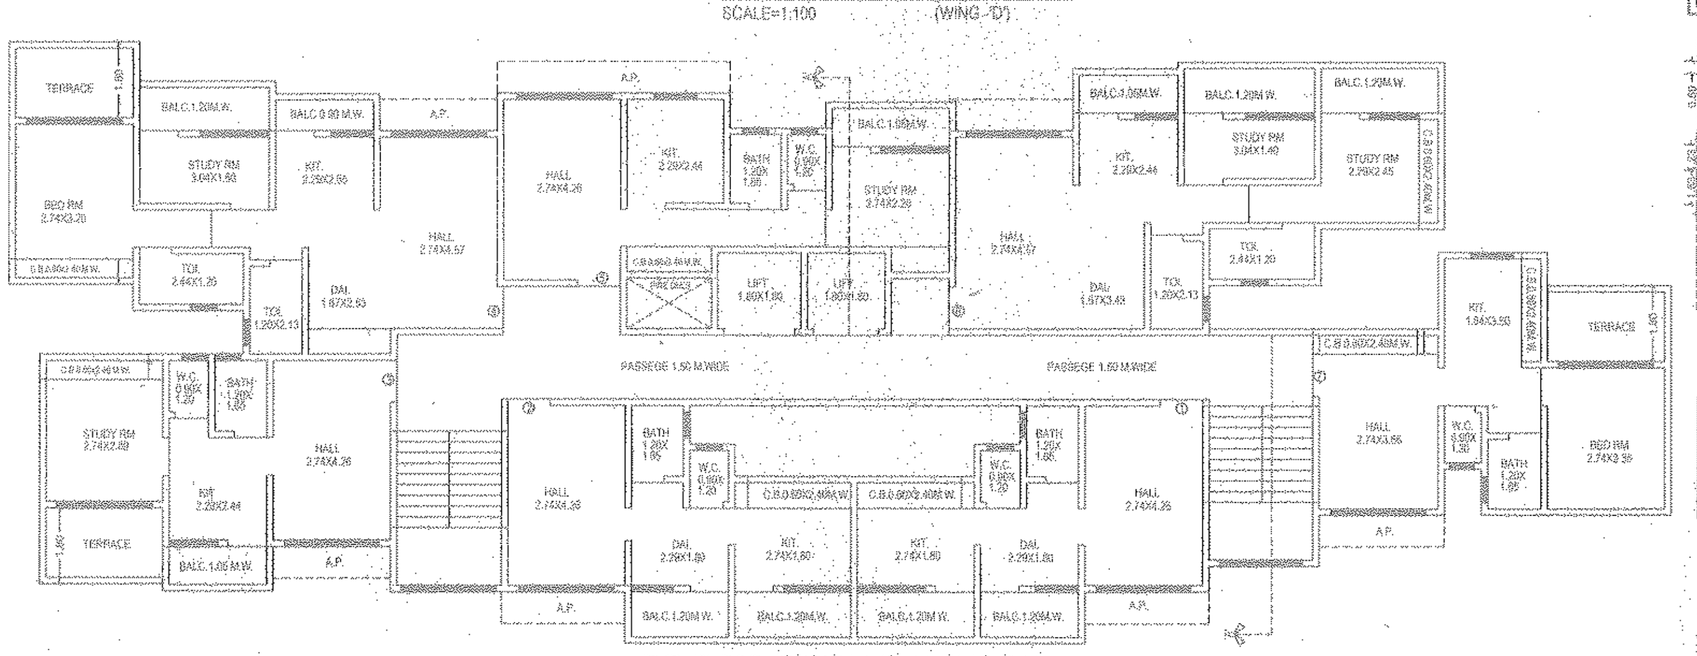

TYP. FLOOR PLAN(2nd,4th,6th,10th&12th)
SCALE=1:100 (WING -'D')

BUP AREA CALCULATION
TYP. FL.AREA DIA.(1ST TO 4TH,6TH,7TH,9TH,10TH,12TH&13TH) (WING - 'D')

37.19X11.02 =409.83 SQ.M.

DEDUCTIONS :-

1	3.04 X 0.99	=	3.01
2	8.37 X 0.90	=	7.53
3	2.29 X 0.62	=	1.42
4	2.74 X 1.23	=	3.37
5	2.99 X 0.86	=	2.57
6	8.07 X 0.47	=	3.79
7	5.60 X 3.25	=	1.93
8	5.34 X 4.35	=	23.23
9	3.65 X 2.59	=	9.06
10	8.27 X 1.83	=	15.13
11	0.90 X 1.00	=	0.90
12	2.65 X 0.61	=	1.62
13	5.34 X 1.05	=	5.60
14	3.60 X 1.96	=	7.12
15	0.72 X 3.04	=	2.18
16	3.27 X 1.63	=	5.33
17	2.41 X 1.03	=	2.27
18	0.34 X 0.63	=	0.21
19	2.55 X 1.23	=	3.13
20	2.00 X 1.20	=	2.40
21	1.80 X 1.80X2	=	6.48
22	1.37 X 0.90X2	=	2.46
23	0.30 X 0.70X2	=	0.42
24	5.23 X 2.64	=	13.80
25	2.69 X 1.03	=	2.77
26	2.89 X 2.38	=	6.75
27	1.54 X 3.05	=	4.69
DEDUCTIONS		=	137.48 SQ.M.

NET BUILT UP AREA
409.83 -137.48 = 272.35 SQ.M.

TOTAL BUP AREA = 272.35 SQ.M.

BUP AREA CALCULATION
5TH,8TH&11TH FL. AREA DIA. (WING - 'D')

37.19X11.02 = 409.83 SQ.M.

DEDUCTIONS :-

1	3.04 X 0.99	=	3.01
2	8.52 X 0.90	=	7.66
3	5.52 X 3.55	=	20.40
4	1.75 X 0.62	=	0.81
5	2.89 X 0.86	=	2.57
6	8.07 X 0.47	=	3.79
7	0.60 X 3.25	=	1.93
8	5.34 X 2.15	=	22.97
9	3.65 X 2.59	=	9.06
10	8.27 X 1.83	=	15.13
11	0.90 X 1.00	=	0.90
12	2.65 X 0.61	=	1.62
13	5.34 X 1.05	=	5.60
14	3.60 X 1.96	=	7.12
15	0.72 X 3.04	=	2.18
16	3.27 X 1.63	=	5.33
17	2.41 X 1.03	=	2.27
18	0.34 X 0.63	=	0.21
19	2.55 X 1.23	=	3.13
20	2.00 X 1.20	=	2.40
21	1.80 X 1.80X2	=	6.48
22	1.37 X 0.90X2	=	2.46
23	0.30 X 0.70X2	=	0.42
24	5.23 X 2.64	=	13.80
25	2.69 X 1.03	=	2.77
26	2.89 X 0.60	=	1.25
27	2.74 X 0.20	=	0.54
28	4.69 X 4.25	=	20.73
29	1.54 X 3.05	=	4.69
DEDUCTIONS		=	179.65 SQ.M.

NET BUILT UP AREA
409.83 -179.65 = 230.18 SQ.M.

TOTAL BUP AREA = 230.18 SQ.M.

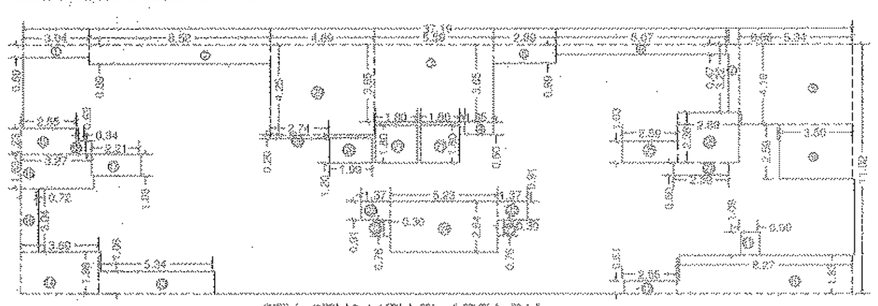

5TH ,8TH&11TH FL.AREA DIA.
SCALE 1 : 200 (WING -'D')

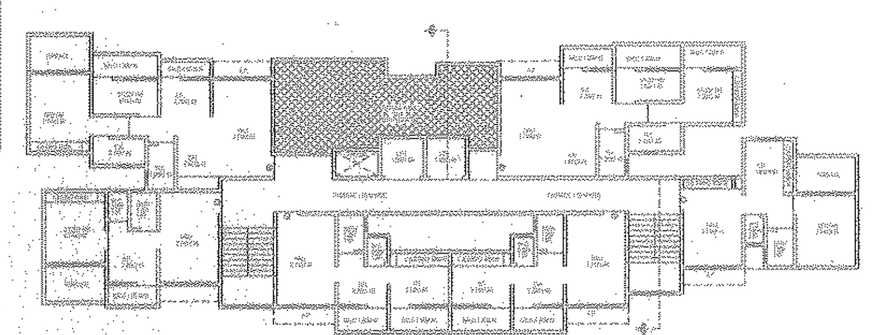

8TH FLOOR PLAN
SCALE=1:100 (WING -'D')

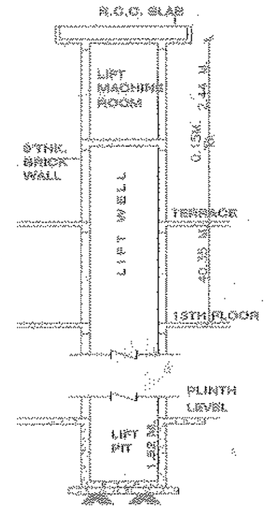

LIFT SECTION

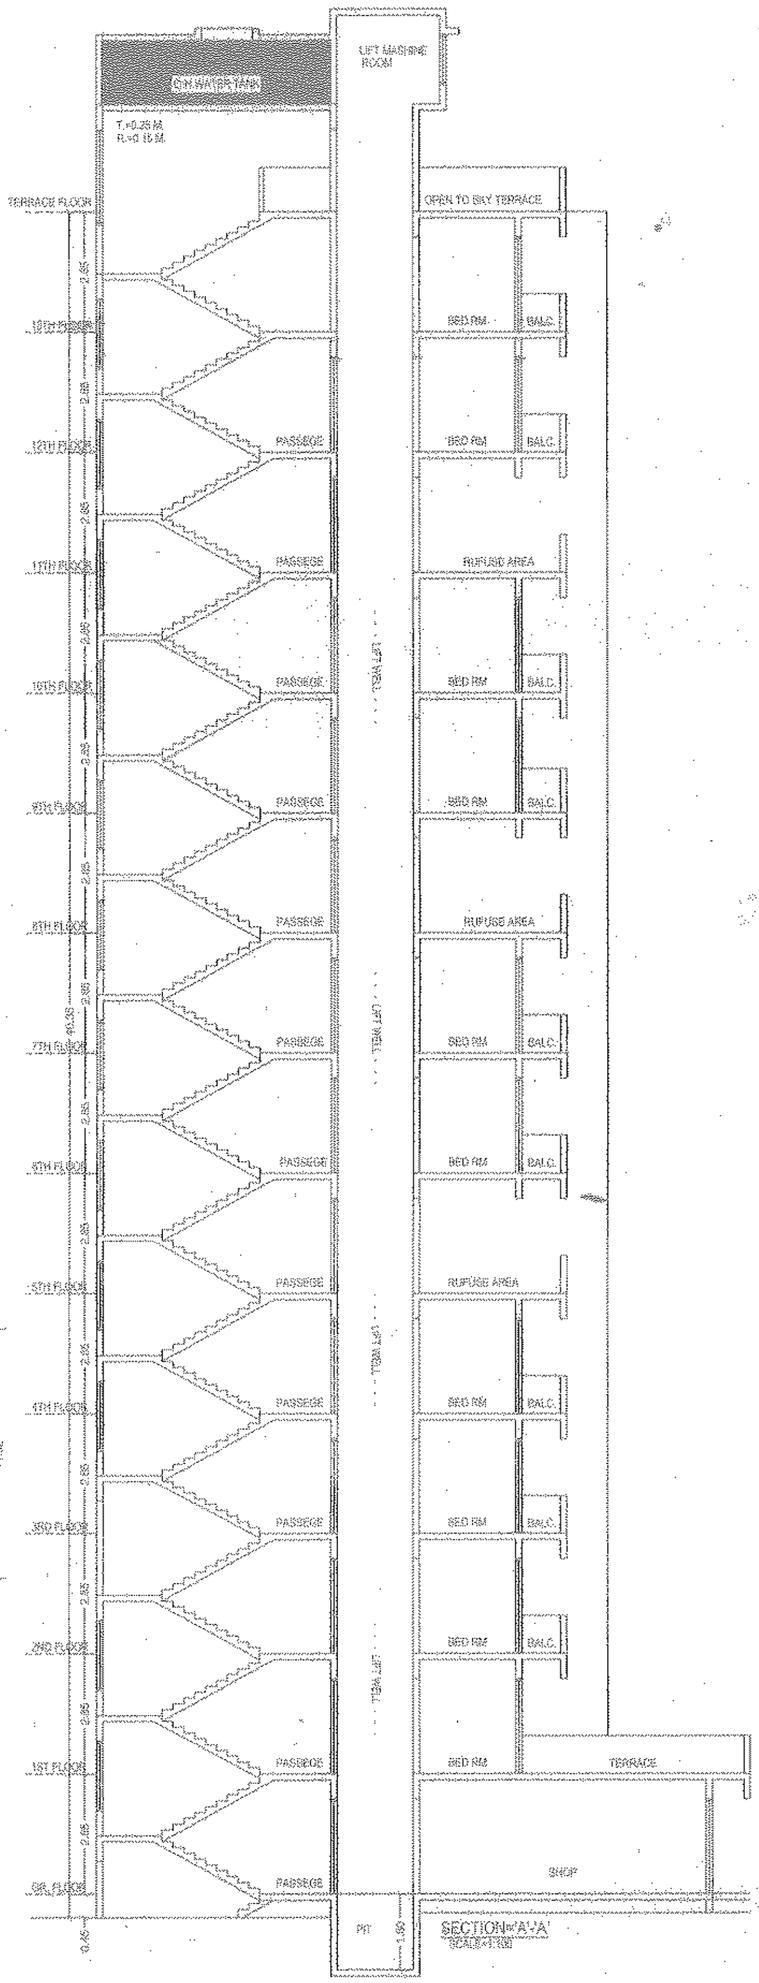

DESCRIPTION OF PROPOSAL & PROPERTY

PROPOSED BUILDING WING (A, B, C & D) ON LAND BEARING S.NO. 6, H. NO.2 AT MOUJE KATEMANIVLI TALUKA- KALYAN, DIST.- THANE

NAME OF OWNERS	SIGNATURE
1) SHRI. MANOJ R. Rai	

POWER OF ATTORNEY HOLDER	SIGNATURE
1) SHRI. MANOJ R. RAI	

JOB NO.	DRG NO.	SCALE	CHECKED BY	DRAWN BY
12 - 2009	/	1 : 100	D. T.	

SIGNATURE
DILIP TAMBDAY
DIP. ARCH. AIA,
C.A. NO. 7804/36

DILIP TAMBDAY & ASSO.
architect
2nd Floor, Subhamitra Chambers, Shivaji Path, Kalyan (W).

PRODUCED BY AN AUTODESK EDUCATIONAL PRODUCT