DEMARCATED RESIDENTIAL LAYOUT PLAN IN SURVEY NO. 101, IN MAUZA- SELOO, TAH. SELOO & DIST. WARDHA

SCALE : 1:500
LAYOUT PLAN

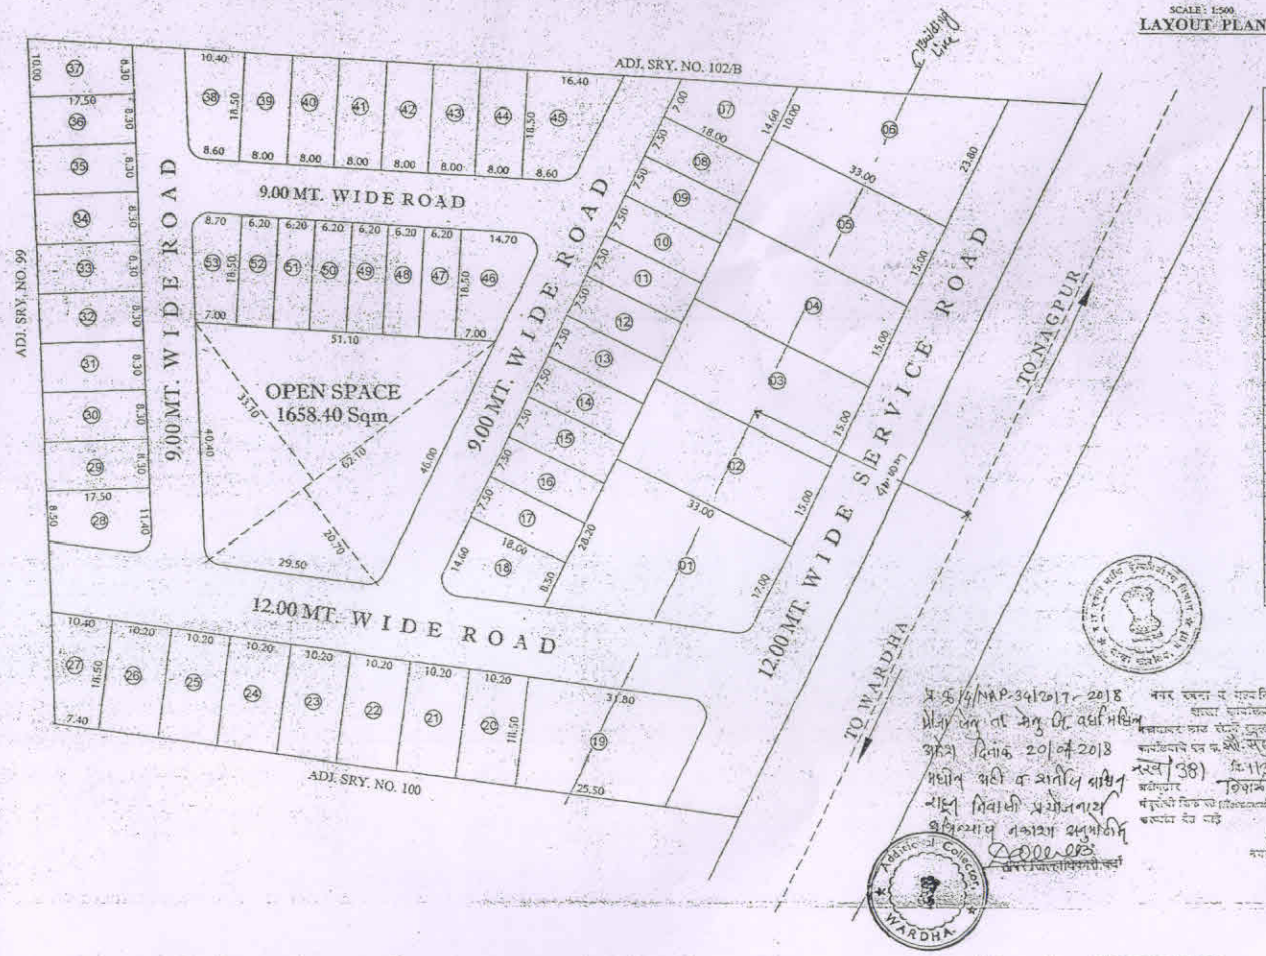

AREA STATEMENT	
AREA UNDER SRY. NO. 101	— 16500.00 Sq mtr.
AREA UNDER OPEN SPACE	— 1658.40 Sq mtr.
NET AREA UNDER PLOTS	— ~~10835.18~~ 10835.20 Sq mtr.
AREA UNDER ROADS	— ~~4006.42~~ 4006.20 Sq mtr.

PLOT INDEX

PLOT NO.	PLOT AREA IN SQ.MT.	CURVE AREA	NET PLOT AREA IN SQ.MT.	NO. OF PLOTS	TOTAL PLOT AREA
1	745.80	6.05	739.75	1	739.75
2 To 5	495.00		495.00	4	1980.00
6	557.70		557.70	1	557.70
7	194.40		194.40	1	194.40
8 To 17	135.00		135.00	10	1350.00
18	207.90	6.05	201.85	1	201.85
19	530.03	6.05	523.98	1	523.98
20 To 26	188.70		188.70	7	1320.90
27	164.65		164.65	1	164.65
28	174.13	6.05	168.08	1	168.08
29 To 36	145.25		145.25	8	1162.00
37	160.13		160.13	1	160.13
38	175.75	4.35	171.40	1	171.40
39 To 44	148.00		148.00	6	888.00
45	231.25	4.35	226.90	1	226.90
46	200.73	4.35	196.38	1	196.38
47 To 52	114.70		114.70	6	688.20
53	145.23	4.35	140.88	1	140.88
			TOTAL		~~10835.18~~ 10835.20

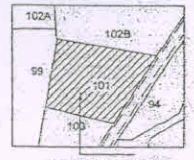

DEMARCATED SITE

Scale : 1:5000
LOCATION PLAN

प्र.क्र.14/NAP-34/2017-2018
प्रोजा लेखु ता. सेलु जि. वर्धा मधिल
अकेश दिनांक 20/04/2018
मधील अही व शर्तीस अधिन
राहून निवासी प्रयोजनार्थ
अभिन्यास नकाशा अनुमोदित
सहायक जिल्हाधिकारी, वर्धा

नगर रचना व मूल्य निर्धारण विभाग
शाखा कार्यालय वर्धा
नकाशाकार लाल रंगाने दुरुस्ती केल्या प्रमाणे या कार्यालयाचे पत्र क्र. सौ.सेलु/सं.कु.101/ रखा/381 दि. 11/3/2018 कलमे अंतर्गत विचारार्थ पारस्परिक मंजूरीची शिफारस (Recommended for Approval) करण्यात येत आहे
नगर रचनाकार
वर्धा

Additional Collector
WARDHA

SAI INFRATECH PARTNER OWNER	S.C.GHUDE Civil Engineer WARDHA Reg.No.TPW/029/26 ENGINEER