DEMARCATED RESIDENTIAL LAYOUT PLAN IN SURVEY NO. 209/2A -P, IN MAUZA- JAMB, TAH. SAMUDRAPUR & DIST. WARDHA

AREA STATEMENT

AREA UNDER LAND	---	14700.00	Sq mtr.
AREA UNDER OPEN SPACE	---	~~1486.00~~	Sq mtr. 1475.80
AREA UNDER AMMINITY	---	737.00	Sq mtr.
NET AREA UNDER PLOTS	---	~~9257.16~~	Sq mtr. 9252.82
AREA UNDER ROADS	---	~~3219.84~~	Sq mtr. 3234.38

PLOT INDEX

PLOT NO.	PLOT AREA IN SQ.MT.	CURVE AREA	NET PLOT AREA IN SQ.MT.	NO. OF PLOTS	TOTAL PLOT AREA
1	367.00	39.67	327.33	1	327.33
2 To 6	300.00		300.00	5	1500.00
7 To 8	320.00	19.35	300.65	2	601.30
9 To 10	300.00		300.00	2	600.00
11	301.60		301.60	1	301.60
12	137.03		137.03	1	137.03
13 To 18	105.00		105.00	6	630.00
19	138.45	6.05	132.40	1	132.40
20	150.00	6.05	143.95	1	143.95
21 To 29	125.25		125.25	9	1127.25
30	310.50	26.36	284.14	1	284.14
31	229.90	26.36	203.54	1	203.54
35	141.38		141.38	1	141.38
36 To 39	76.85		76.85	4	307.40
40	145.00	4.35	~~145.00~~ 140.65	1	~~145.00~~ 140.65
41	175.00	6.05	168.95	1	168.95
42 To 45	87.50		87.50	4	350.00
46	181.13		181.13	1	181.13
47	173.25		173.25	1	173.25
48 To 51	87.50		87.50	4	350.00
52	175.00	6.05	168.95	1	168.95
53	140.00	4.35	135.65	1	135.65
54 To 57	96.25		96.25	4	385.00
58	152.25		152.25	1	152.25
59	130.90		130.90	1	130.90
60	83.97		83.97	1	83.97
61	84.51		84.51	1	84.51
62	85.05		85.05	1	85.05
33	85.59		85.59	1	85.59
34	144.00	4.35	139.65	1	139.65
32	737.00		TOTAL		~~9257.16~~ 9252.82

N

SCALE : 1:500

LAYOUT PLAN

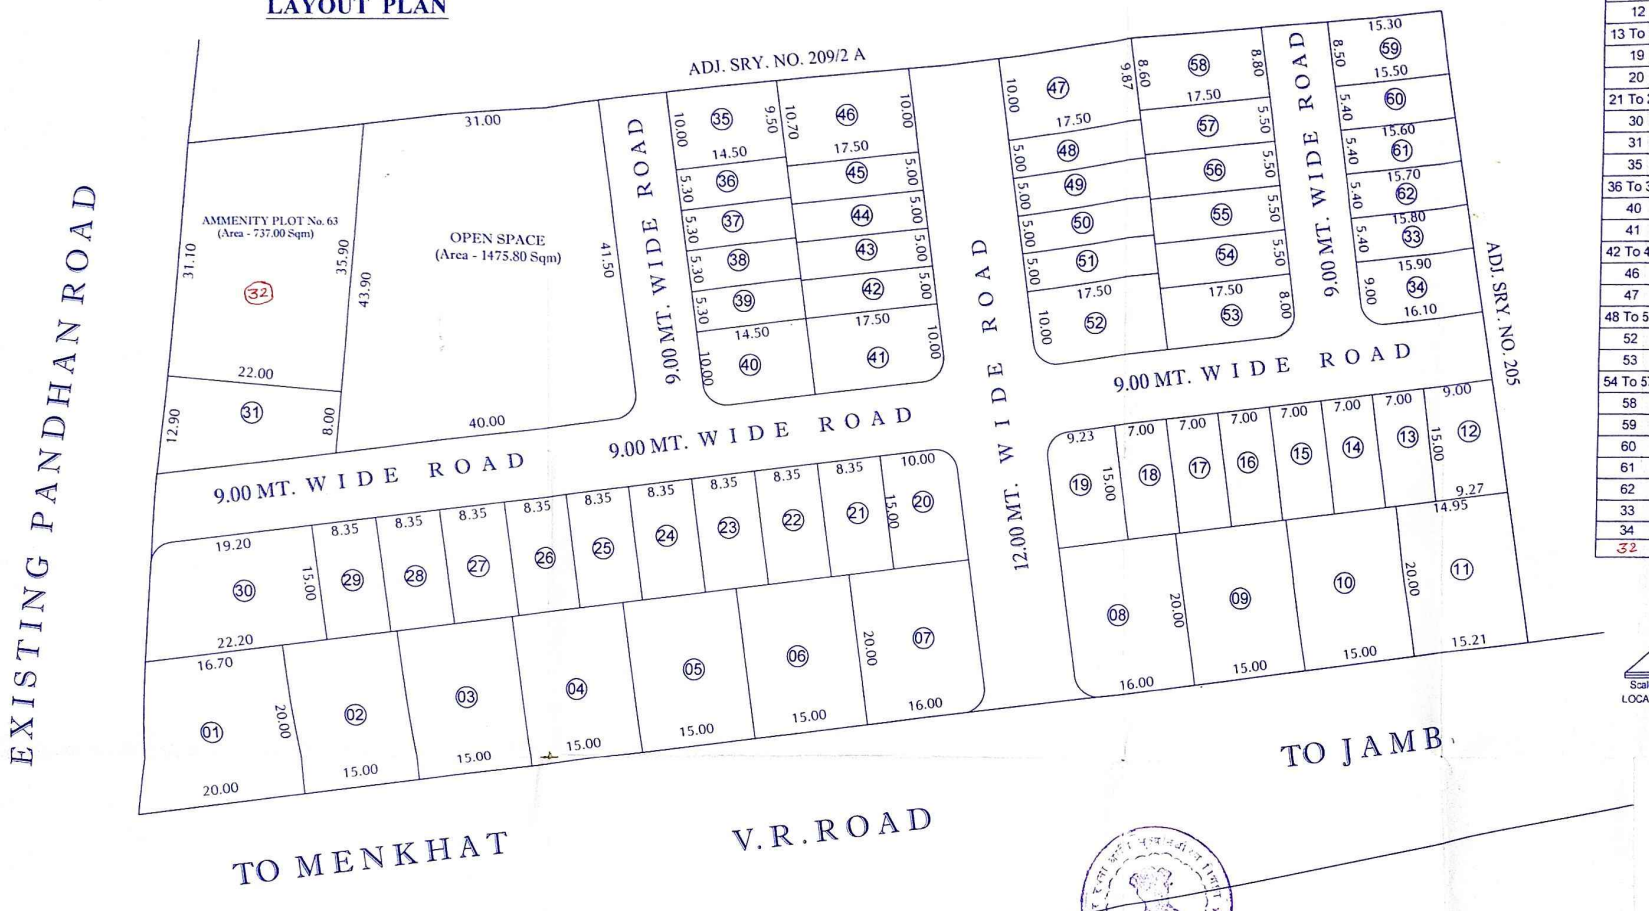



नगर रचना व मूल्य निर्धारण विभाग
शाखा कार्यालय वर्धा
नकाशावर लाल रंगाने दुरुस्ती केल्या प्रमाणे या कार्यालयाचे पत्र क्र. मौ. जांब / ब्र.नं. 209/2/अ/ 729/666 — दि. 04/04/2018 अन्वये
अधीनुसार निवासी वापरातरोता
मंजुरीची शिफारस (Recommended for Approval) करण्यात येत आहे

नगर रचनाकार
वर्धा

रा. मा. क्र. 70.../NAP - 34/2018 - 19 मौजा - जाम
ता. ~~हिंगणघाट~~ समुद्रपूर, जि. वर्धा मध्ये पारीत आदेश दि. 6/3/2019
मधिल अटी व शर्तीला अधीन राहुन निवासी/~~वाणिज्य~~ अकृष्ठ प्रयोजनासाठी अभिन्यास नकाशा अनुमोदित.

6/3/19
उपविभागीय अधिकारी
हिंगणघाट

B.T. Jambulkar सौ. अप्सरा बा जामुळकर	S.C.GHUDE Civil Engineer WARDHA. Reg.No.TPW/029/2016
OWNER	ENGINEER